

HUEY P. LONG DECORATIVE LIGHTING 2ND TO 5TH STREETS PROJECT
BKI PROJECT NO: 9344-8350-1
DATE: 4/6/2025

CONTRACT DOCUMENTS, SPECIFICATIONS
AND
CONTRACT DRAWINGS

FOR

HUEY P. LONG DECORATIVE LIGHTING 2ND
TO 5TH STREETS PROJECT

BKI PROJECT NO: 9344-8350-1

ADDENDUM NO. 2
DATE ISSUED: April 6, 2025

BID CLOSE DATE: APRIL 11, 2025 at 9:45 AM

BID LOCATION: Council Chambers, Gretna City Hall
740 2nd Street, Gretna, LA 70053

This addendum shall be part of the Contract Documents as provided in the Instruction to Bidders.

The following items are issued to add to, modify, and clarify the Contract Documents. These items shall have full force and effect as the Contract Documents, and the cost involved shall be included in the bid prices.

Acknowledge receipt of the addendum by inserting its number on the Bid Form of the Bid Documents. Failure to do so will subject the bidder to rejection.

This Addendum No. 1 consists of 61 pages including all attachments.

UPDATES:

1. Revised bid form is included in response to pre-bid meeting questions received.
2. DZS400BP spec is being issued for reference only. Lighting control cabinet was locked at time of pre-bid meeting. Engineer believes this time clock was installed.
3. Three (3) sets of record/as-built drawings are being provided for contractor's reference.

ATTACHMENTS:

1. Cover (1 sheet).
2. Table of Contents (1 sheet).
3. Pre-bid meeting agenda 04-04-25 (2 sheets)
4. Pre-bid meeting sign-in 04-04-25 (1 sheet)
5. Bid Form 04-06-25 (3 sheets)
6. DZS400BP spec (1 sheet)
7. Downtown Drainage Redlines (35 sheets)
8. Gretna Downtown Drainage Improvements Phase 2 As-builts Revised (7 sheets)
9. Gretna Downtown Drainage Improvements Phase 1-AS-BUILTS (10 sheets)

Huey P. Long Avenue Decorative Lighting 2nd 5th Streets Project

Pre-Bid Meeting Agenda

Friday, April 4, 2025, 1:00 pm, 2nd Street at Huey P. Long Avenue / Council Chambers - Gretna City Hall

BKI Project No.9344-8350-1

I. PROJECT GENERAL INFORMATION

The project includes the installation of underground electrical components and sidewalk paving for decorative lighting between 2nd and 5th Street along Huey P. Long Avenue

The construction duration is 90 calendar days.

II. SIGN-IN SHEET

This pre-bid conference is MANDATORY. However, please sign the official sign-in sheet before you leave at the conclusion of the meeting.

III. BIDDING PROCEDURES AND INFORMATION

Sealed Bids will be received by the City of Gretna, Gretna City Hall, 740 2nd Street, Gretna, LA, 70053, **no later than 9:45 am local time on Friday, April 11, 2025**. All bids received will be publicly opened at 10:00 am, in the council room at City Hall. The Owner reserves the right to reject any and all bids in accordance with the Public Bid Law, and to disregard all nonconforming, nonresponsive, unbalanced or conditional Bids.

The Bidding Documents (the Contract Documents, Specifications, and Drawings) are available for purchase at the office of the Engineer, Burk-Kleinpeter Inc., located at 2400 Veterans Memorial Blvd, Suite 310, Kenner, LA, 70062 or at publicpurchase.com. Phone No. 504-483-6271.

IV. PROJECT WORK HIGHLIGHTS

a. Underground Electrical Component Installation

Install electrical infrastructure only to power decorative lighting. Bases, poles and luminaires will be installed by city personnel.

b. Concrete Paving

Concrete paving of driveways and sidewalks.

V. BIDDER QUESTIONS

All questions are to be addressed in writing directly to the Project Manager and Project Engineer, Burk-Kleinpeter.

Contact info: David Boyd, PE (Project Manager), dboyd@bkusa.com
504-975-7735 or 504-463-6271

Perry Hogan, PE (Project Engineer), phogan@bkusa.com

VI. QUESTIONS

Question 1: Will as-built drawings be provided for the 1st-2nd Memorial Park project.

Response: Yes. Refer to Addendum #2.

Question 2: For street light foundations that do not have in-grade hand holes adjacent, what are contractors to do with the copper conductors that will be coiled up at each pole base?

Response: Contractor to install conductors in a properly sized junction box to capture raceway and conceal conductors. Contractor to provide 24" of conductor length per conductor. Conductors shall be terminated in junction box with insulated mechanical multi-tap connectors, 6061-T6 aluminum construction, set-screw, number of ports as required, black insulated, UL Listed, ILSCO PBTS series, POLARIS series, or approved equal.

VII. CONCLUDING REMARKS

Bidders are encouraged to visit the sites along Huey P. Long Avenue and familiarize themselves with existing conditions prior to bidding.

VIII. ADJOURN

Huey P. Long Decorative Lighting 2nd to 5th Streets
Mandatory Pre-Bid Meeting Attendance Record

March 21, 2025
BKI PROJECT NO. 9344-8350

NAME	COMPANY	EMAIL	PHONE
DAVE STOEHR	FRISCHHERTZ	DAVIDS@FRISCHHERTZ.COM	(504) 482-1146
KIRK Boudreaux	Hi-Tech Electric	Kboudreaux@hitechelectric.com	(504) 416-7435
Betsy Morgan	Gretna	bmorgan@gretnala.com	363-1566
PERRY HOGAN	BURK-KLEIN PETER INC.	phogan@bkiusa.com	504-486-5901

LOUISIANA UNIFORM PUBLIC WORK BID FORM

TO: City of Gretna
2nd St. and Huey P. Long Avenue
Gretna, LA 70053
(Owner to provide name and address of owner)

BID FOR: Huey P. Long Lighting 2nd-5th Streets
(Owner to provide name of project and other identifying information)

The undersigned bidder hereby declares and represents that she/he; a) has carefully examined and understands the Bidding Documents, b) has not received, relied on, or based his bid on any verbal instructions contrary to the Bidding Documents or any addenda, c) has personally inspected and is familiar with the project site, and hereby proposes to provide all labor, materials, tools, appliances and facilities as required to perform, in a workmanlike manner, all work and services for the construction and completion of the referenced project, all in strict accordance with the Bidding Documents prepared by: Burk Kleinpeter Inc., and dated: January 15, 2025.

(Owner to provide name of entity preparing bidding documents.)

Bidders must acknowledge all addenda. The Bidder acknowledges receipt of the following **ADDENDA:** (Enter the number the Designer has assigned to each of the addenda that the Bidder is acknowledging) _____.

TOTAL BASE BID: For all work required by the Bidding Documents (including any and all unit prices designated "Base Bid" * but not alternates) the sum of:

_____ Dollars (\$ _____)

ALTERNATES: For any and all work required by the Bidding Documents for Alternates including any and all unit prices designated as alternates in the unit price description.

Alternate No. 1 *(Owner to provide description of alternate and state whether add or deduct)* for the lump sum of:

_____ Dollars (\$ _____)

Alternate No. 2 *(Owner to provide description of alternate and state whether add or deduct)* for the lump sum of:

_____ Dollars (\$ _____)

Alternate No. 3 *(Owner to provide description of alternate and state whether add or deduct)* for the lump sum of:

_____ Dollars (\$ _____)

NAME OF BIDDER: _____

ADDRESS OF BIDDER: _____

LOUISIANA CONTRACTOR'S LICENSE NUMBER: _____

NAME OF AUTHORIZED SIGNATORY OF BIDDER: _____

TITLE OF AUTHORIZED SIGNATORY OF BIDDER: _____

SIGNATURE OF AUTHORIZED SIGNATORY OF BIDDER **: _____

DATE: _____

* The Unit Price Form shall be used if the contract includes unit prices. Otherwise it is not required and need not be included with the form. The number of unit prices that may be included is not limited and additional sheets may be included if needed.

** If someone other than a corporate officer signs for the Bidder/Contractor, a copy of a corporate resolution or other signature authorization shall be required for submission of bid. Failure to include a copy of the appropriate signature authorization, if required, may result in the rejection of the bid unless bidder has complied with La. R.S. 38:2212(B)5.

BID SECURITY in the form of a bid bond, certified check or cashier's check as prescribed by LA RS 38:2218.A is attached to and made a part of this bid.

LOUISIANA UNIFORM PUBLIC WORK BID FORM

UNIT PRICE FORM

TO: City of Gretna
2nd St. and Huey P. Long Avenue
Gretna, LA 70053

(Owner to provide name and address of owner)

BID FOR: Huey P. Long Lighting 2nd-5th Streets

(Owner to provide name of project and other identifying information)

UNIT PRICES: This form shall be used for any and all work required by the Bidding Documents and described as unit prices. Amounts shall be stated in figures and only in figures.

DESCRIPTION:	☒ Base Bid or ☐ Alt.# ____ MOBILIZATION AND DEMOBILIZATION			
REF. NO.	QUANTITY:	UNIT OF MEASURE:	UNIT PRICE	UNIT PRICE EXTENSION <i>(Quantity times Unit Price)</i>
1	1	LS		

DESCRIPTION:	☒ Base Bid or ☐ Alt.# ____ TRAFFIC CONTROL AND COORDINATION			
REF. NO.	QUANTITY:	UNIT OF MEASURE:	UNIT PRICE	UNIT PRICE EXTENSION <i>(Quantity times Unit Price)</i>
2	1	LS		

DESCRIPTION:	☒ Base Bid or ☐ Alt.# ____ PULL BOX			
REF. NO.	QUANTITY:	UNIT OF MEASURE:	UNIT PRICE	UNIT PRICE EXTENSION <i>(Quantity times Unit Price)</i>
3	1	LS		

DESCRIPTION:	☒ Base Bid or ☐ Alt.# ____ POLE FOUNDATION			
REF. NO.	QUANTITY:	UNIT OF MEASURE:	UNIT PRICE	UNIT PRICE EXTENSION <i>(Quantity times Unit Price)</i>
4	52	EACH		

DESCRIPTION:	☒ Base Bid or ☐ Alt.# ____ TRENCHING			
REF. NO.	QUANTITY:	UNIT OF MEASURE:	UNIT PRICE	UNIT PRICE EXTENSION <i>(Quantity times Unit Price)</i>
5	1	LS		

DESCRIPTION:	☒ Base Bid or ☐ Alt.# ____ RACEWAY			
REF. NO.	QUANTITY:	UNIT OF MEASURE:	UNIT PRICE	UNIT PRICE EXTENSION <i>(Quantity times Unit Price)</i>
6	1	LS		

DESCRIPTION:	☒ Base Bid or ☐ Alt.# ____ CONCRETE DEMOLITION			
REF. NO.	QUANTITY:	UNIT OF MEASURE:	UNIT PRICE	UNIT PRICE EXTENSION <i>(Quantity times Unit Price)</i>
7	1	LS		

DESCRIPTION:	☒ Base Bid or ☐ Alt.# ____ CONCRETE FLATWORK			
REF. NO.	QUANTITY:	UNIT OF MEASURE:	UNIT PRICE	UNIT PRICE EXTENSION <i>(Quantity times Unit Price)</i>
8	1	LS		

DESCRIPTION:	☒ Base Bid or ☐ Alt.# ____ DIRECTIONAL DRILL			
REF. NO.	QUANTITY:	UNIT OF MEASURE:	UNIT PRICE	UNIT PRICE EXTENSION (<i>Quantity times Unit Price</i>)
9	1	LS		

DESCRIPTION:	☒ Base Bid or ☐ Alt.# ____ SODDING			
REF. NO.	QUANTITY:	UNIT OF MEASURE:	UNIT PRICE	UNIT PRICE EXTENSION (<i>Quantity times Unit Price</i>)
10	1	LS		

DESCRIPTION:	☒ Base Bid or ☐ Alt.# ____ ELECTRICAL SERVICE AND DISTRIBUTION EQUIPMENT			
REF. NO.	QUANTITY:	UNIT OF MEASURE:	UNIT PRICE	UNIT PRICE EXTENSION (<i>Quantity times Unit Price</i>)
11	1	LS		

DESCRIPTION:	☒ Base Bid or ☐ Alt.# ____ CONDUCTORS, GROUNDING, ELECTRICAL CONNECTORS/TAPS			
REF. NO.	QUANTITY:	UNIT OF MEASURE:	UNIT PRICE	UNIT PRICE EXTENSION (<i>Quantity times Unit Price</i>)
12	1	LS		

DESCRIPTION:	☒ Base Bid or ☐ Alt.# ____ TEMPORARY JUNCTION BOX MOUNTED ON POLE FOUNDATIONS TO CONCEAL CONDUCTORS			
REF. NO.	QUANTITY:	UNIT OF MEASURE:	UNIT PRICE	UNIT PRICE EXTENSION (<i>Quantity times Unit Price</i>)
13	1	LS		

DESCRIPTION:	☒ Base Bid or ☐ Alt.# ____			
REF. NO.	QUANTITY:	UNIT OF MEASURE:	UNIT PRICE	UNIT PRICE EXTENSION (<i>Quantity times Unit Price</i>)
14				

DESCRIPTION:	☒ Base Bid or ☐ Alt.# ____			
REF. NO.	QUANTITY:	UNIT OF MEASURE:	UNIT PRICE	UNIT PRICE EXTENSION (<i>Quantity times Unit Price</i>)
15				

DESCRIPTION:	☒ Base Bid or ☐ Alt.# ____			
REF. NO.	QUANTITY:	UNIT OF MEASURE:	UNIT PRICE	UNIT PRICE EXTENSION (<i>Quantity times Unit Price</i>)
16				

Wording for “DESCRIPTION” is to be provided by the Owner.

All quantities are estimated. The contractor will be paid based upon actual quantities as verified by the Owner

SPECIFICATION SHEET

DZS SERIES 365/7 DAY ADVANCED LIGHTING CONTROLLER

APPLICATIONS

- HVAC equipment, horns and bells.
- Interior lighting, electric motors.
- Outdoor lighting and signs.

FEATURES

SCHEDULING:

99 ON & OFF set points allow individual programs for each day of the week at a minimum 1 minute apart.

SunSet ASTRONOMIC:

Adjusts daily to changes in sunset times. Adjustable 10° - 60° Northern or Southern latitudes can be individually offset +/- 1 to 240 minutes from both sunset and sunrise times.

SEASONS:

1 to 4 with different daily schedules which can wrap around into the new year.

HOLIDAYS:

1 to 24 individual dates.

SIGNAL/PULSE DURATION:

2 different settings per channel: 1-99 seconds.

DAYLIGHT SAVING:

Automatic adjustment (can be omitted).

LEAP YEAR:

Automatic Compensation.

MANUAL OVERRIDE:

Until the next regularly scheduled ON or OFF, automatic operation then resumes.

In signal mode, activates pulse.

CLOCK FORMAT:

AM/PM or 24 Hour Format.

POWER OUTAGE BACKUP:

Permanent schedule retention with memory module. Supercapacitor provides 7 days of real time backup.

MEMORY MODULE: Removable MM can be programmed at any one location and inserted into another DZS series unit.

COPY FEATURE:

Unit can be configured to copy program schedule to multiple memory modules.

OPTION:

Memory Module Programmer with software for computer connection programming. Also allows stand alone battery operation for portable copy feature.

SPECIFICATIONS

TIMING ACCURACY:

Line frequency.

INPUT VOLTAGE:

120/208-240/277VAC, 50/60Hz.

TERMINAL RANGE:

#14-#16AWG for line input. #12-#16AWG load outputs.

OPERATING TEMPERATURE:

-40 °F to +158 °F (-40 °C to 70 °C).

POWER CONSUMPTION:


6VA Max: DZS400BP.

ENCLOSURE: Noryl® Indoor/Outdoor NEMA 3R. 5" x 9 1/8" x 4 1/2". Suffix -0 metal Indoor/Outdoor NEMA 3 5 1/4" x 8 1/4" x 4 5/16". All with lockable hasp.

Project Info:	Type:
Job Ref:	Catalog Number:
Approvals:	Date:



WIRING DIAGRAM

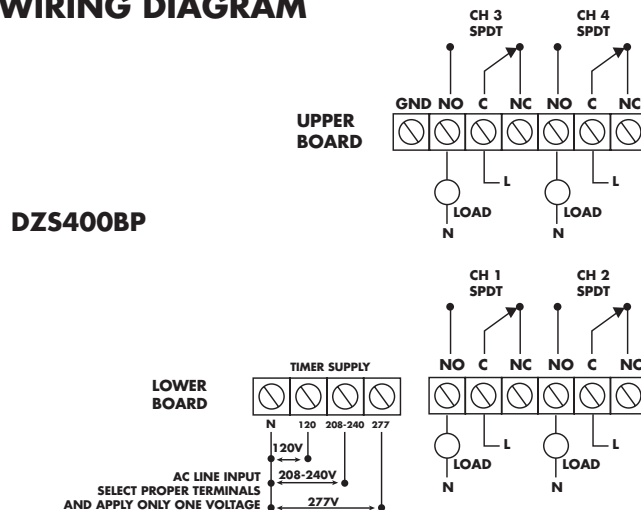

ORDERING INFO

CAT. NO.	UPC CODE	TIMER SUPPLY (VAC) 50/60Hz	NO. OF CHANNELS	DRY CONTACTS (UNPOWERED)
DZS400BP	82184	120/208-240/277	4	SPDT
USB-MMP	82196		Memory Module Programmer	Includes software

CONTACT RATINGS

TYPE	VOLTAGE (VAC)	RATING	
		NO	NC
General Purpose	24-277	20A	20A
Ballast	120-277	13A	-
Tungsten	120	8A	-
Motor Load	120/240	1/2HP	1/2 HP
Pilot Duty	120-277	720VA	360VA

**FOR THE
CITY OF GRETNNA, LOUISIANA**

BKI PROJECT 9344-8320
DECEMBER 2021



COUNCIL MEMBERS

DIRECTOR OF PUBLIC WORKS
DANNY LASYONE

CIVIL DRAWINGS

- ## GREEN INFRASTRUCTURE DRAWINGS

- TOTAL NUMBER OF SHEETS: 35



APPROVAL




LANDSCAPE ARCHITECT: Dana Brown & Associates, Inc. DATE

NEW ORLEANS, LA.

1. ALL ELEVATIONS SHOWN ON THE PLANS ARE BASED ON THE NORTH AMERICAN VERTICAL DATUM 1988 (NAVD88).
2. CONTRACTOR SHALL BE RESPONSIBLE TO VERIFY THE PROJECT TEMPORARY BENCHMARKS SHOWN ON THE PLANS WITH PERMANENT BENCHMARK INDICATED ON INDEX SHEET.
3. DIMENSIONS AND/OR ELEVATIONS MARKED THUS (N.T.S.) ARE NOT SHOWN TO SCALE.
4. DRAWINGS ARE GENERALLY TO SCALE, BUT SHOULD NOT BE SCALED. N.T.S. IS SHOWN ONLY WHERE DRAWING IS OBVIOUSLY OUT OF SCALE.
5. LOCATION OF EXISTING UTILITIES INDICATED ON THE PLAN SHEETS ARE SHOWN FOR INFORMATIONAL PURPOSES ONLY AND ARE BASED, IN PART, ON INFORMATION PROVIDED BY THE RESPECTIVE UTILITY COMPANIES. IT IS THE CONTRACTOR'S RESPONSIBILITY TO VERIFY ALL EXISTING UTILITY LOCATIONS PRIOR TO CONSTRUCTION, WHETHER OR NOT THEY ARE SHOWN ON THE PLANS.
6. THE CONTRACTOR IS RESPONSIBLE FOR ANY DAMAGE TO EXISTING UTILITIES, YARDS, OR STRUCTURES CAUSED BY CONSTRUCTION OPERATIONS. THE DAMAGE SHALL BE REPAIRED AT THE CONTRACTOR'S EXPENSE.
7. THE CONTRACTOR SHALL BE RESPONSIBLE FOR LAYING OUT THE WORK AND VERIFYING ALL MEASUREMENTS AND GRADES PRIOR TO BEGINNING OF CONSTRUCTION. IT SHALL BE THE RESPONSIBILITY OF THE CONTRACTOR TO ESTABLISH PROJECT CENTERLINE AND ADDITIONAL TEMPORARY BENCHMARKS FOR CONSTRUCTION PURPOSES BEFORE DESTROYING EXISTING MONUMENTS/NAILS/ CROSS CUTS, ETC.
8. NO SIGNS OR SIGNALS SHALL BE REMOVED WITHOUT THE ENGINEER'S APPROVAL. THE CONTRACTOR ACCEPTS ALL RESPONSIBILITIES DURING THE TIME OF REMOVAL. THE CONTRACTOR WILL NOTIFY THE CITY OF GRETTA PUBLIC WORKS DEPT. A MINIMUM OF THREE (3) WORKING DAYS IN ADVANCE OF WHEN CONTROLS ARE TO BE REMOVED AND REINSTALLED. ALL SIGNS, SIGNALS, AND MARKINGS REMOVED WILL BE IN PLACE AT THE TIME OF FINAL INSPECTION.
9. THE CONTRACTOR MUST VERIFY ELEVATIONS OF ALL EXISTING INVERTS THAT ARE A PART OF THIS JOB. DISCREPANCIES SHALL BE BROUGHT TO THE ATTENTION OF THE ENGINEER.
10. NOISE CONTROL - CONTRACTOR SHALL TAKE REASONABLE MEASURES TO AVOID UNNECESSARY NOISE APPROPRIATE FOR THE AMBIENT SOUND LEVELS IN THE AREA DURING WORKING HOURS. ALL CONSTRUCTION MACHINERY & VEHICLES SHALL BE EQUIPPED WITH PRACTICAL SOUND MUFFLING DEVICES, AND OPERATED IN A MANNER TO CAUSE THE LEAST NOISE.
11. DUST CONTROL - CONTRACTOR SHALL TAKE REASONABLE MEASURES TO PREVENT UNNECESSARY DUST. EACH SURFACE SUBJECT TO DUSTING SHALL BE KEPT MOIST WITH WATER OR BY APPLICATION OF CHEMICAL DUST SUPPRESSANT AS OFTEN AS REQUIRED TO MINIMIZE DUST. DUSTY MATERIALS IN PILES OR IN TRANSIT SHALL BE COVERED TO PREVENT BLOWING.
12. VIBRATION CONTROL - CONTRACTOR TO KEEP VIBRATIONS FROM CONSTRUCTION PROCESSES AND EQUIPMENT TO A MINIMUM.
13. CONTRACTOR IS TO NOTIFY RESIDENTS OR ADJACENT COMMERCIAL BUSINESSES OF CONSTRUCTION A MINIMUM OF ONE WEEK PRIOR TO START OF CONSTRUCTION.
14. CONTRACTOR SHALL VISIT THE SITE OF WORK AND COMPLETELY INFORM HIMSELF RELATIVE TO THE EXISTING CONDITIONS PRIOR TO THE START OF CONSTRUCTION.
15. CONTRACTOR SHALL GIVE 24-HOUR NOTICE TO THOSE AFFECTED PRIOR TO DISRUPTION OF WATER, SEWER OR OTHER SERVICE. UTILITY SHALL BE PROMPTLY REPAIRED.
16. ALL EXISTING MATERIALS OR EQUIPMENT AS INDICATED TO BE REMOVED ON PLANS, FROM THE CONSTRUCTION SITE, WILL BECOME CONTRACTORS PROPERTY. CONTRACTOR SHALL DISPOSE OF THE MATERIAL OR EQUIPMENT PROPERLY. CONTRACTOR SHALL DISPOSE OF THE MATERIAL OR EQUIPMENT IN A SAFE MANNER. CONTRACTOR SHALL SUBMIT A HAUL ROUTE TO THE ENGINEER FOR APPROVAL.
17. CONTRACTOR TO SEED AND FERTILIZE ALL DISTURBED NON-PAVED AREAS WITHIN THE PROJECT RIGHT-OF-WAY.
18. CONTRACTOR SHALL NOT REMOVE ANY TREES UNLESS CALLED TO BE REMOVED ON PLAN AND PROFILE SHEETS OR AS DIRECTED BY THE ENGINEER.
19. IN ACCORDANCE WITH SPECIFICATIONS, THE CONTRACTOR IS ENTIRELY RESPONSIBLE FOR PROTECTION OF HIS EXCAVATION AGAINST CAVING OR SETTLING OF THE BANKS AND FOR ALL DAMAGE TO PAVEMENTS, BUILDINGS, HOUSES, FENCES, AND OTHER PROPERTY CAUSED BY HIS EXCAVATION. CONTRACTOR SHALL PROTECT THE SIDES OF THE EXCAVATION BY AN INTERLOCKED SHEETING AND BRACING SYSTEM OR OTHER SHORING AS MAY BE NECESSARY. THE CONTRACTOR IS ALSO RESPONSIBLE FOR DEWATERING, CONTROL OF GROUNDWATER, AND MAINTENANCE OF EXISTING DRAINAGE CAPACITY VIA SUMPS, AND PUMPS AS REQUIRED. (NO DIRECT MEASUREMENT OR PAYMENT)
20. THE LINES AND GRADES SHOWN ON THE PLANS MAY BE VARIED SLIGHTLY BY THE ENGINEER IN THE FIELD IF CONDITIONS JUSTIFY SUCH A VARIATION. THE CONTRACTOR SHALL NOT BE ENTITLED TO AN EXTRA PAYMENT OTHER THAN WHATEVER INCREASE IN CONTRACT QUANTITIES IS INVOLVED.
21. RESERVED
22. RESERVED

- ## CONSTRUCTION SIGNING GENERAL NOTES

- THE DESIGN AND APPLICATION OF ALL SIGNALS, PAVEMENT MARKINGS, CHANNELIZING DEVICES, AND WARNING SIGNS SHALL CONFORM TO "THE LOUISIANA MANUAL ON UNIFORM TRAFFIC CONTROL DEVICES", LATEST EDITION.
2. CHANNELIZING AND DELINEATION DEVICES SHALL BE USED TO MARK ALL CONSTRUCTION AREAS. THESE SHALL BE TYPE III BARRICADES, AND BARRELS, AND FULLY REFLECTORIZED WITH LIGHTS.
3. ANY TRAFFIC CONTROL DEVICES (SIGNS, SIGNALS, MARKINGS) WHICH EXIST AS PART OF THE NORMAL PRE-CONSTRUCTION SCHEME, AND THAT DO NOT APPLY TO AN APPROPRIATE SITUATION, OR ARE IN THE WAY OF CONSTRUCTION, SHALL BE COVERED, REMOVED, OR RELOCATED BY THE CONTRACTOR UNDER THE SUPERVISION OF THE ENGINEER.
4. ANY TEMPORARY DEVICES NOT APPLYING TO AN APPROPRIATE SITUATION, OR THAT ARE NO LONGER REQUIRED, SHALL BE COVERED, REMOVED, OR OBLITERATED BY THE CONTRACTOR.
5. THE ROADWAY AND ALL TRAFFIC CONTROL DEVICES SHALL BE RESTORED TO ORIGINAL CONDITIONS BY THE CONTRACTOR.
6. ALL EXCAVATION SHALL BE COVERED, BACKFILLED, OR PROTECTED AS DIRECTED BY THE PROJECT ENGINEER, FULLY DELINEATED (SEE NOTE 2) AT NIGHT AND WHEN WORK IS NOT IN PROGRESS. EXCAVATED PITS, ETC. SHALL BE FULLY FENCED OR BARRICADED (SEE NOTE 2) TO PREVENT ACCESS BY PEDESTRIANS.
7. ALL MATERIALS/MACHINES SHALL BE STORED OUTSIDE OF THE RESIDENTIAL PROPERTY LINES AND THE ROAD SURFACE, CREATING NO SITE DISTANCE PROBLEMS, AND FULLY DELINEATED AS IN NOTE 2.
8. IF SECTIONS OF ROADWAY ARE TOTALLY CLOSED, THE CONTRACTOR SHALL NOTIFY THE CITY POLICE DEPARTMENT, 911 OPERATIONS, THE MAYOR'S OFFICE, THE FIRE DEPARTMENT, AND ANY MAJOR TRAFFIC GENERATORS (I.E. SCHOOLS, ETC.). A THREE WORKING DAY, MINIMUM, ADVANCE NOTICE WILL BE REQUIRED.
9. ON TOTALLY CLOSED SECTIONS OF THE ROADWAY, THE CONTRACTOR SHALL PROVIDE ACCESS FOR LOCAL TRAFFIC ONLY.
10. BARRELS USED FOR CHANNELIZING AND DELINEATION DEVICES AS PART OF THIS TRAFFIC CONTROL DEVICE PLAN SHALL BE WEIGHTED WITH SAND BAGS, FULLY REFLECTORIZED, WITH LIGHTS.
11. THE CONTRACTOR SHALL CHECK TRAFFIC CONTROL DEVICES ON A DAILY BASIS AS A MINIMUM WHEN BEGINNING AND ENDING THE WORK DAY, TO ENSURE ADHERENCE TO THE PLANS AND PROPER ADEQUACY OF DEVICES FOR DAY AND NIGHT VISIBILITY. ON WEEKENDS, DEVICES SHALL BE CHECKED A MINIMUM ONCE PER DAY.
12. ALL DEFICIENCIES NOTED BY THE ENGINEER REGARDING TRAFFIC CONTROL OR VEHICULAR OR PEDESTRIAN SAFETY ISSUES SHALL BE CORRECTED BY THE CONTRACTOR. THE CONTRACTOR SHALL NOTIFY THE ENGINEER IMMEDIATELY OF ANY SIGNIFICANT CHANGES TO THE TRAFFIC CONTROL DEVICES AND OPERATING CONDITIONS.
13. FLAGMAN AND/OR POLICE TRAFFIC CONTROL SHALL BE PROVIDED AS NEEDED AND SPECIFIED BY THE ENGINEER.
14. AT THE TIME OF CONSTRUCTION, ANY ADDITIONAL TRAFFIC CONTROL DEVICES WHICH MAY BE REQUIRED BY THE ENGINEER, THE CITY OF GRETNA DEPARTMENT OF PUBLIC WORKS, OR THE CONTRACTOR SHALL BE PROVIDED BY CONTRACTOR AT NO DIRECT PAY.
15. YELLOW, HIGH VISIBILITY PENNANT BARRIER FLAGGING (NYLON ROPE WITH PLASTIC PENNANTS) SHALL NOT BE STRUNG BETWEEN TYPE II BARRICADES AND BARRELS/DRUMS UNLESS DIRECTED BY THE ENGINEER.
16. CONTRACTOR SHALL PROVIDE FOR THE MOVEMENT OF PEDESTRIANS FOR THE ENTIRE LENGTH OF THE CONTRACT. AS MUCH AS POSSIBLE, THE CONTRACTOR SHALL NOT OBSTRUCT EXISTING SIDEWALKS, THEREBY OBSTRUCTING PEDESTRIAN MOVEMENTS. IF EXISTING SIDEWALKS MUST BE OBSTRUCTED, THE CONTRACTOR SHALL PROVIDE FOR THE MOVEMENT OF PEDESTRIANS BY POSTING APPROPRIATE SIGNING, SUCH AS: SIDEWALK CLOSER USE OTHER SIDE OF STREET. SIGNING SHALL BE REFLECTORIZED AND LIGHTED AT NIGHT. ALSO, WHERE TRENCHES ARE EXCAVATED OUTSIDE THE ROADWAY SURFACE, THE CONTRACTOR SHALL PROVIDE EACH DWELLING AT LEAST ONE ACCESSIBLE CROSSING OF THE BACKFILLED TRENCH AREA, FOR USE BY PEDESTRIANS.
17. AT ALL TIMES THE CONTRACTOR SHALL PROVIDE ACCESS TO AREA BUSINESSES. DRIVEWAY WORK (INCLUDING CURBING) SHALL BE COORDINATED SO THAT AT LEAST ONE LANE OF ACCESS IS PROVIDED AT ALL TIMES.
18. CONTRACTOR IS REQUIRED TO SUBMIT A TRAFFIC CONTROL/DETOUR PLAN PREPARED BY A LICENSED PE FOR CITY APPROVAL PRIOR TO CONSTRUCTION.
19. CONTRACTOR MUST USE BEST MANAGEMENT PRACTICES TO ENSURE RUNOFF FROM CONSTRUCTION SITE TO MEET GRETNA'S MS4 PERMIT - STORMWATER MANAGEMENT PROGRAM.

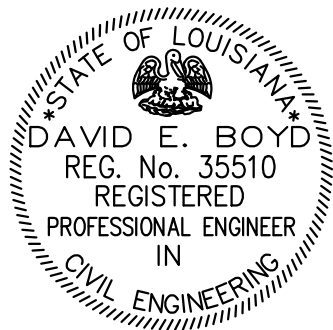

GENERAL NOTES

1. THE CONTRACTOR IS ADVISED THAT HE MUST COMPLY WITH ALL SPECIAL PROVISIONS AND TECHNICAL SPECIFICATIONS AS STATED IN THE PROJECT CONSTRUCTION SPECIFICATIONS AND CONTRACT DOCUMENTS.
2. THE CONTRACTOR SHALL BE RESPONSIBLE FOR MAINTAINING TEMPORARY DRAINAGE WITHIN THE PROJECT AREA DURING CONSTRUCTION AND SHALL NOT RESTRICT DRAINAGE FLOW OR IMPEDE DRAINAGE DURING RAIN EVENTS (NO DIRECT PAY).
3. THE CONTRACTOR SHALL PROVIDE A PROPOSED HAUL ROUTE FOR ALL EQUIPMENT OR MATERIALS HAULED TO OR FROM THE CONSTRUCTION SITE PRIOR TO THE START OF CONSTRUCTION. THE ROUTE MUST BE APPROVED BY THE PARISH TRAFFIC ENGINEERING DIVISION PRIOR TO THE START OF CONSTRUCTION. ALL DUMP TRUCKS SHALL BE COVERED TO PREVENT MATERIAL FROM FALLING ON ROADWAY.

UTILITIES


1. THE JOINING OF NEW AND EXISTING DRAINAGE PIPES SHALL BE IN ACCORDANCE WITH THE LOUISIANA STANDARD SPECIFICATIONS FOR ROADS AND BRIDGES 2016 EDITION SECTION 701.
2. LOUISIANA 1–CALL MUST BE CONTACTED PRIOR TO THE START OF ANY CONSTRUCTION ACTIVITY.

TRAFFIC CONTROL

1. ALL WORK PERFORMED UNDER THIS SECTION SHALL BE PAID FOR UNDER ITEM NO. 713 TEMPORARY SIGNS AND BARRICADES UNLESS SPECIFICALLY NOTED.
2. NO LESS THAN FIFTEEN (15) WORKING DAYS PRIOR TO THE COMMENCEMENT OF CONSTRUCTION, THE CONTRACTOR SHALL SUBMIT A DETAILED TEMPORARY TRAFFIC CONTROL PLAN, TO BE PAID UNDER THE TEMPORARY SIGNS AND BARRICADES ITEM, TO THE CITY ENGINEER FOR REVIEW AND APPROVAL. THE PLAN WILL INCLUDE A COMPLETE CONSTRUCTION SIGNAGE, TRAFFIC MAINTENANCE AND PUBLIC SAFETY PLAN, WHICH AT A MINIMUM INCLUDES THE FOLLOWING:
 - a. A SIGN INVENTORY A LIST OF ALL EXISTING TRAFFIC CONTROL DEVICES (SIGNS, RAISED PAVEMENT MARKINGS, ETC.) ACCURATELY LOCATED ON THE PLANS.
 - b. A PLAN FOR THE PROPOSED ROUTE ON WHICH CONSTRUCTION MATERIAL AND EQUIPMENT ARE TO BE TRANSPORTED TO OR FROM THE CONSTRUCTION SITE.
 - c. A DETOUR PLAN SHOWING PROPOSED ROUTES FOR LOCAL AND TRANSIENT TRAFFIC ON WHICH LOCATIONS OF DETOUR TRAFFIC CONTROL DEVICES AND CONSTRUCTION ZONE OR WORK ZONE TRAFFIC CONTROL DEVICES ARE SHOWN. TRAFFIC CONTROL DEVICE APPLICATIONS AND METHODS SHALL BE IN COMPLIANCE WITH PART VI OF THE MANUAL ON UNIFORM TRAFFIC CONTROL DEVICES (LATEST EDITION) UNLESS OTHERWISE DIRECTED IN THE FIELD BY JEFFERSON PARISH TRAFFIC ENGINEERING.
 - d. THE CONTRACTOR SHALL PROVIDE WEEKLY PROGRESS UPDATES TO THE OWNER. THIS INCLUDES, BUT IS NOT LIMITED TO, CURRENT AND PROJECTED ROAD CLOSURES, ALTERNATE ROUTES, IMPLEMENTED DETOUR ROUTES, ESTIMATED DURATION OF ROAD CLOSURES AND PROGRESS OF CONSTRUCTION FOR ALL CONSTRUCTION LOCATIONS. THE CONTRACTOR SHALL BE RESPONSIBLE FOR PROVIDING ACCURATE SCHEDULES THAT SHOW ANTICIPATED ROAD CLOSURES, ROAD CONSTRUCTION BEGINNING AND ENDING DATES AND ANY RESULTING DETOUR LOCATIONS AND DATES TO THE PROJECT ENGINEER AND THE OWNER. THIS INFORMATION WILL BE UPLOADED TO THE OWNER’S WEBSITE TO INFORM RESIDENTS OF CONSTRUCTION ACTIVITIES. THESE SCHEDULES SHALL BE ACCURATE AND UPDATED AS REQUIRED IF ANTICIPATED DATES CHANGE DUE TO WEATHER, DELAYS, ETC. CONTRACTOR SHALL SUBMIT ROAD CLOSURE FORMS FOR APPROVAL NO LESS THAN FIFTEEN (15) WORKING DAYS PRIOR TO CLOSING ANY ROADWAY
3. THE CONSTRUCTION TRAFFIC CONTROL SIGNS, BARRICADES, WARNING LIGHTS, DEVICES, AND METHODS SHALL ADHERE TO PART VI OF THE MANUAL ON UNIFORM TRAFFIC CONTROL DEVICES (MUTCD) LATEST EDITION, AS REVISED, UNLESS OTHERWISE NOTED IN THE FIELD BY THE CITY ENGINEER.
4. ANY DAMAGE TO EXISTING TRAFFIC DEVICES CAUSED BY THE CONTRACTOR’S WORK SHALL BE IMMEDIATELY REPORTED BY THE CONTRACTOR TO THE CITY ENGINEER. REPAIRS SHALL BE PERFORMED BY THE CONTRACTOR.
5. PAVEMENT MARKINGS, STRIPING, AND TRAFFIC CONTROL DEVICES SHALL CONFORM AND BE INSTALLED AS SHOWN ON THE STRIPING PLANS OR AS DIRECTED BY THE CITY ENGINEER. ALL INSTALLATIONS SHALL BE AS PER THE MANUAL ON UNIFORM TRAFFIC CONTROL DEVICES (MUTCD), (LATEST EDITION) AS REVISED. (THERE SHALL BE NO DIRECT PAYMENT FOR REMOVAL OF EXISTING MARKINGS.)
6. FOR WORK LOCATED ALONG STATE AND FEDERAL HIGHWAY RIGHTS–OF–WAY, PRIOR TO START OF CONSTRUCTION, THE CONTRACTOR SHALL SUBMIT TO THE LA DOTD FOR REVIEW AND APPROVAL A UTILITY PERMIT APPLICATION INCLUDING BUT NOT LIMITED TO A TRAFFIC CONTROL PLAN. CONTACT DOTD FOR A LISTING OF STATE AND FEDERAL HIGHWAYS.
7. IF BOTH ROADWAY LANES ARE TO BE REPLACED, ONE LANE OF TRAFFIC MUST BE OPEN AT ALL TIMES UNLESS APPROVED BY THE OWNER IN WRITING.

ROADWAYS

1. CONCRETE PANELS SHALL BE REMOVED AND REPLACED FROM JOINT TO JOINT (WHETHER FOR ROADWAYS, DRIVEWAYS OR SIDEWALKS). THE CONTRACTOR SHALL SAWCUT TO PRESERVE THE INTEGRITY OF THE JOINT. SAWCUTTING SHALL BE STRAIGHT AND FULL DEPTH AT NO DIRECT PAY UNLESS OTHERWISE STATED IN THE CONTRACT SPECIFICATIONS
2. CONTRACTOR SHALL EXERCISE CAUTION WHEN REMOVING CONCRETE OR ASPHALT PAVEMENT ADJACENT TO PAVEMENT THAT IS TO REMAIN (WHETHER FOR ROADWAYS, DRIVEWAYS OR SIDEWALKS). ANY DAMAGE TO THE ADJACENT PAVEMENT SHALL BE REPAIRED BY THE CONTRACTOR TO THE SATISFACTION OF JEFFERSON PARISH AT THE CONTRACTOR’S EXPENSE. THIS MAY INCLUDE MILL/OVERLAY, PATCHING OR FULL REPLACEMENT OF DAMAGED AREAS.
3. CONTRACTOR SHALL CONSTRUCT THE NEW PAVEMENT TO MATCH THE ADJACENT PAVEMENT ELEVATIONS AND ENSURE THAT THE EDGE OF THE PAVEMENT PROFILE IS SMOOTH IN ACCORDANCE WITH THE LOUISIANA STANDARD SPECIFICATIONS FOR ROADS AND BRIDGES LATEST EDITION. A STRAIGHT EDGE SHALL BE USED IN LIEU OF A PROFILOGRAPH.
4. WHEN WIDENING EXISTING PAVEMENT, THE CONTRACTOR SHALL SET THE ROADWAY CROSS SLOPE AND GUTTER PROFILE TO ENSURE POSITIVE DRAINAGE.

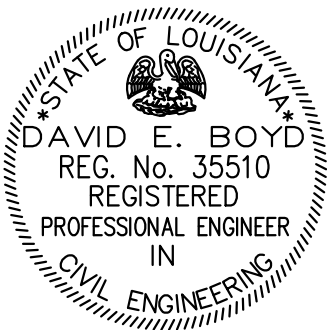

BKI

BURK-KLEINPETER, INC.

ENGINEERS, ARCHITECTS, PLANNERS, ENVIRONMENTAL SCIENTISTS

10115-5994


PHONE (504)486-5901 • FAX (504)486-1714

BKI JOB #


– 9344–8320

BASE BID


DESIGNED	R.P.	
CHECKED	D.B.	
DETAILED	S.G.	
CHECKED	D.B.	
DATE	DEC., 2021	
SHEET	2 of 2	
	BY	
	REVISION DESCRIPTION	
NO.	DATE	

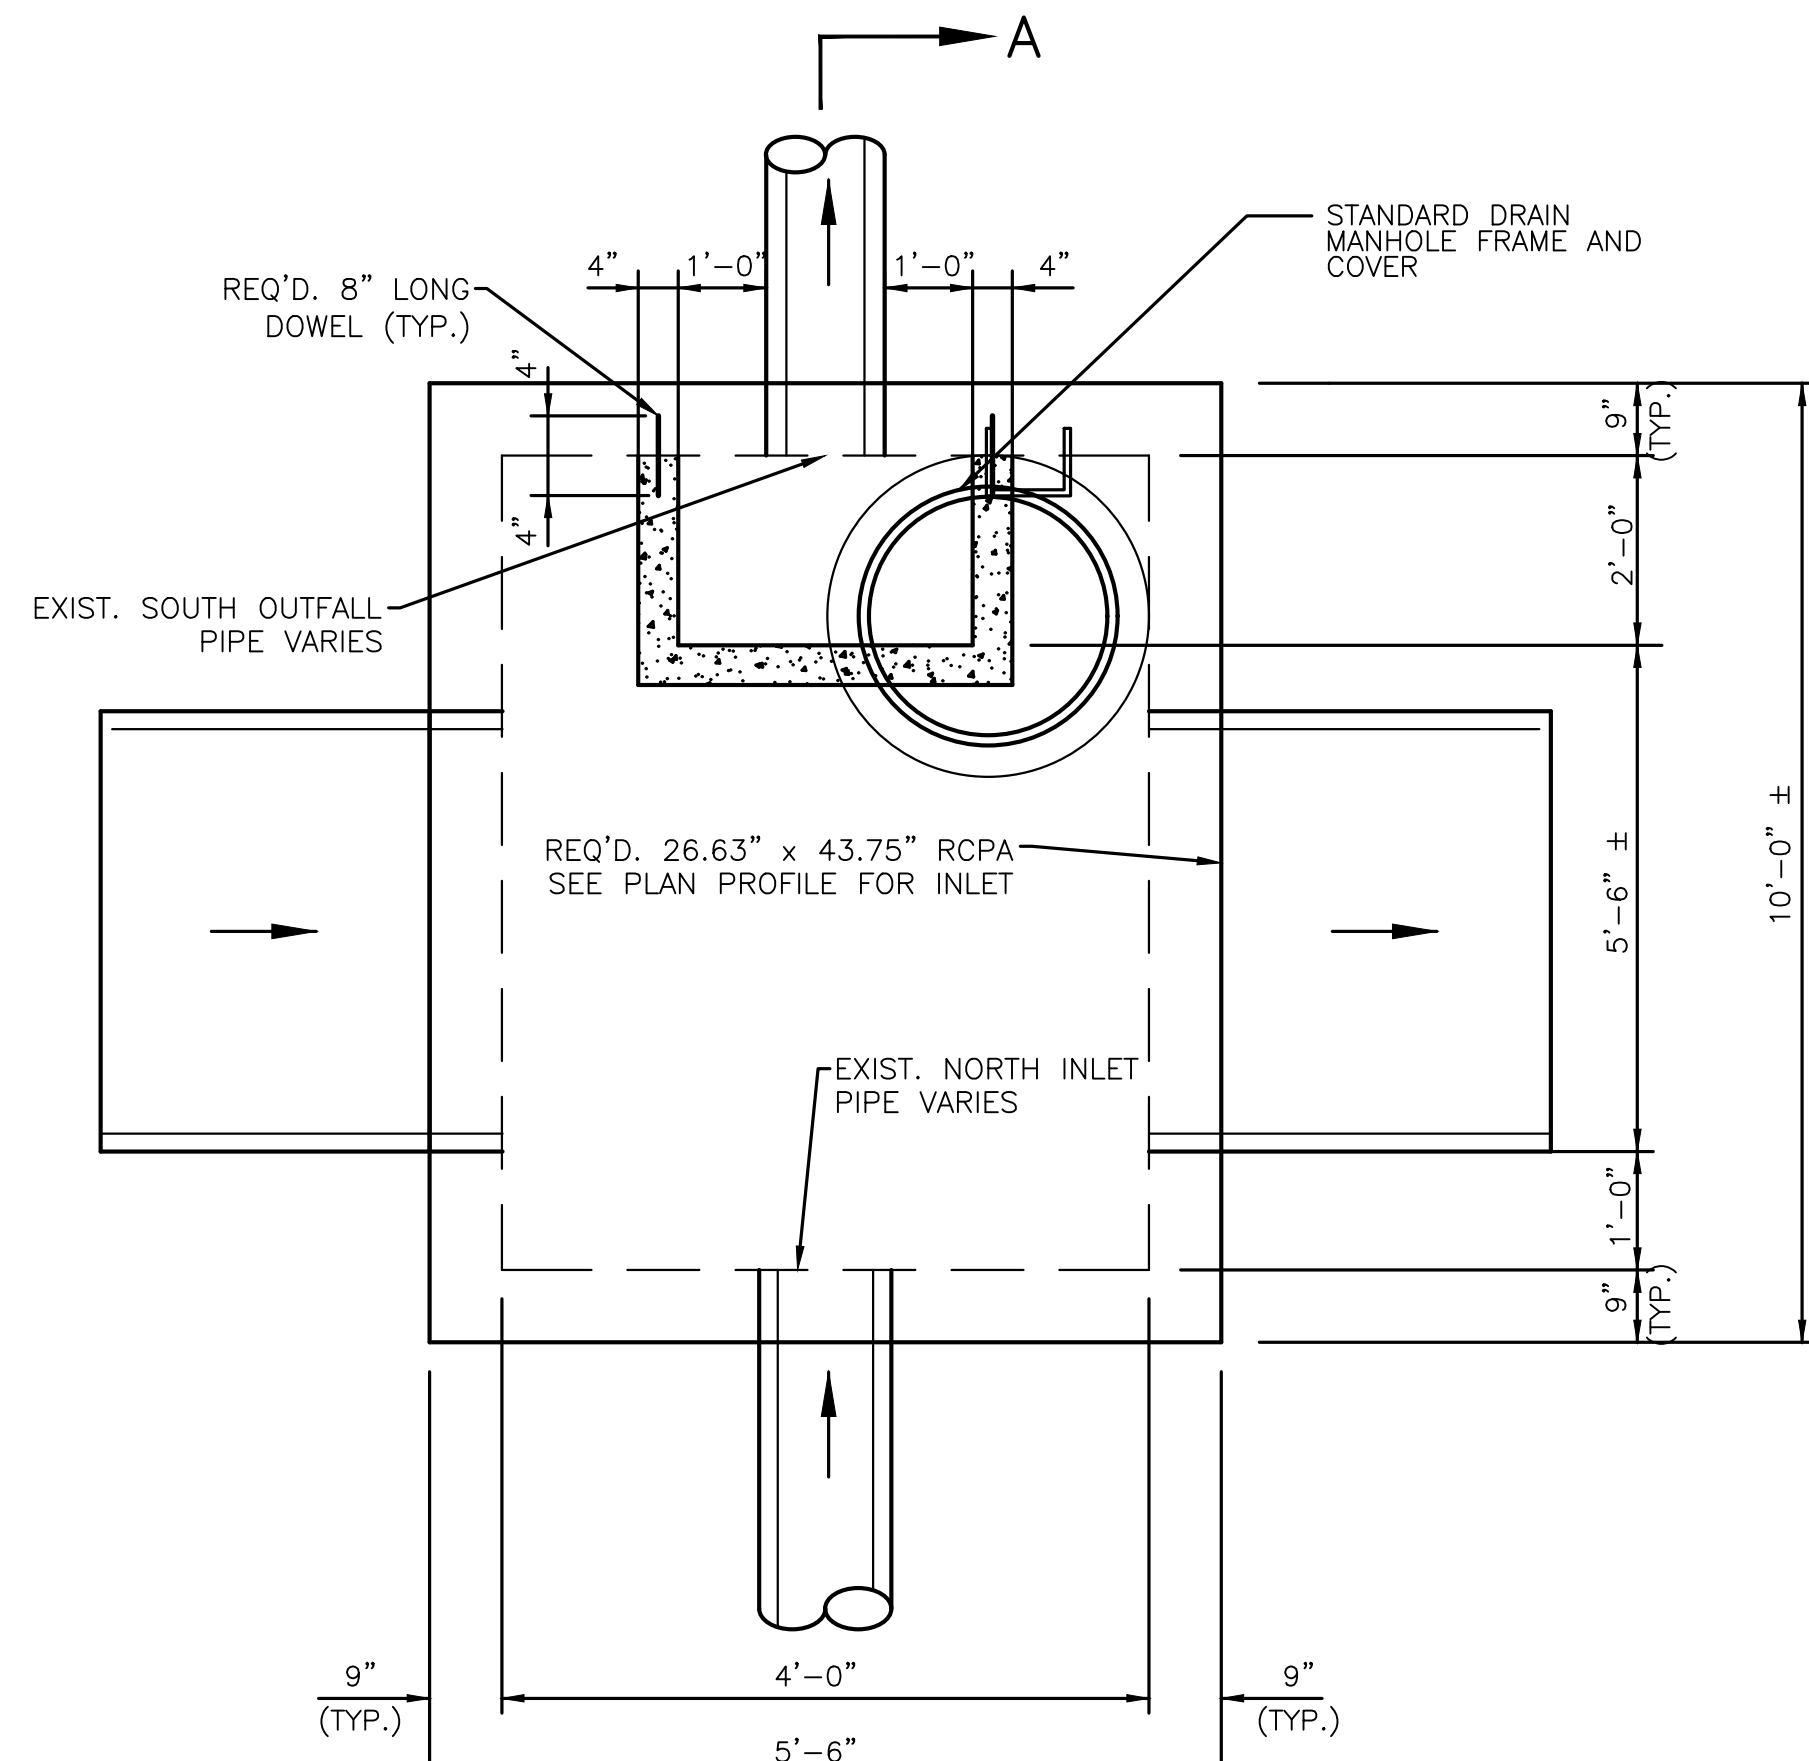


PLAN OF SPECIAL MANHOLE
N.T.S.

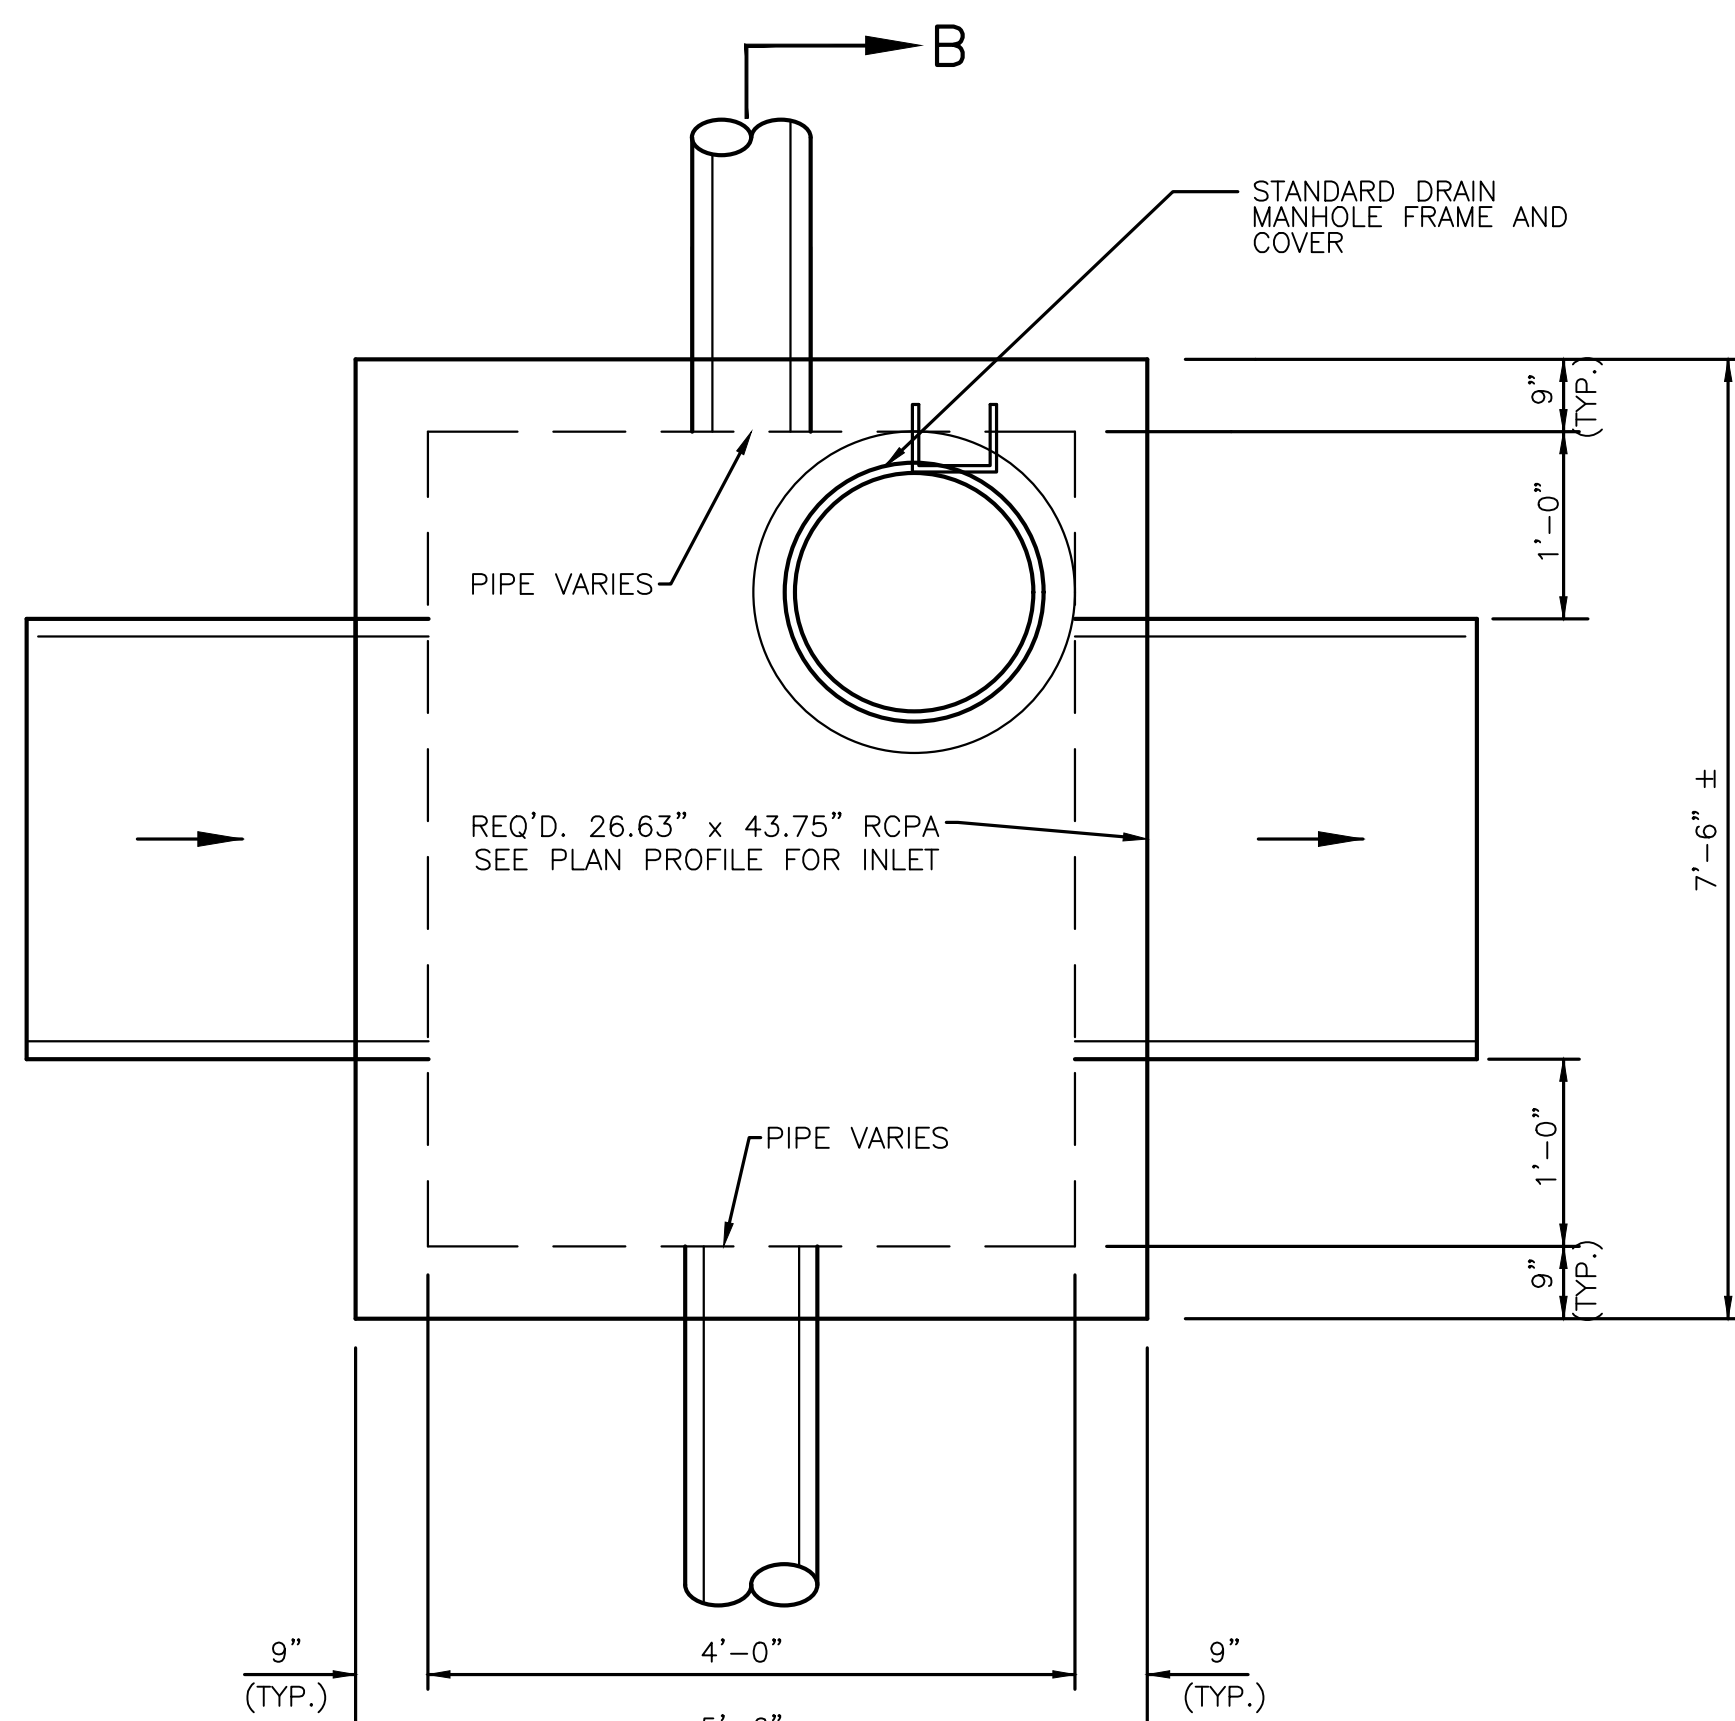


PLAN OF DRAIN ARCH PIPE MANHOLE
N.T.S.

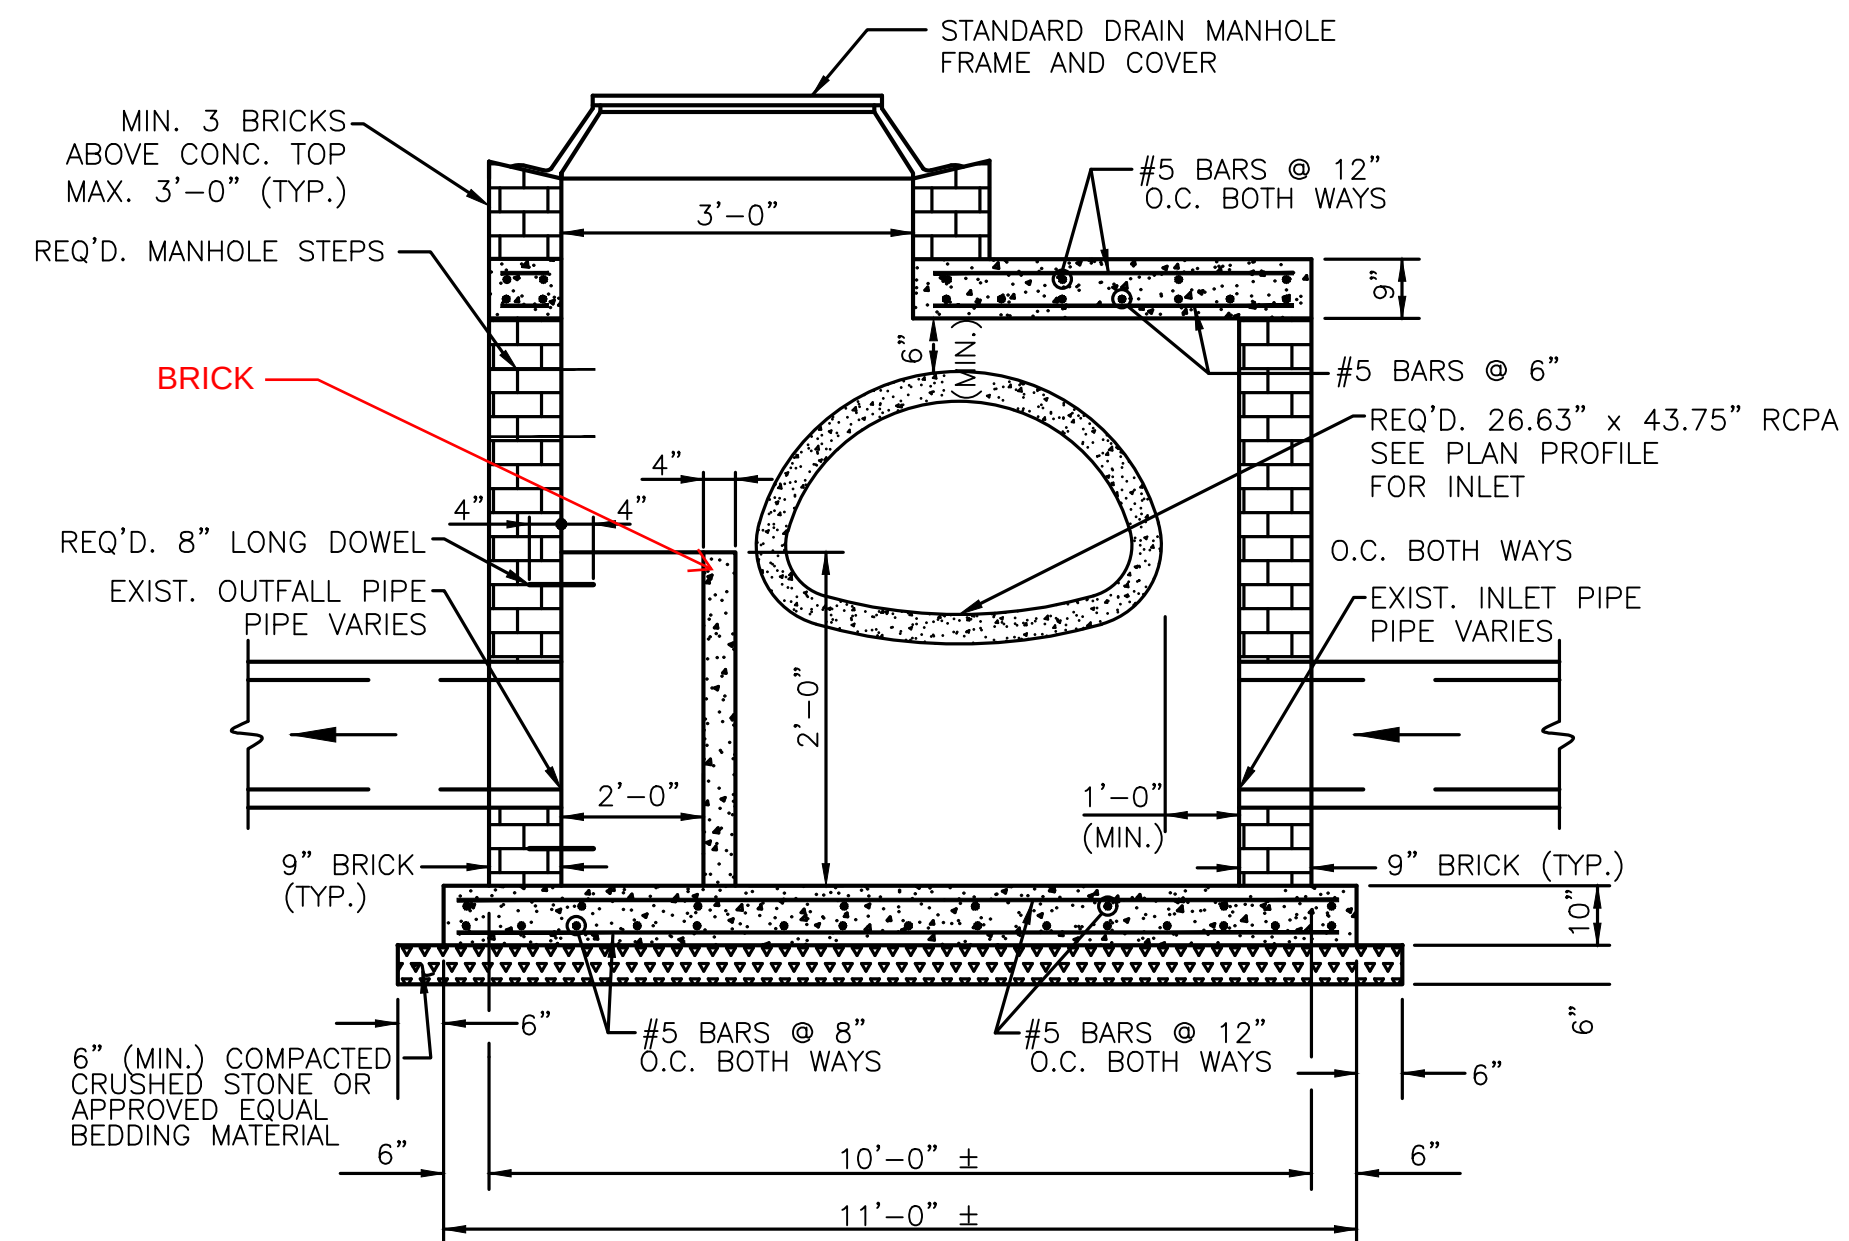


SECTION "A"—"A"
N.T.S.

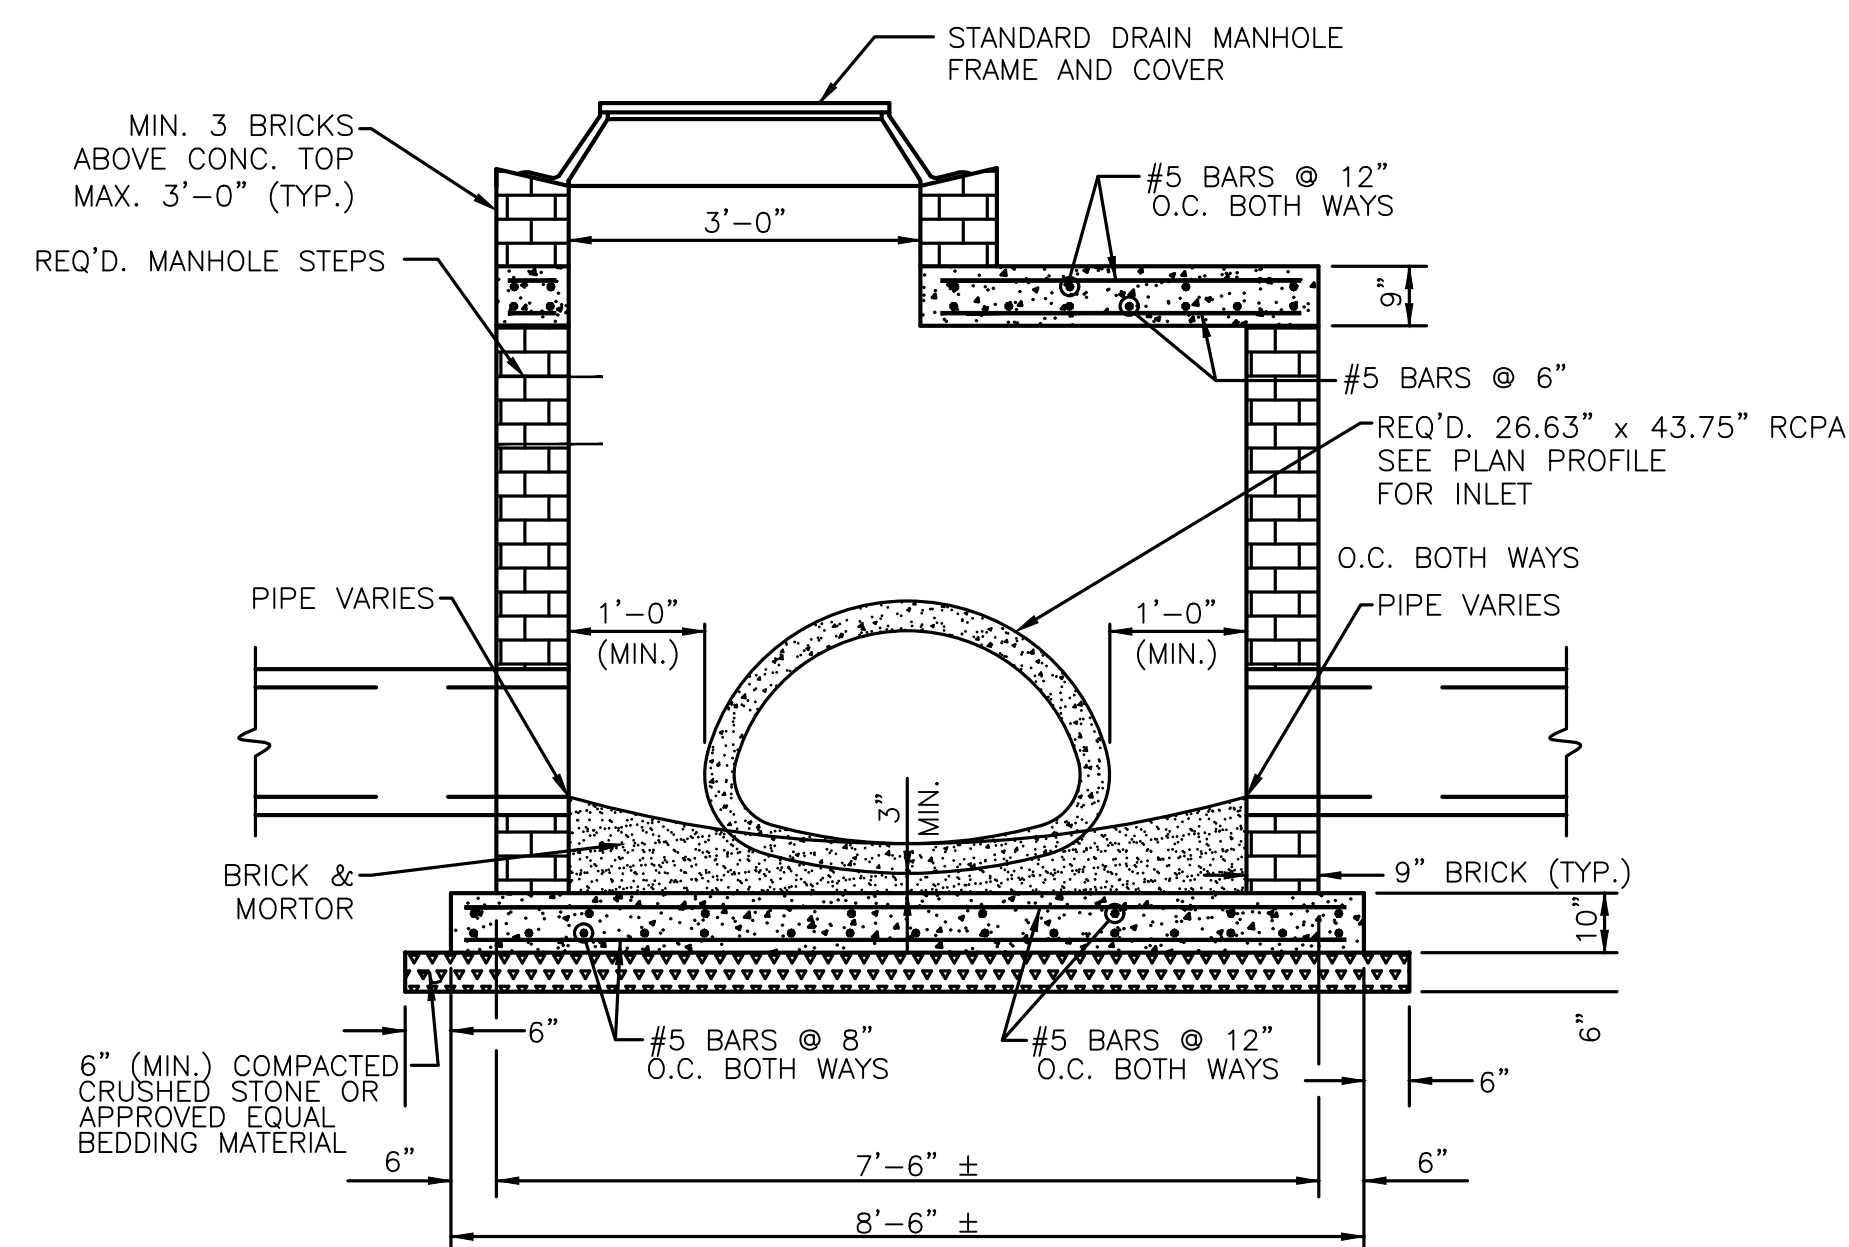


SECTION "B" – "B"
N.T.S.

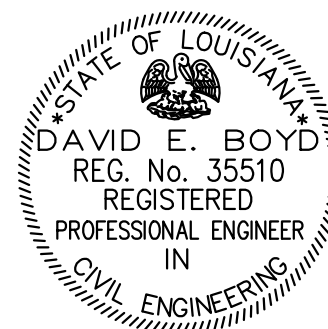

FILE NAME: C:\USERS\SGALATAS\DESKTOP\NO.16.010_ARCHIVE_COPY_DRAWINGS\C3B-SPECIAL DETAILS.DWG

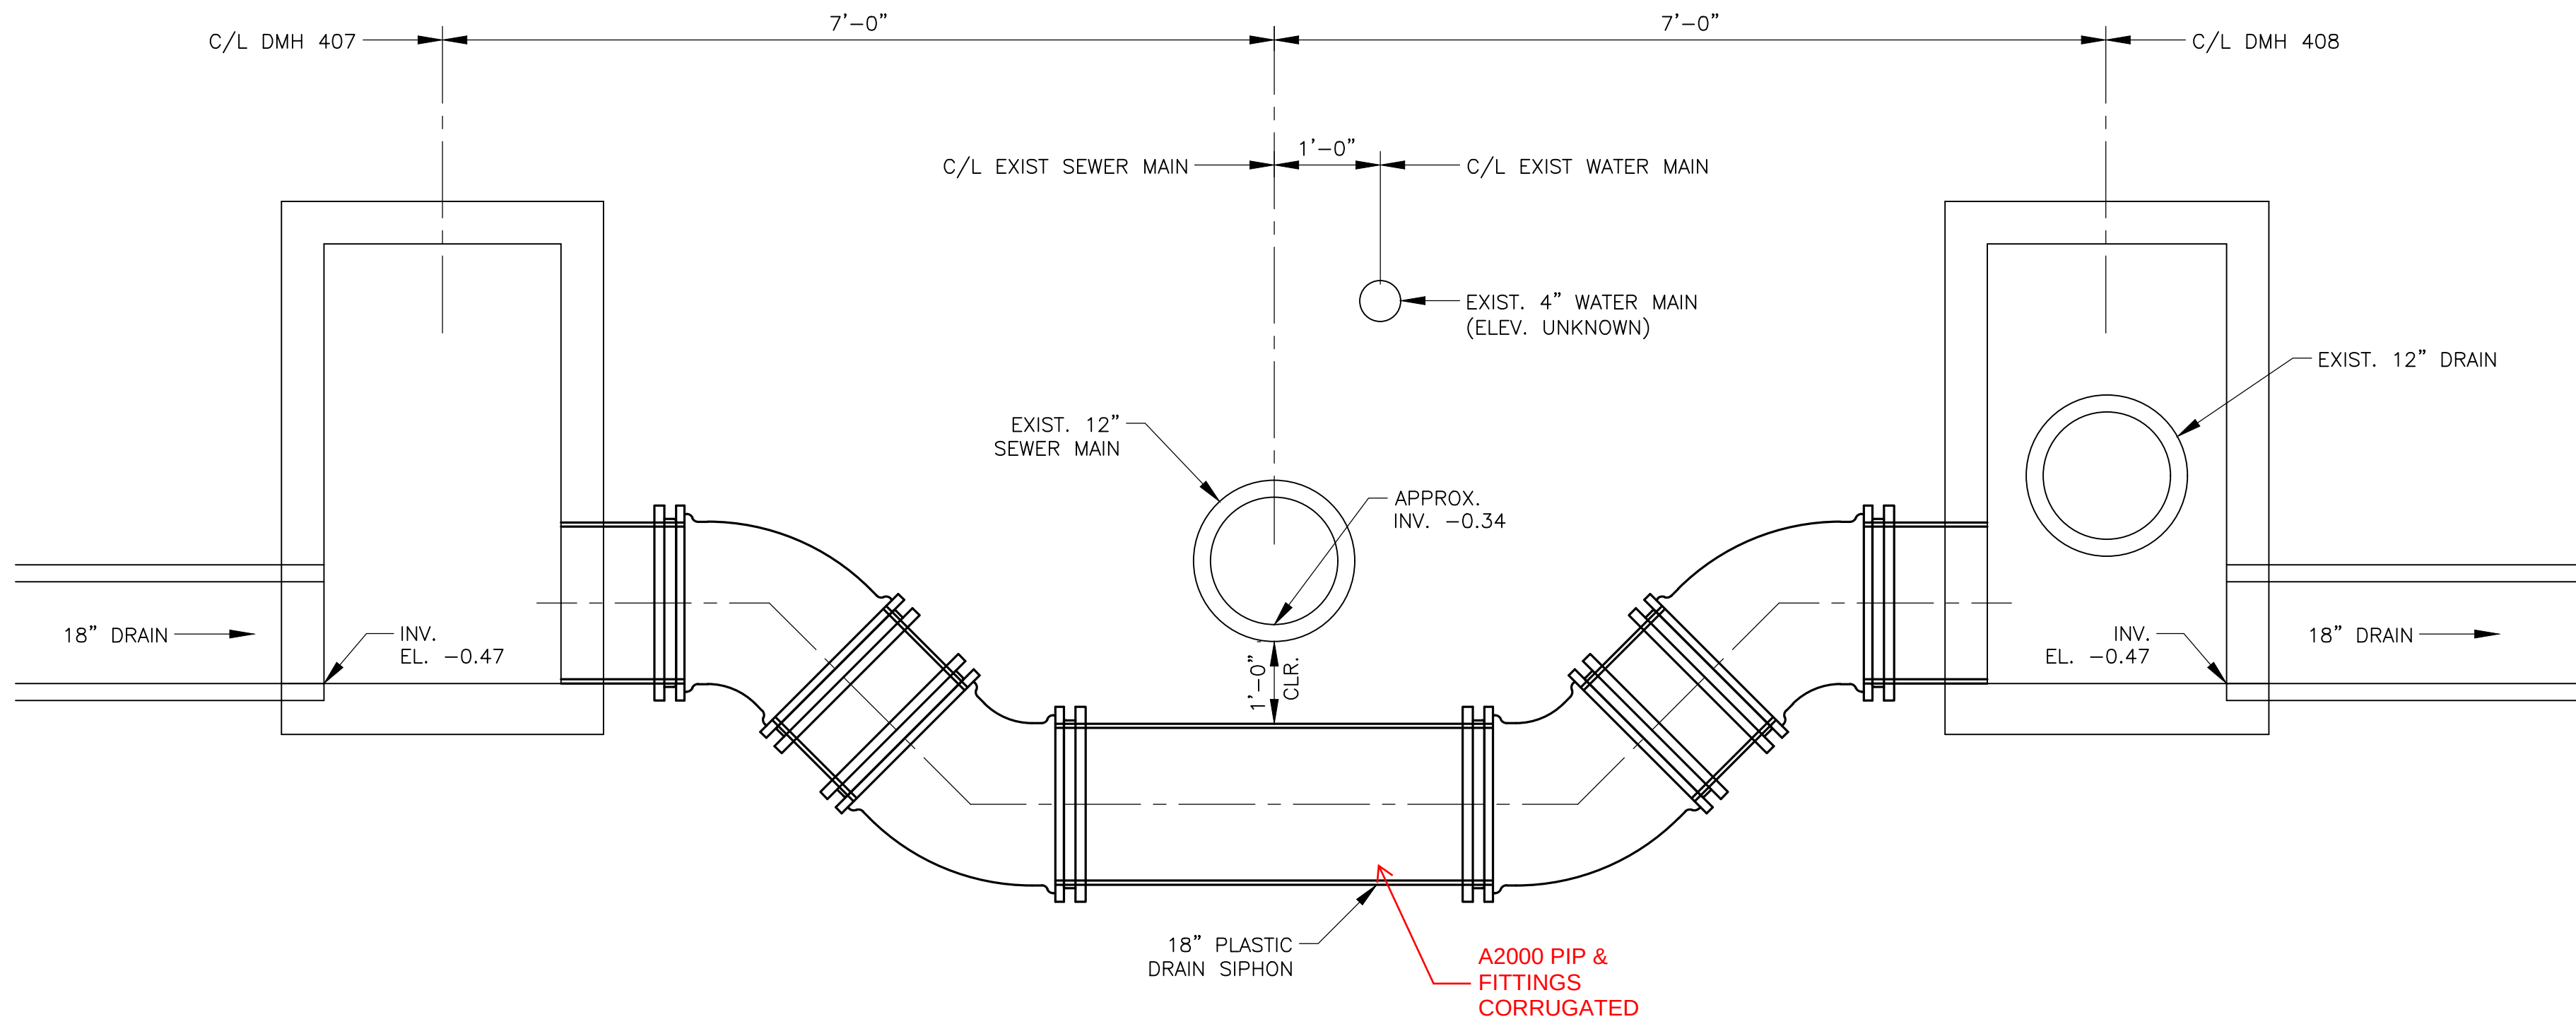

DRAIN SIPHON DETAIL
N.T.S.

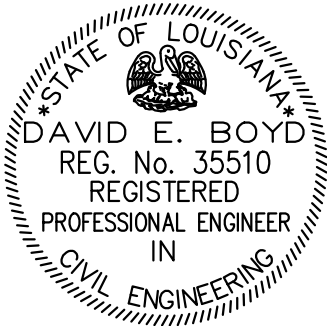


NO.	DATE	REVISION DESCRIPTION	BY

DESIGNED	R.P.
CHECKED	D.B.
DETAILED	S.G.
CHECKED	D.B.
DATE	DEC. 2021
SHEET	2 OF 2

BKI

BURK-KLEINPETER, INC.
ENGINEERS, ARCHITECTS, PLANNERS, ENVIRONMENTAL SCIENTISTS
4176 CANAL STREET, NEW ORLEANS, LA 70119-5994
PHONE (504)486-5901 • FAX (504)488-1714

BKI JOB # - 9344-8320 BASE BID

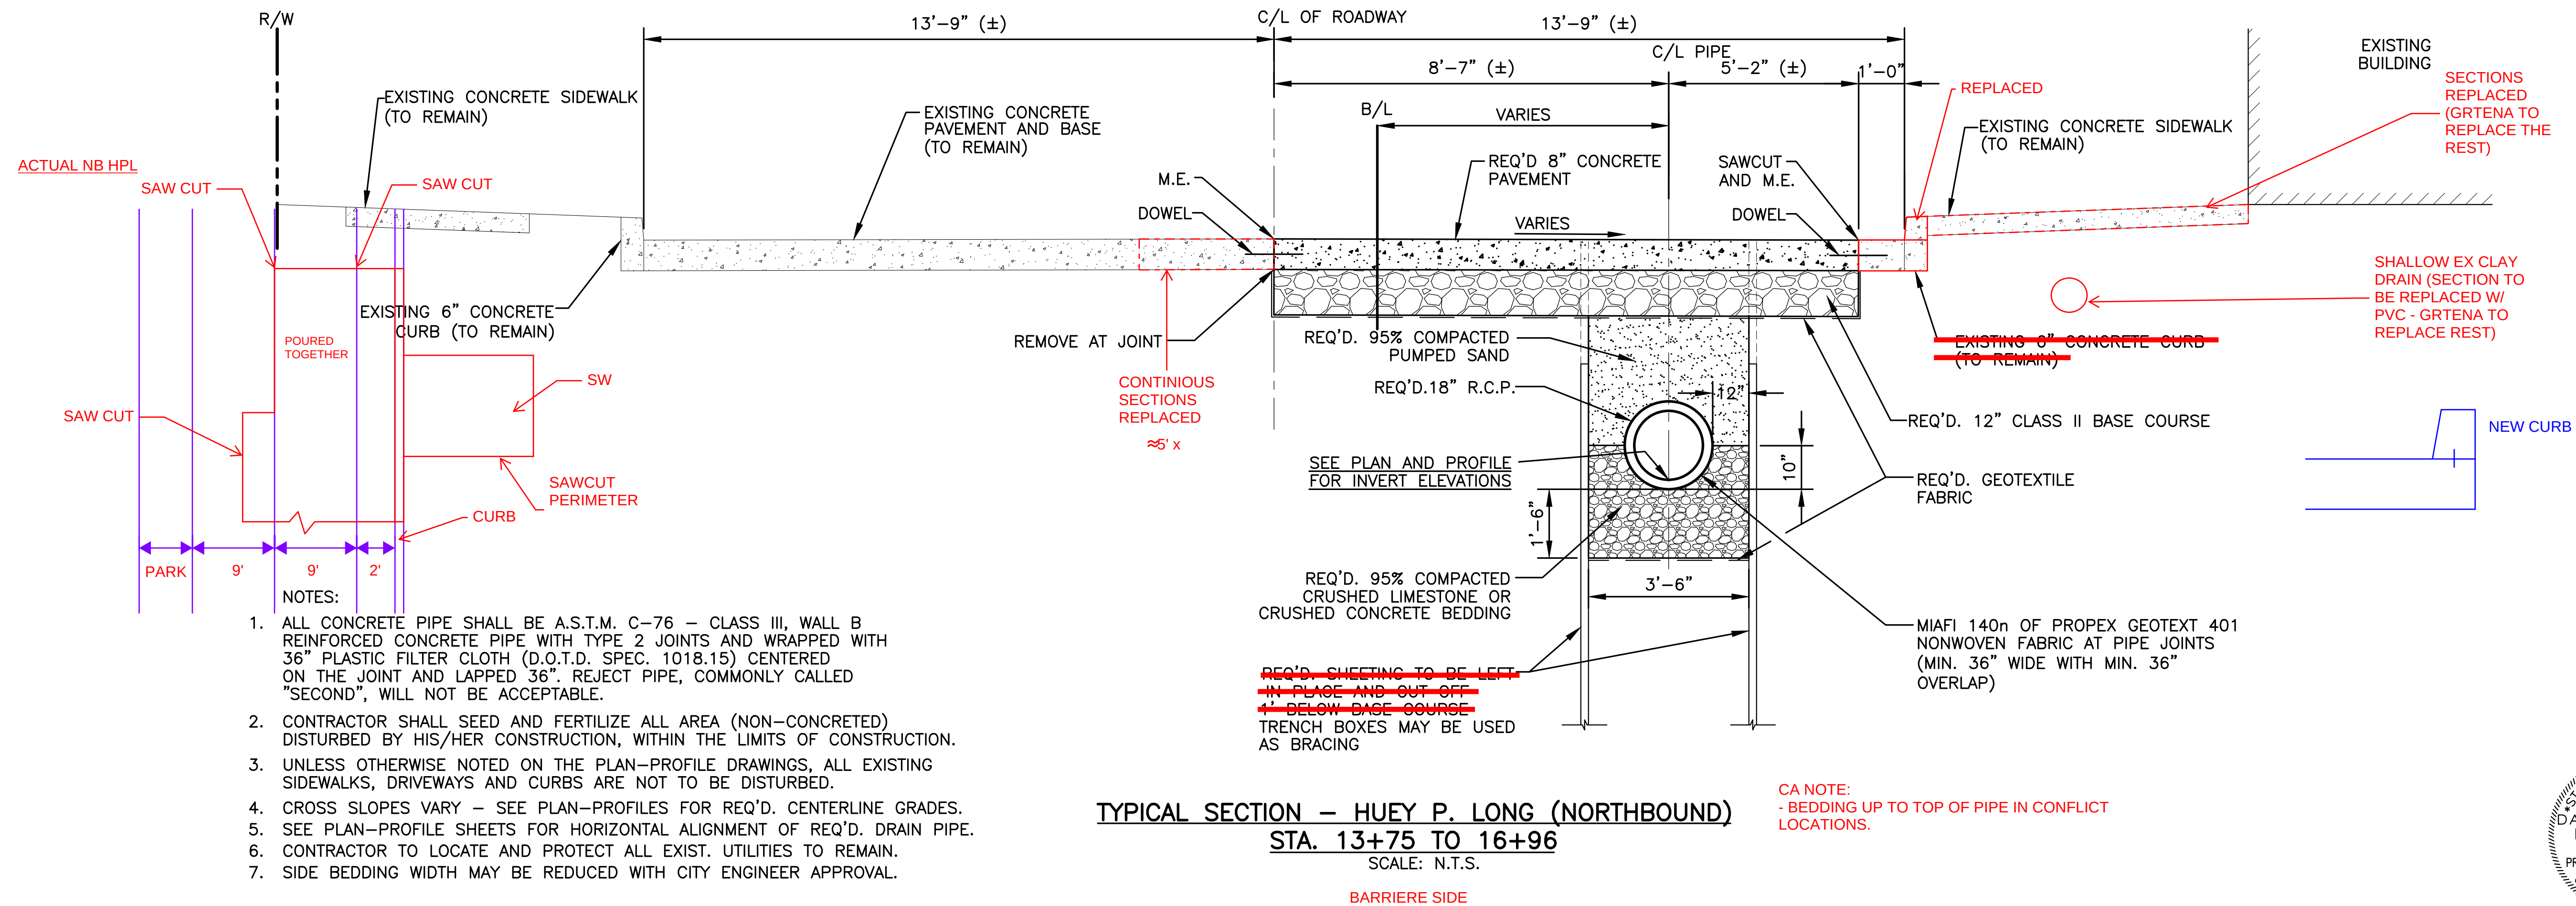





- NOTES:
1. ALL CONCRETE PIPE SHALL BE A.S.T.M. C-76 — CLASS III, WALL B REINFORCED CONCRETE PIPE WITH TYPE 2 JOINTS AND WRAPPED WITH 36" PLASTIC FILTER CLOTH (D.O.T.D. SPEC. 1018.15) CENTERED ON THE JOINT AND LAPPED 36". REJECT PIPE, COMMONLY CALLED "SECOND", WILL NOT BE ACCEPTABLE.
 2. CONTRACTOR SHALL SEED AND FERTILIZE ALL AREA (NON-CONCRETED) DISTURBED BY HIS/HER CONSTRUCTION, WITHIN THE LIMITS OF CONSTRUCTION.
 3. UNLESS OTHERWISE NOTED ON THE PLAN—PROFILE DRAWINGS, ALL EXISTING SIDEWALKS, DRIVEWAYS AND CURBS ARE NOT TO BE DISTURBED.
 4. CROSS SLOPES VARY — SEE PLAN—PROFILES FOR REQ'D. CENTERLINE GRADES.
 5. SEE PLAN—PROFILE SHEETS FOR HORIZONTAL ALIGNMENT OF REQ'D. DRAIN PIPE.
 6. CONTRACTOR TO LOCATE AND PROTECT ALL EXIST. UTILITIES TO REMAIN.
 7. SIDE BEDDING WIDTH MAY BE REDUCED WITH CITY ENGINEER APPROVAL.

CA NOTE:
- BEDDING UP TO TOP OF PIPE IN CONFLICT LOCATIONS.


FILE NAME: C:\USERS\SGALATAS\DESKTOP\NO.16.010_ARCHIVE COPY_DRAWINGS\C4-C6-TYPICAL SECTIONS.DWG

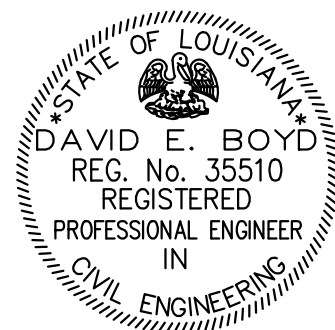

FILE NAME: C:\USERS\SGALATAS\DESKTOP\NO.16.010_ARCHIVE_COPY_DRAWINGS\C4-C6-TYPICAL SECTIONS.DWG

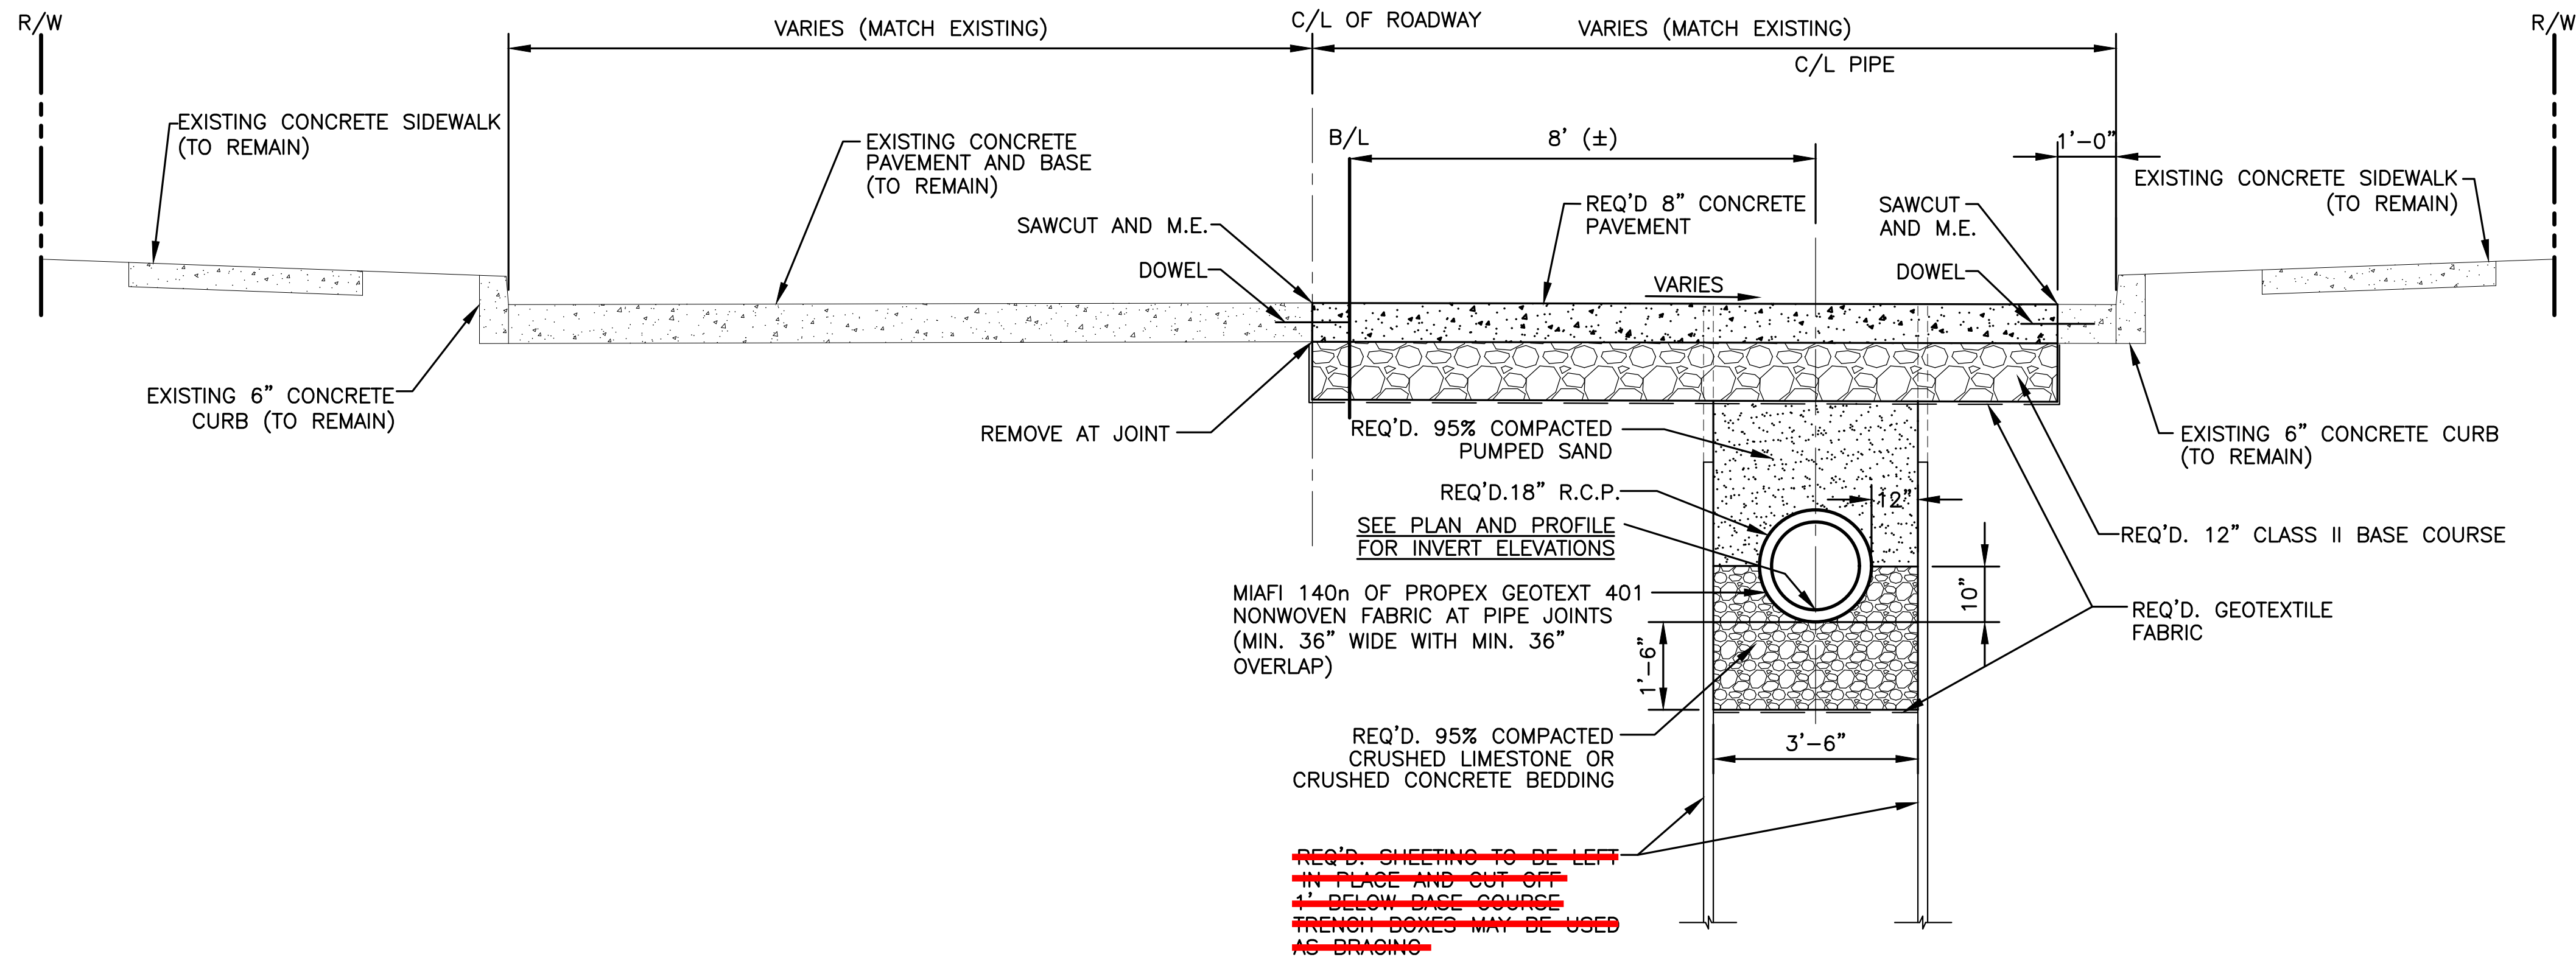

TYPICAL SECTION – LAVOISIER ST.
STA. 13+46.91 TO 17+06.63
SCALE: N.T.S.

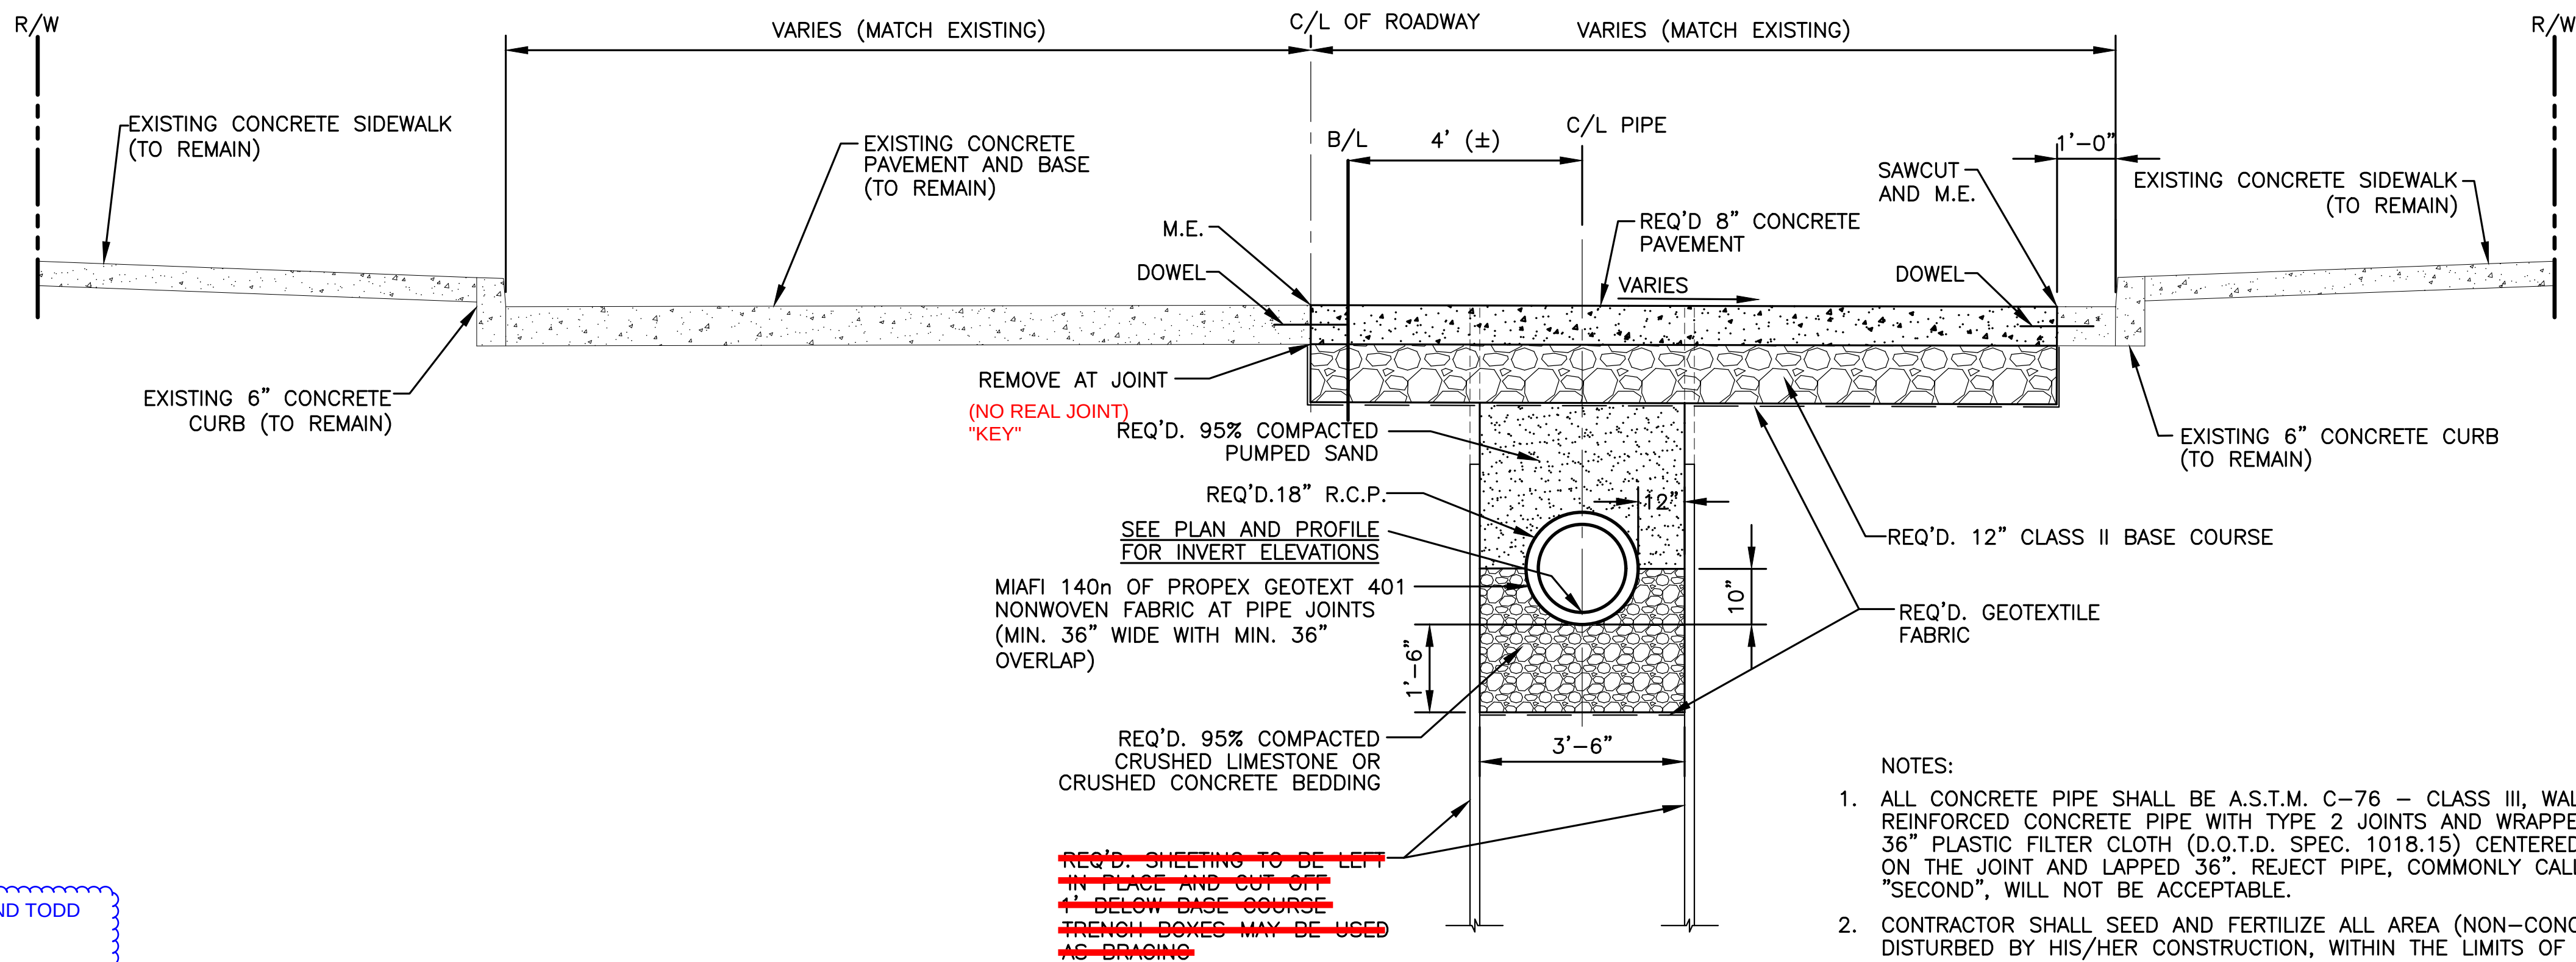



TYPICAL SECTION – NEWTON ST.
STA. 13+47.24 TO 17+08.54
SCALE: N.T.S.
KASS SIDE



- 07/25/22 - SITE DISCUSSION WITH CODY AND TODD
- ONLY 8-9' TRENCH
 - REPLACE PAVEMENT ONLY (IF/WHEN CRACKED)
 - SAWCUT ≈3-4' OFF DW/ WRB
 - CODY IS TO SEND SKETCH WITH FINAL DIMENSIONS


NOTES:

- ALL CONCRETE PIPE SHALL BE A.S.T.M. C-76 – CLASS III, WALL B REINFORCED CONCRETE PIPE WITH TYPE 2 JOINTS AND WRAPPED WITH 36" PLASTIC FILTER CLOTH (D.O.T.D. SPEC. 1018.15) CENTERED ON THE JOINT AND LAPPED 36". REJECT PIPE, COMMONLY CALLED "SECOND", WILL NOT BE ACCEPTABLE.
- CONTRACTOR SHALL SEED AND FERTILIZE ALL AREA (NON-CONCRETED) DISTURBED BY HIS/HER CONSTRUCTION, WITHIN THE LIMITS OF CONSTRUCTION.
- UNLESS OTHERWISE NOTED ON THE PLAN-PROFILE DRAWINGS, ALL EXISTING SIDEWALKS, DRIVEWAYS AND CURBS ARE NOT TO BE DISTURBED.
- CROSS SLOPES VARY – SEE PLAN-PROFILES FOR REQ'D. CENTERLINE GRADES.
- SEE PLAN-PROFILE SHEETS FOR HORIZONTAL ALIGNMENT OF REQ'D. DRAIN PIPE.
- CONTRACTOR TO LOCATE AND PROTECT ALL EXIST. UTILITIES TO REMAIN.
- SIDE BEDDING WIDTH MAY BE REDUCED WITH CITY ENGINEER APPROVAL.

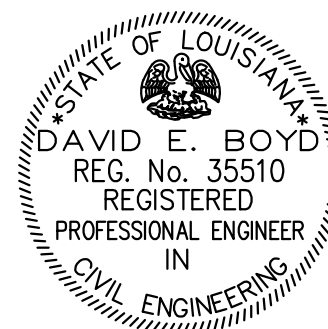


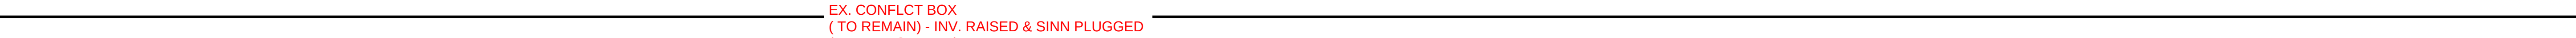

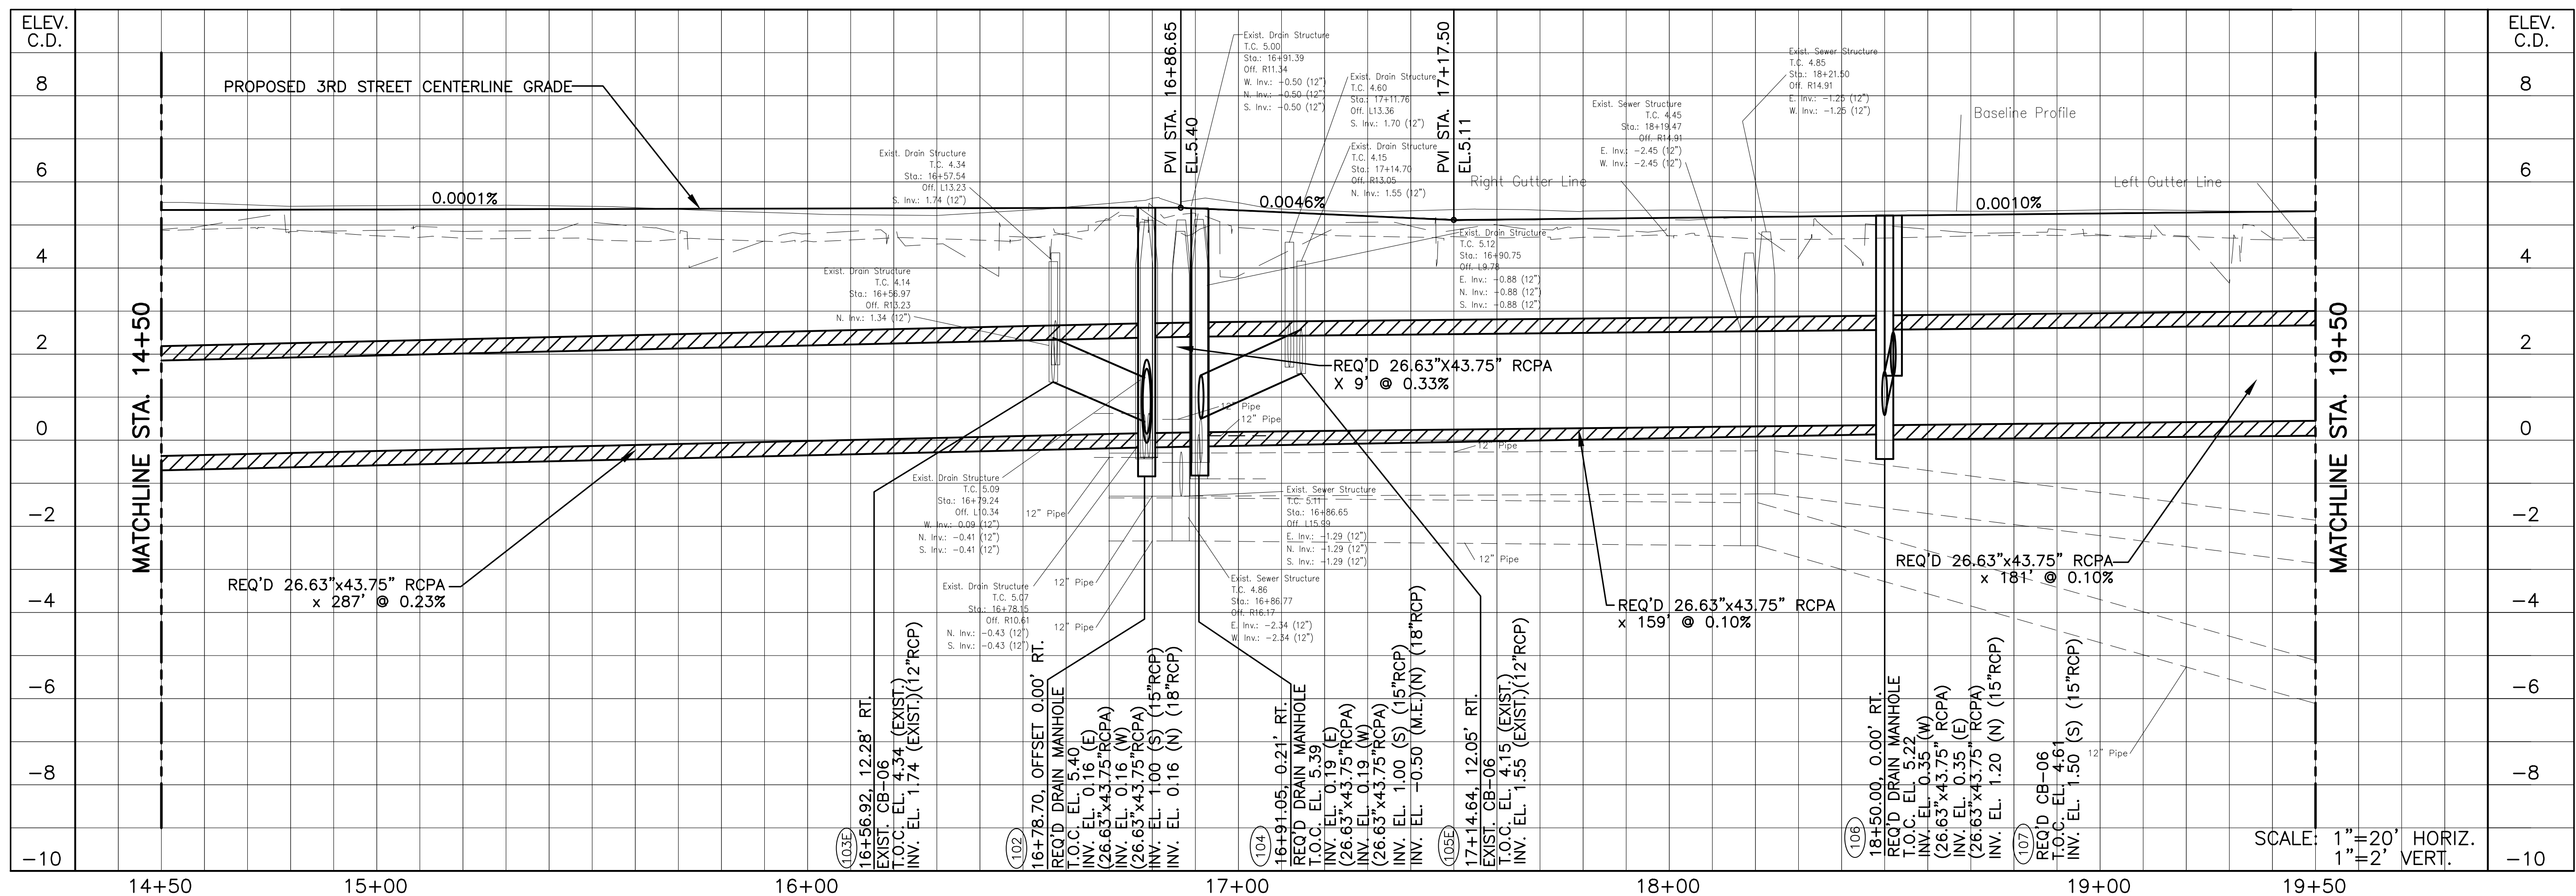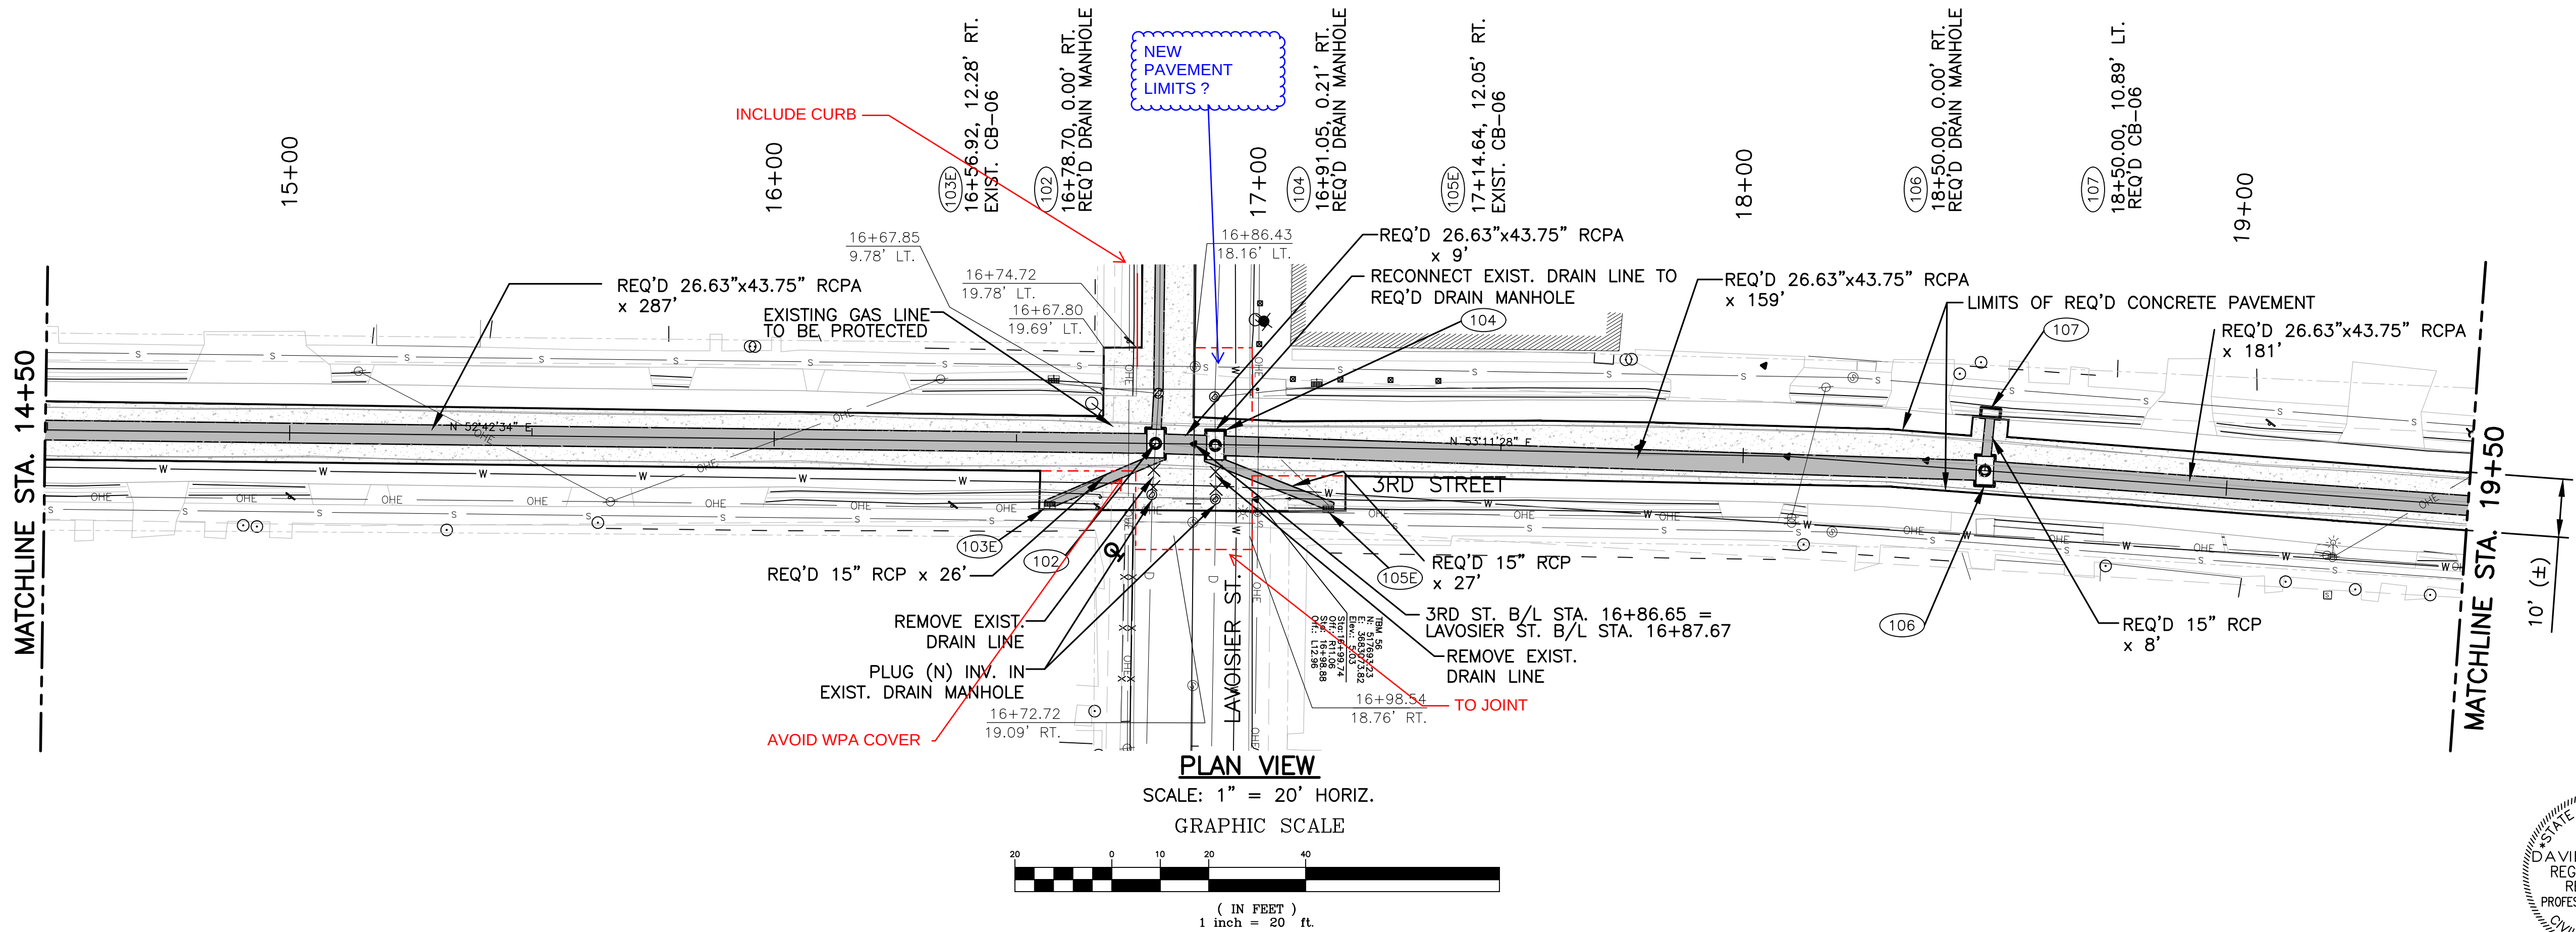


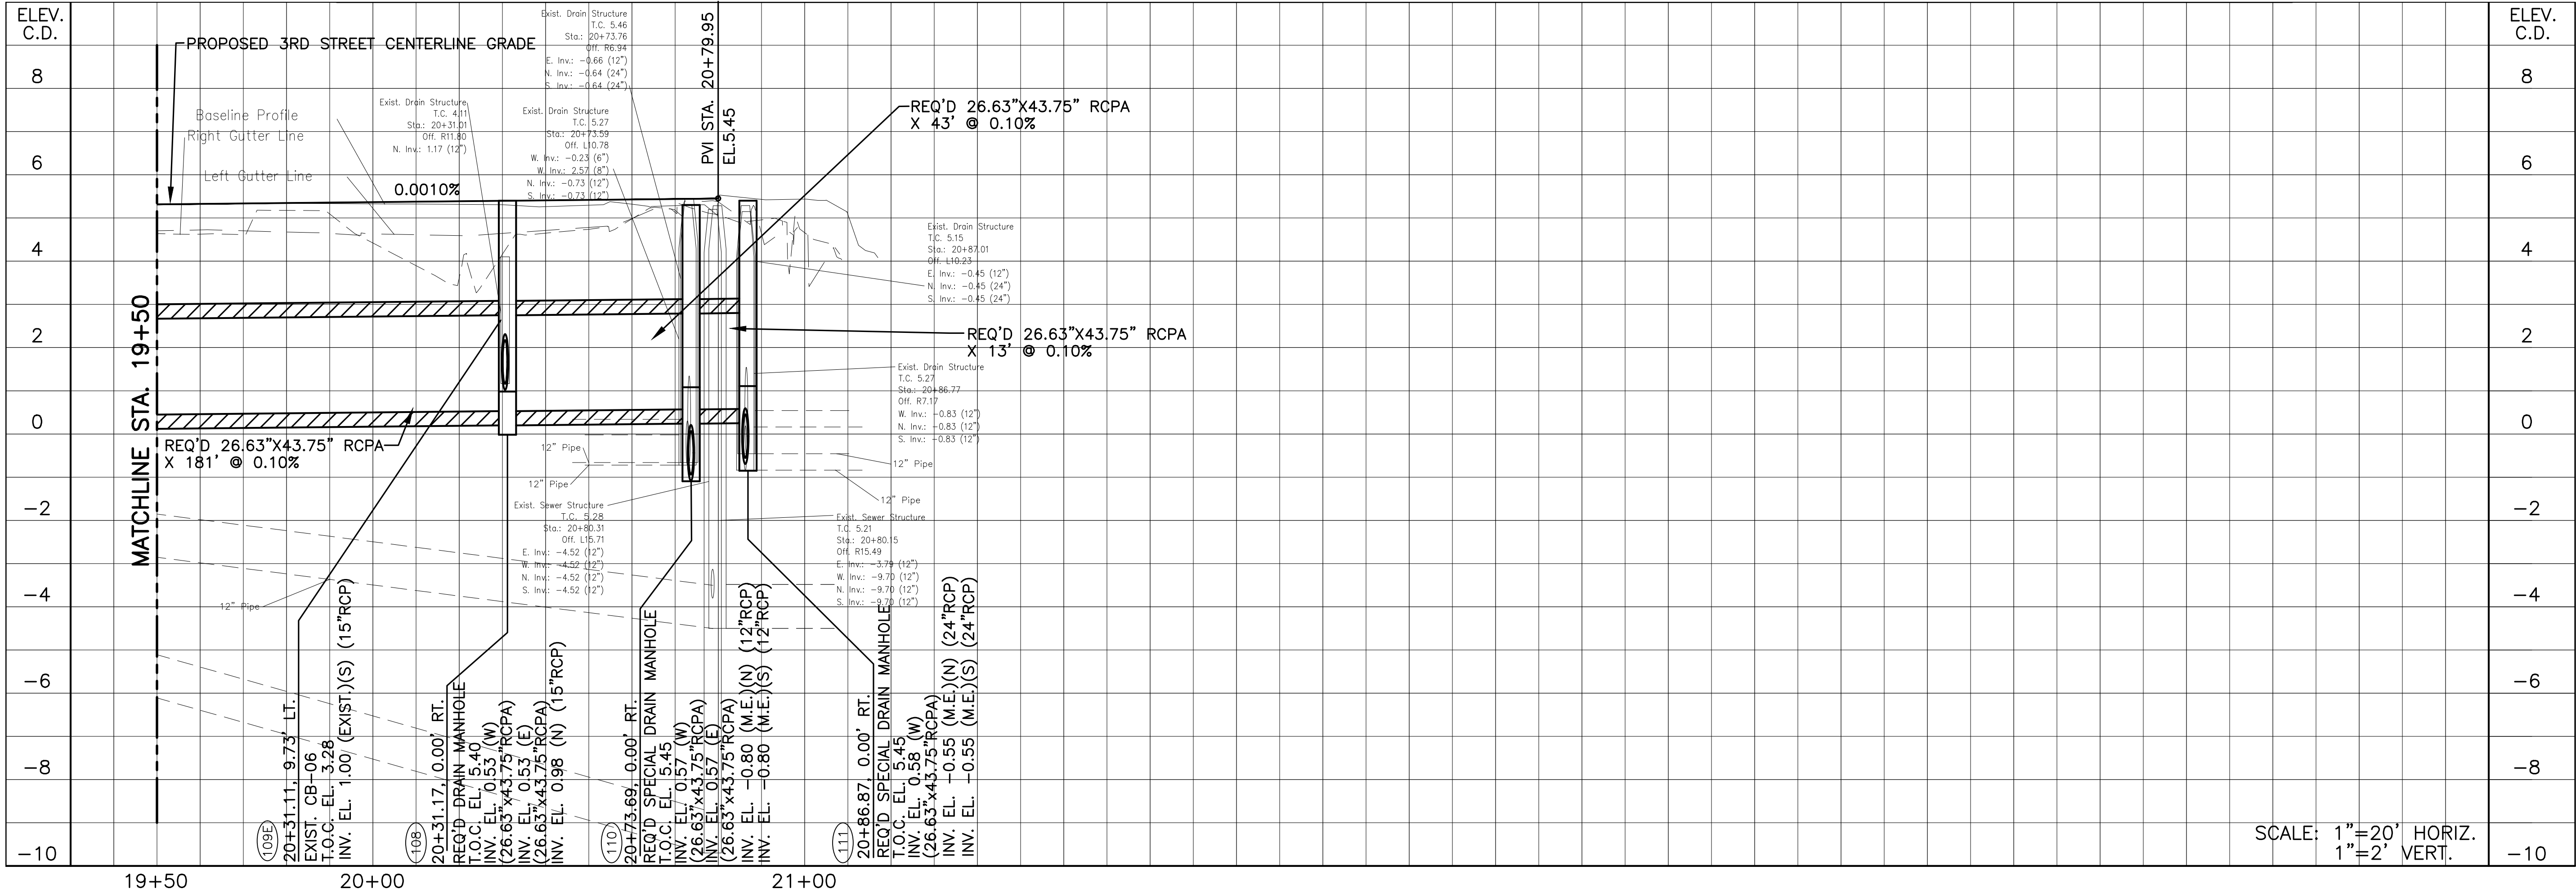





SCALE: 1"=20' HORIZ.
1"=2' VERT.

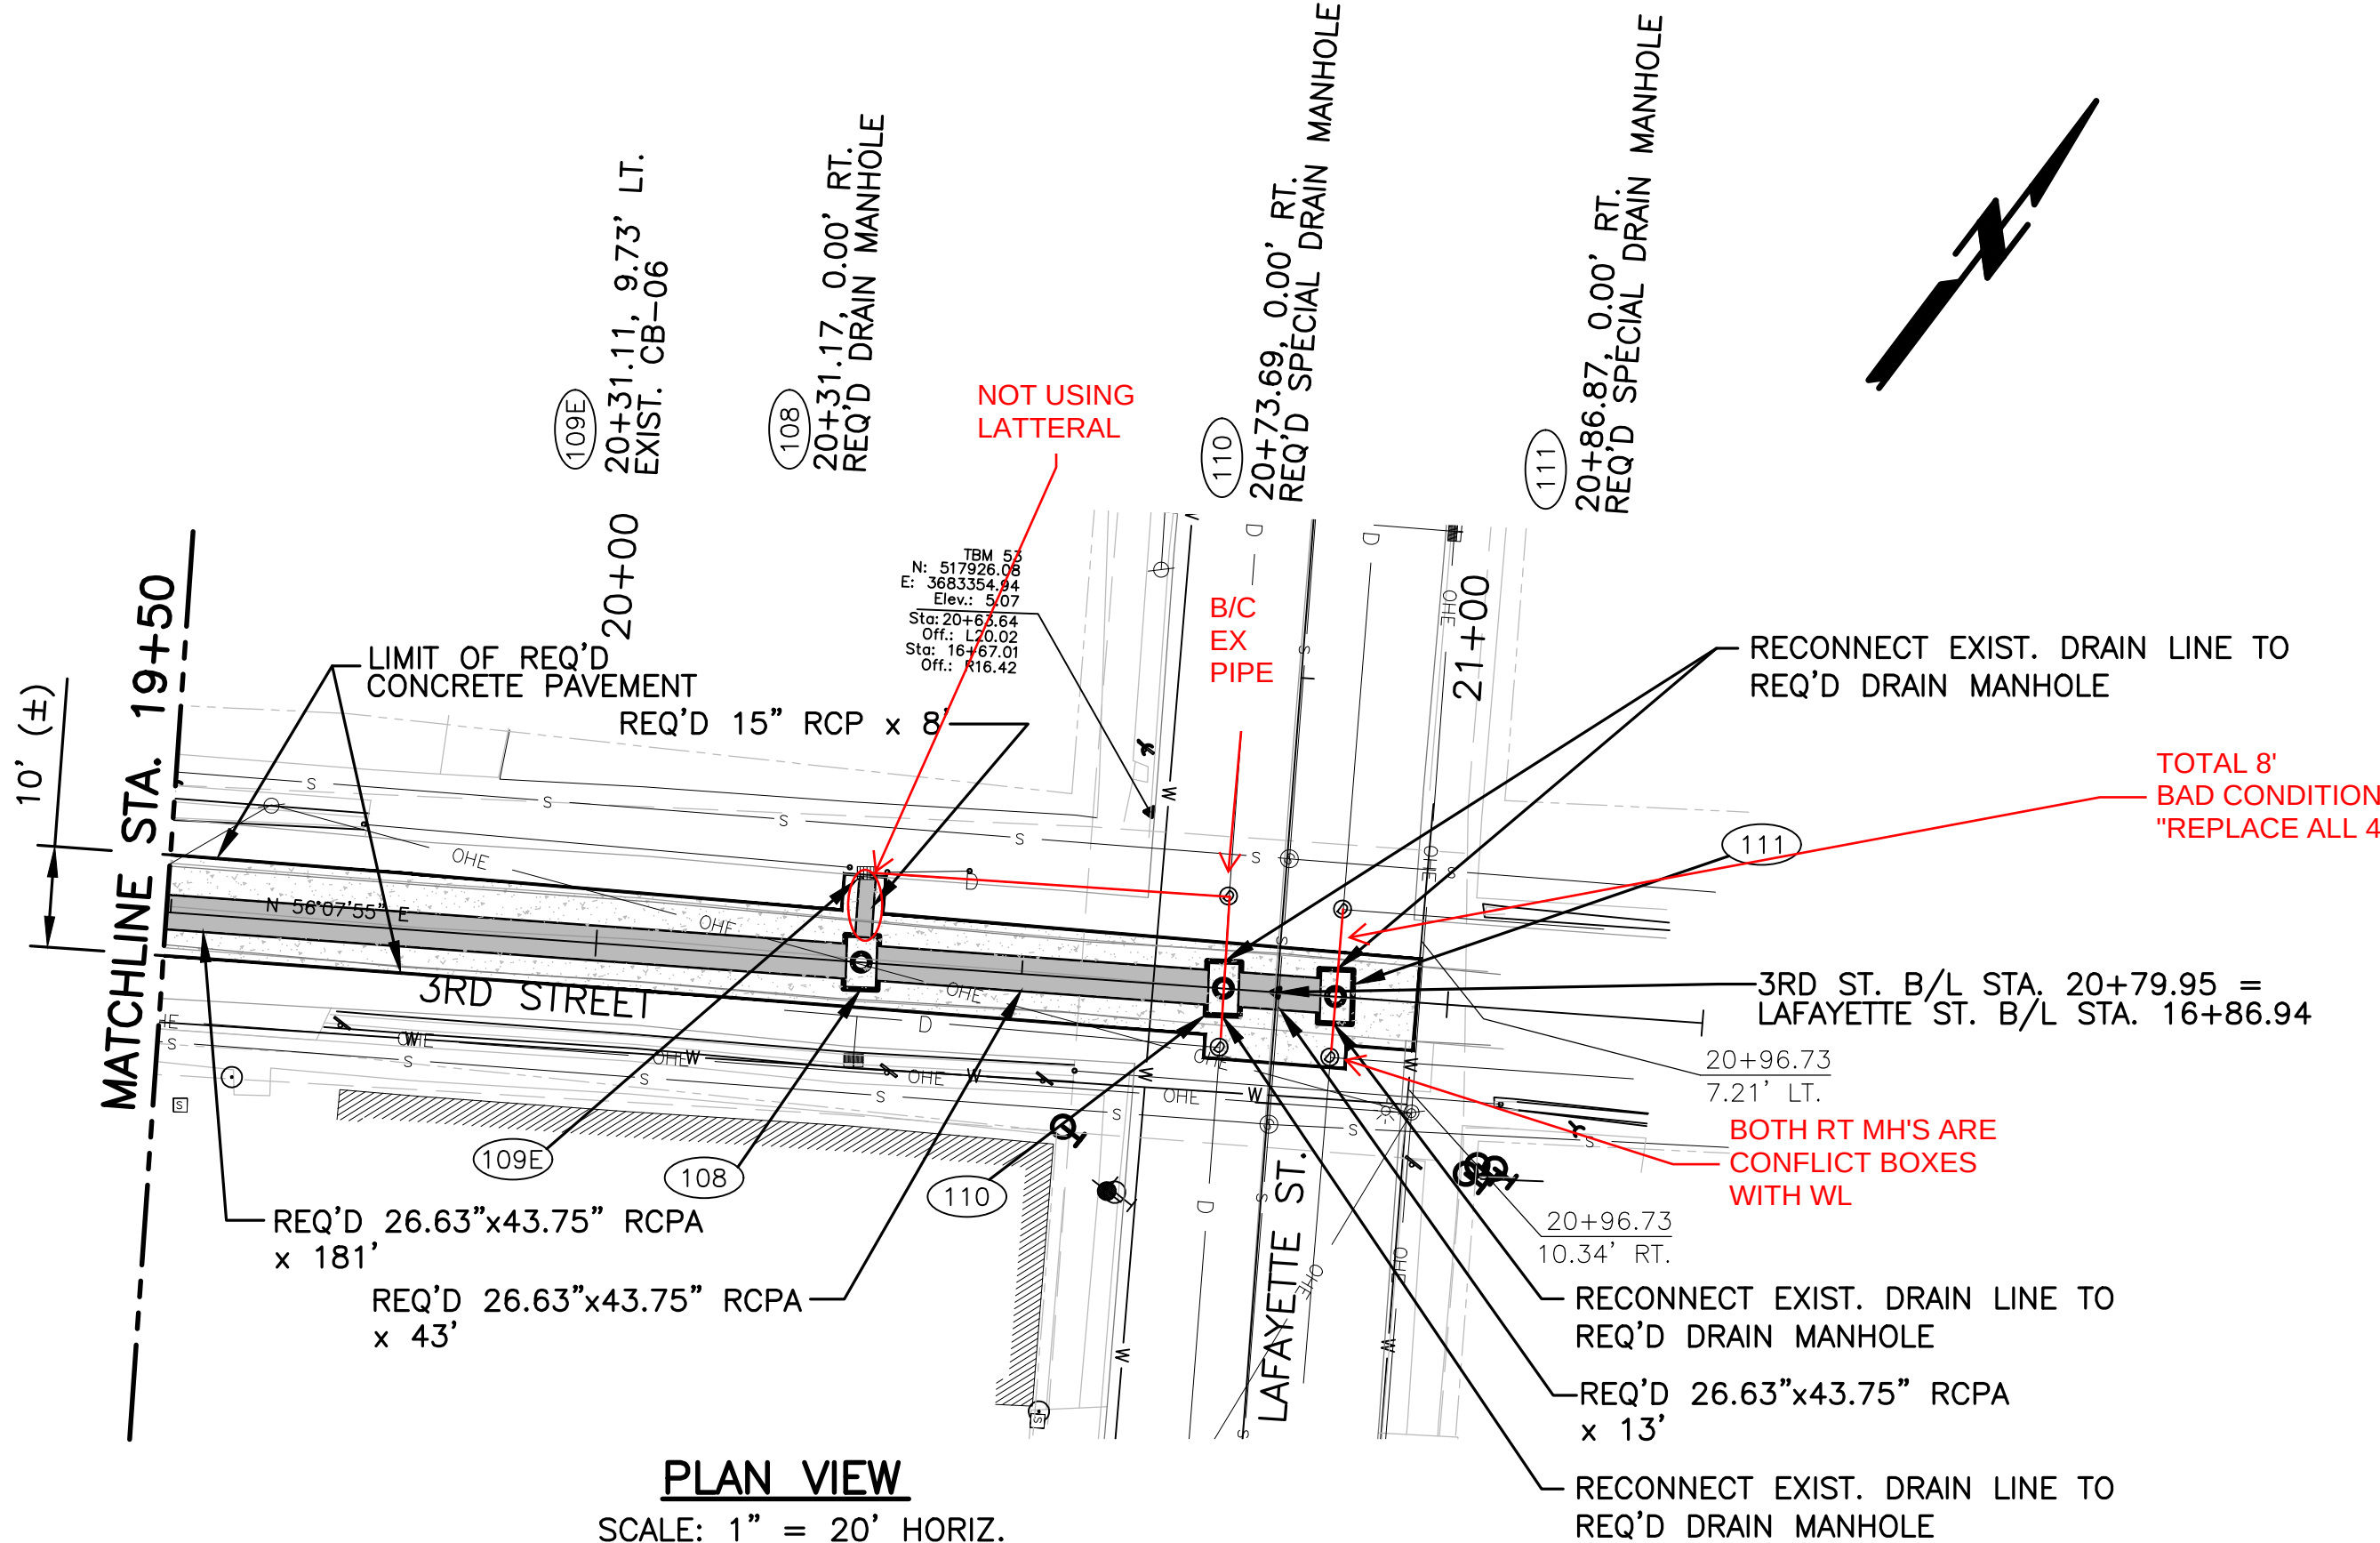


PLAN VIEW
SCALE: 1" = 20' HORIZ.
GRAPHIC SCALE
(IN FEET)
1 inch = 20 ft.

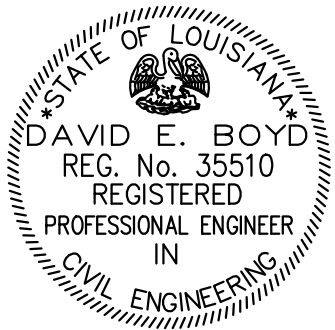



FILE NAME: C:\USERS\SGALATAS\DESKTOP\NO.16.010_ARCHIVE_COPY_DRAWINGS\07-C15-PLANPROFILE.DWG

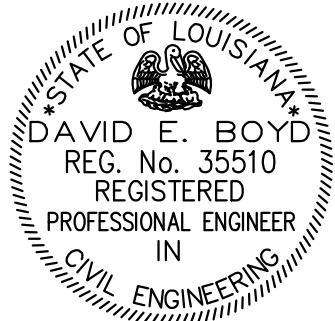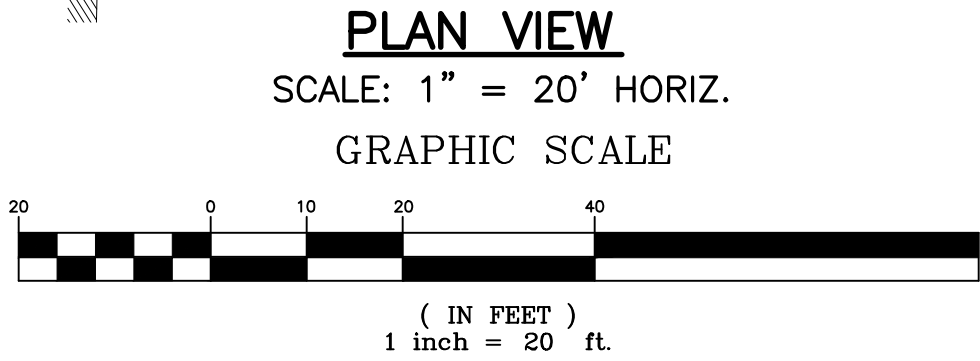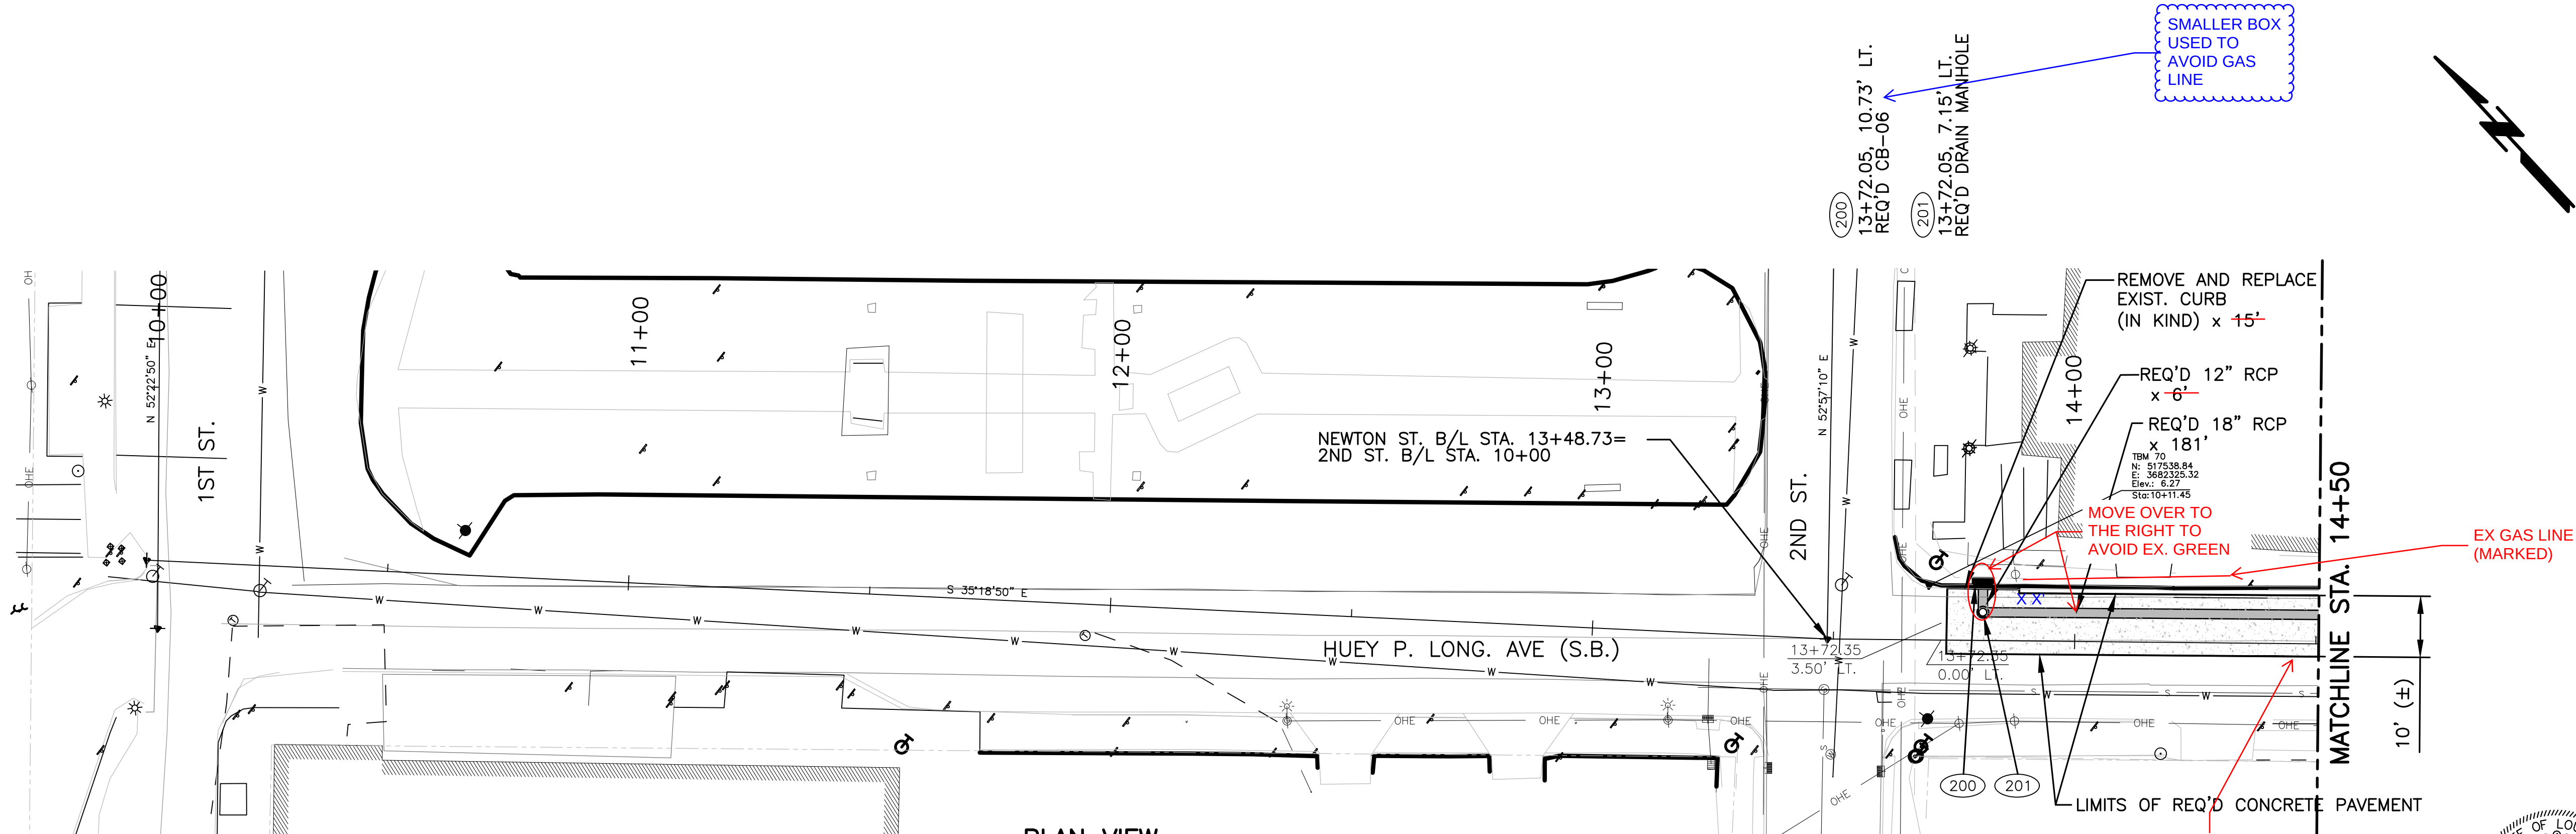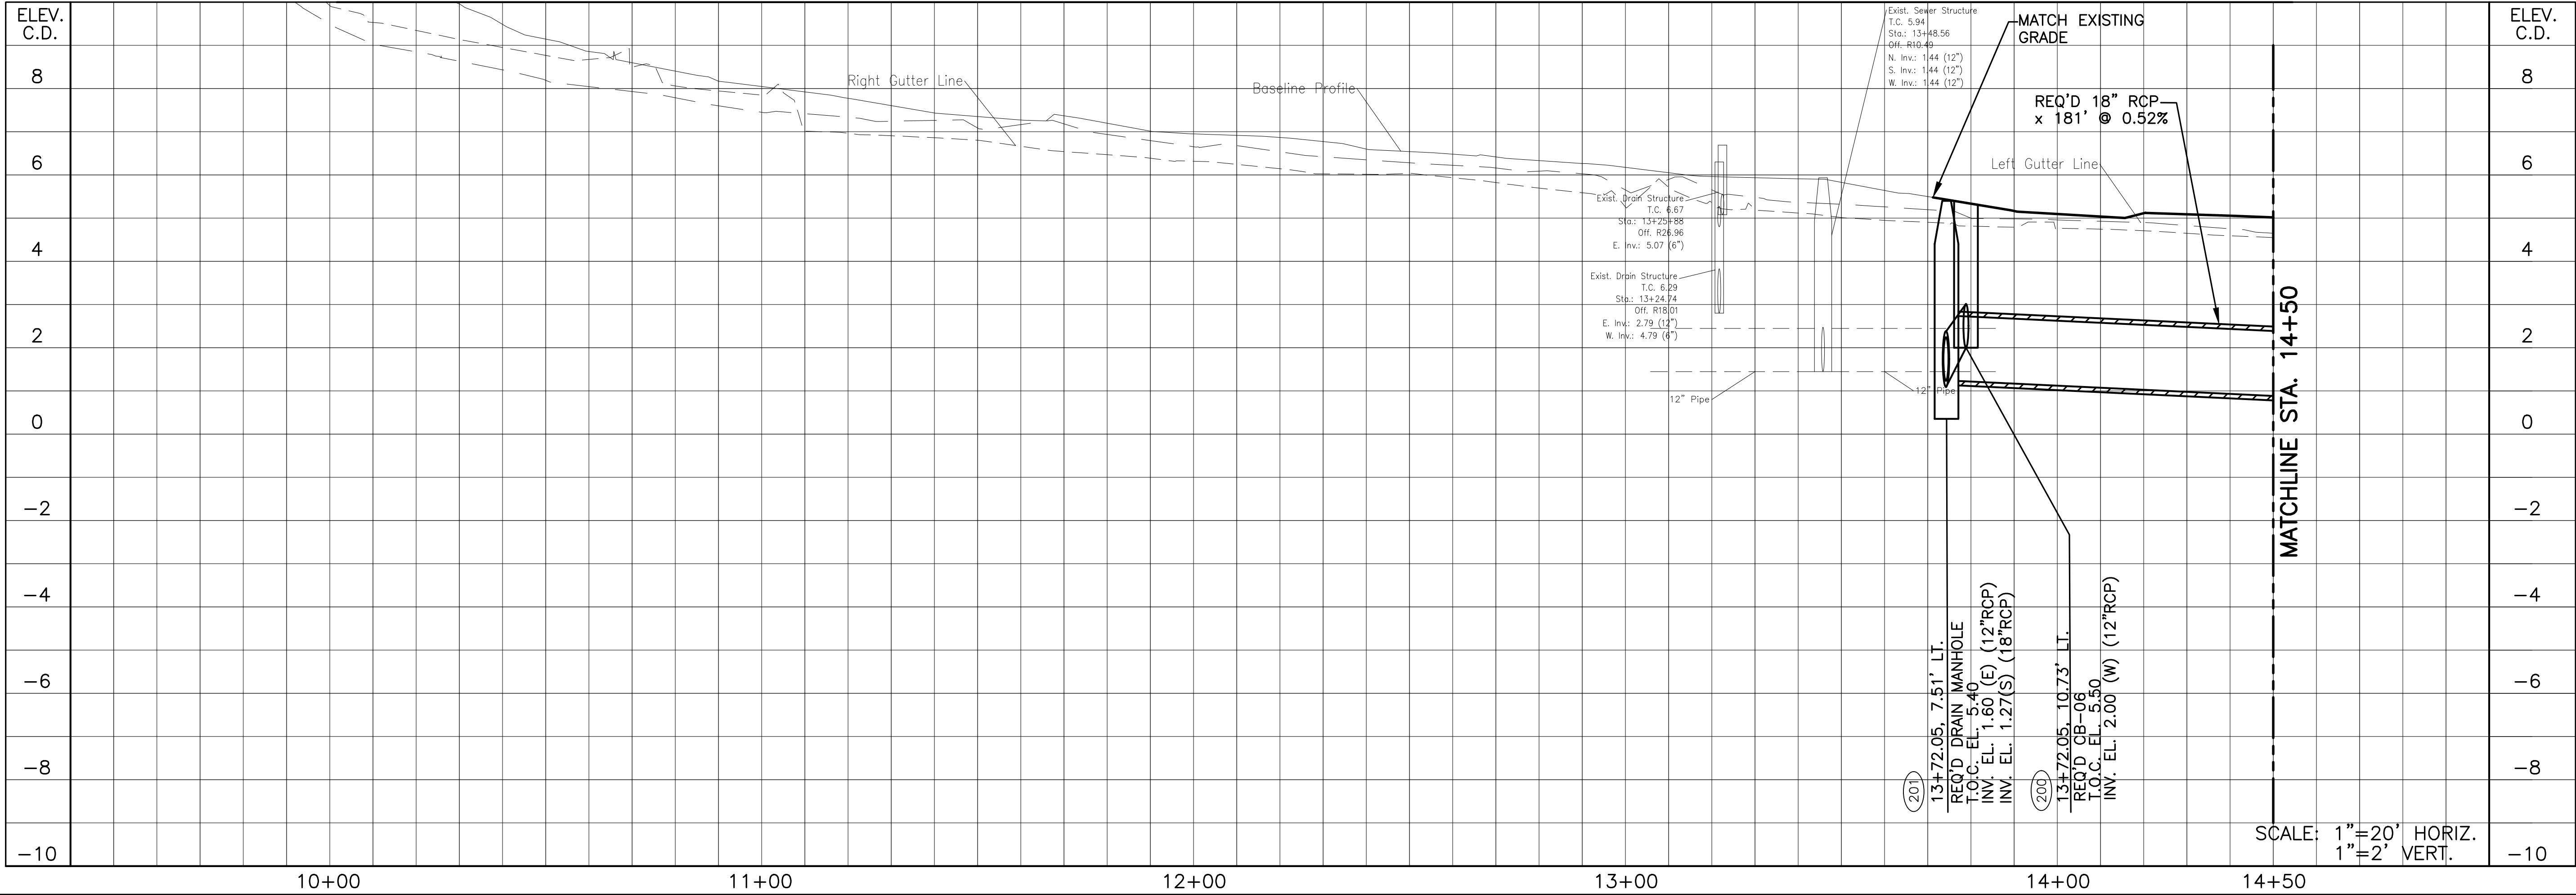



SHEET NUMBER		C10	
DESIGNED		R.P.	
CHECKED		D.B.	
DETAILED		S.G.	
CHECKED		D.B.	
DATE		DEC. 2021	
SHEET		4 OF 9	
NO.		DATE	
REVISION DESCRIPTION		BY	
BURK-KLEINPETER, INC. ENGINEERS, ARCHITECTS, PLANNERS, ENVIRONMENTAL SCIENTISTS 4176 CANAL STREET, NEW ORLEANS, LA 70119-5994 PHONE (504)486-5901 • FAX (504)486-1714			
BKI JOB # - 9344-8320- BASE BID			
GRETNADOWNTOWN DRAINAGE IMPROVEMENTS (PHASE 2) PLAN PROFILE			


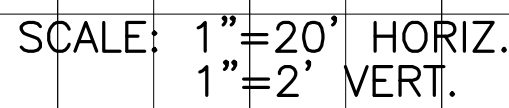


- EX PANEL REPLACEMENT TO BE DRAWN LATER

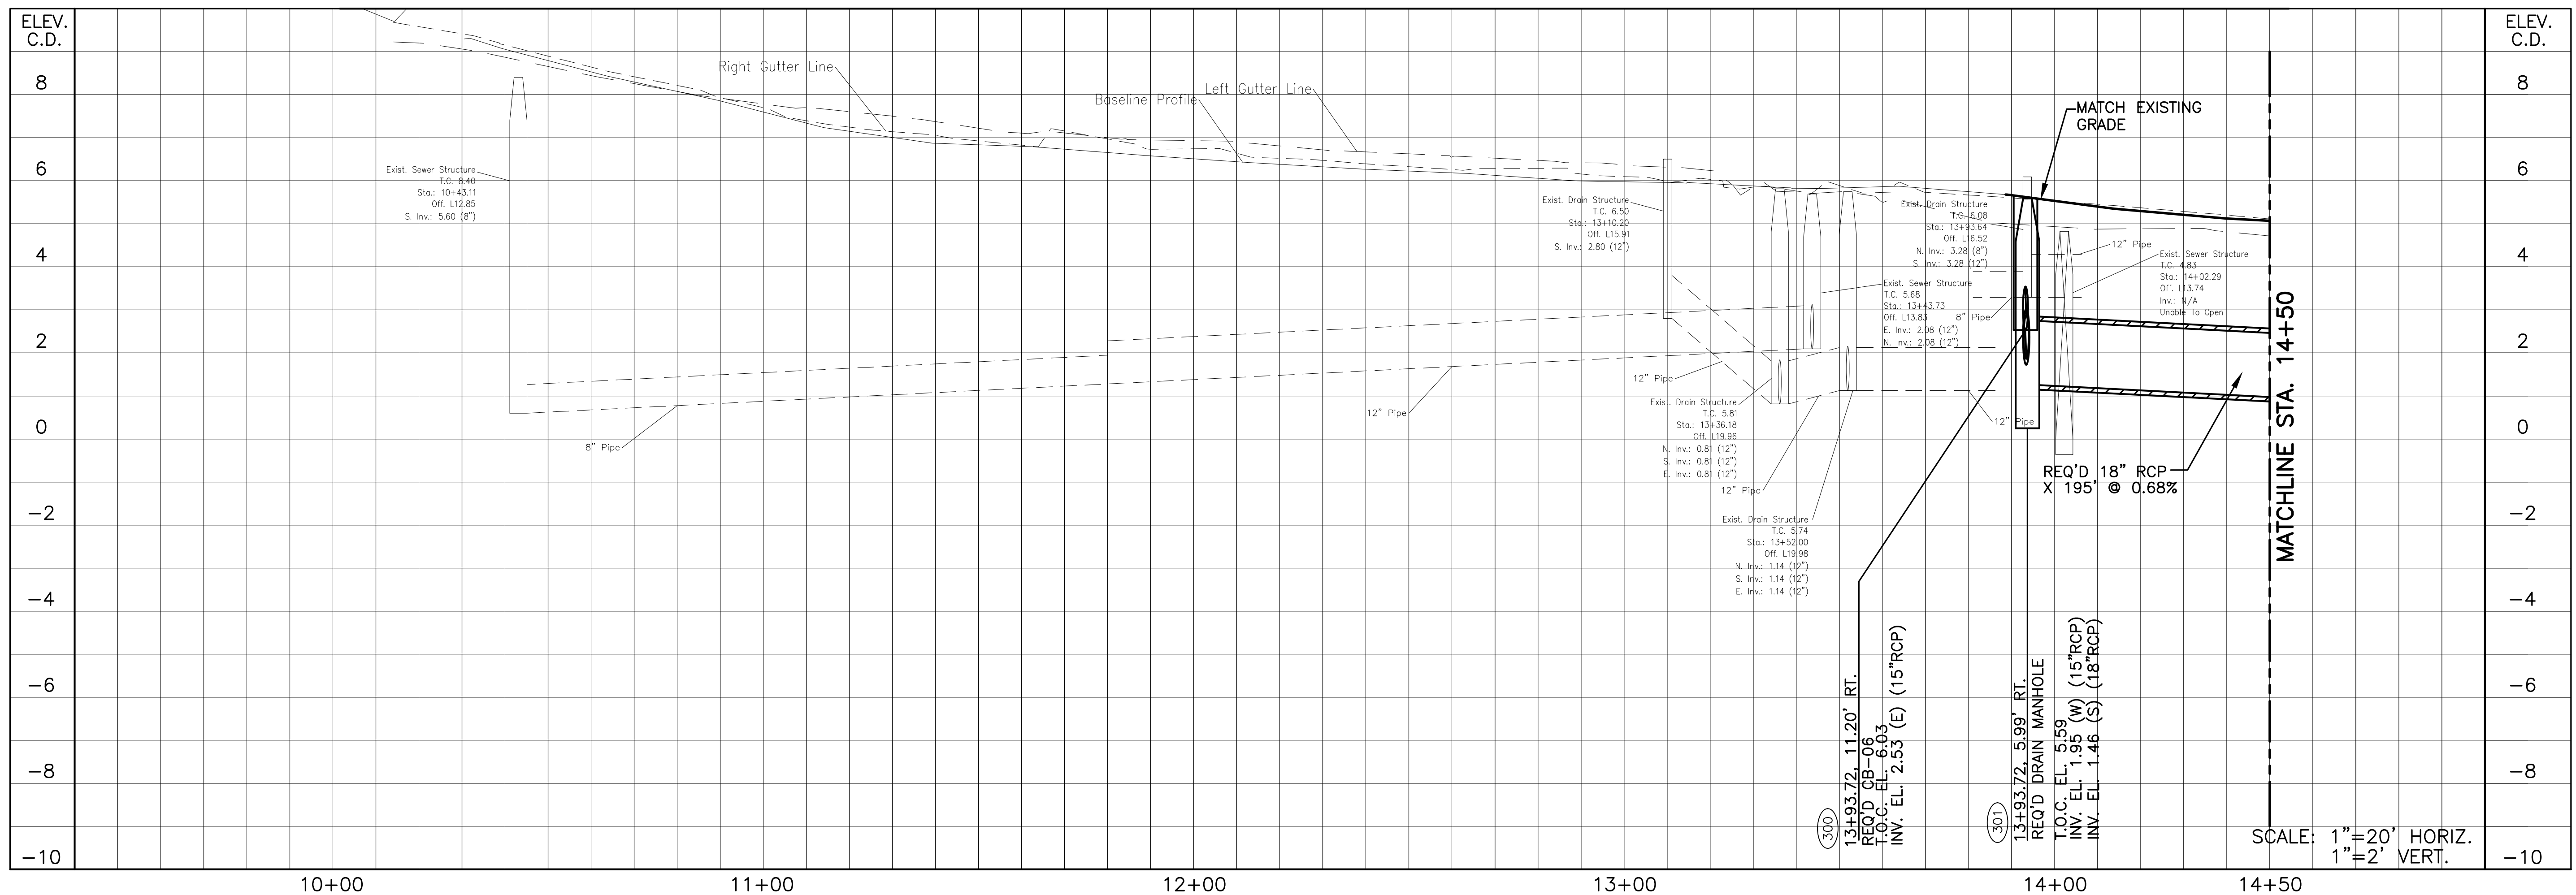
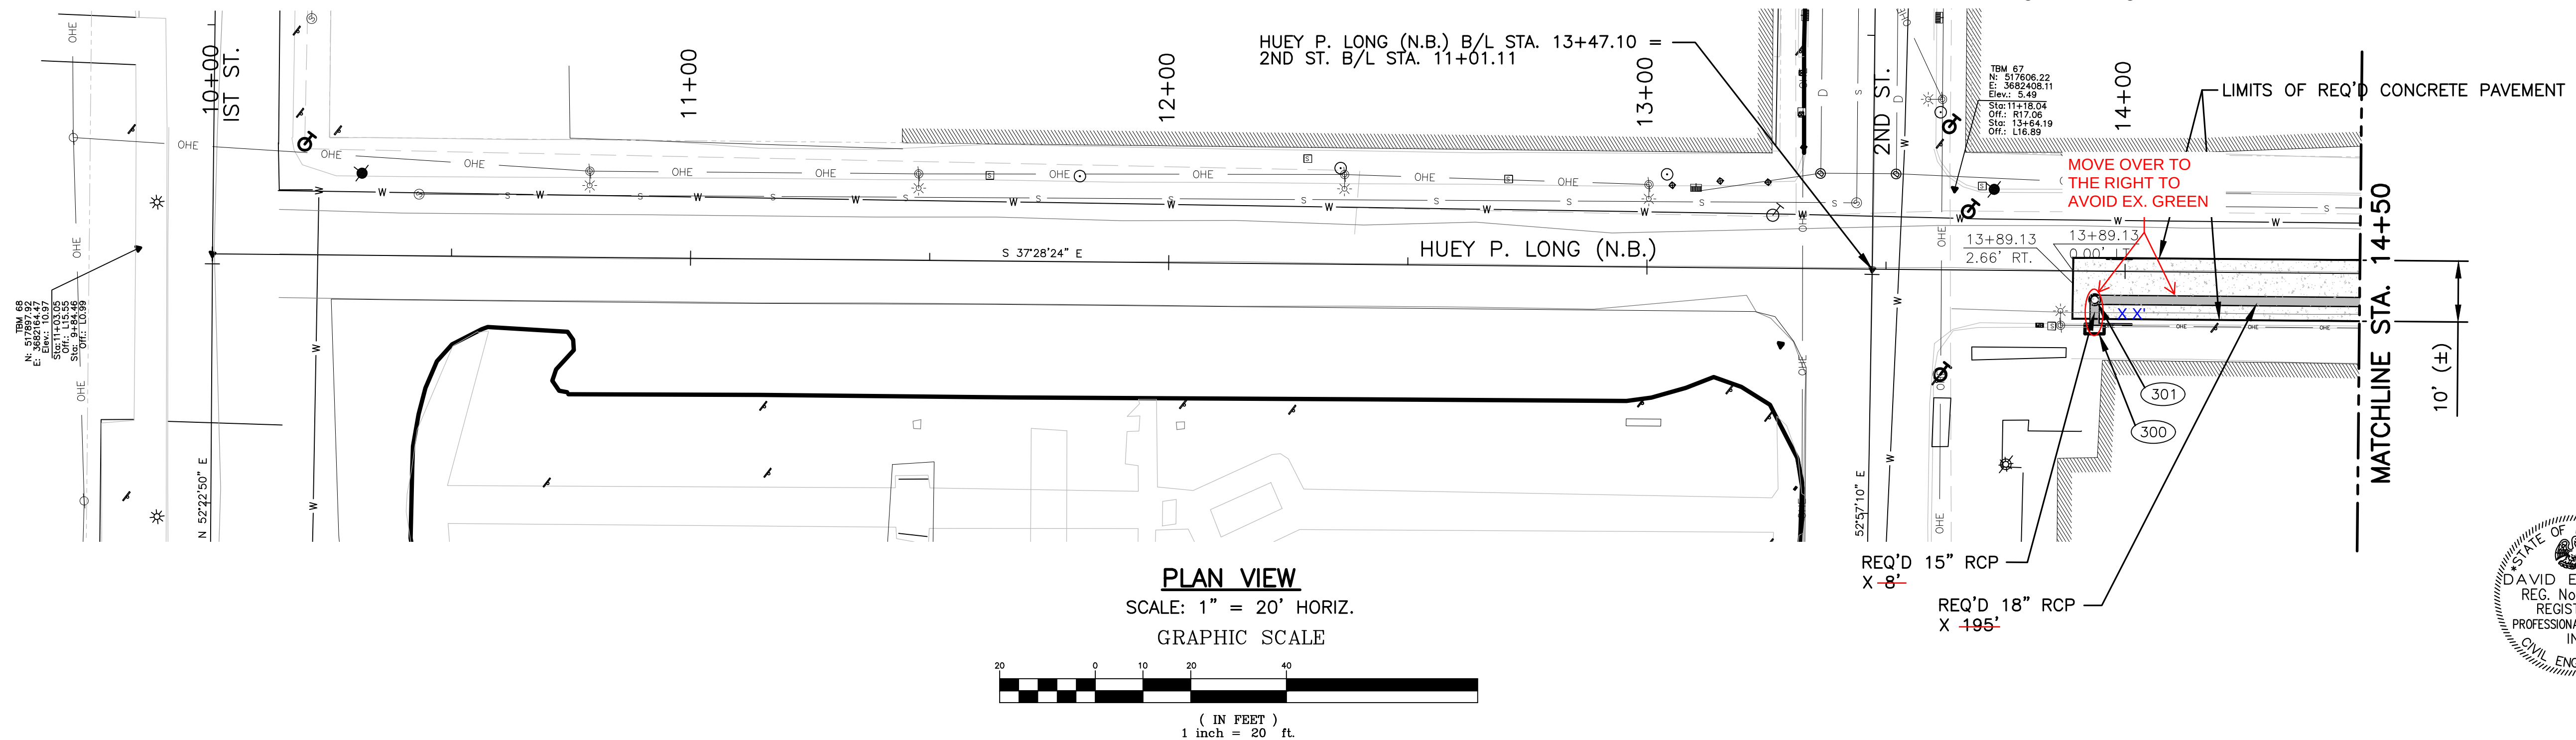


- CLAY PIPE & SW REPLACEMENT TO BE DRAWN LATER.

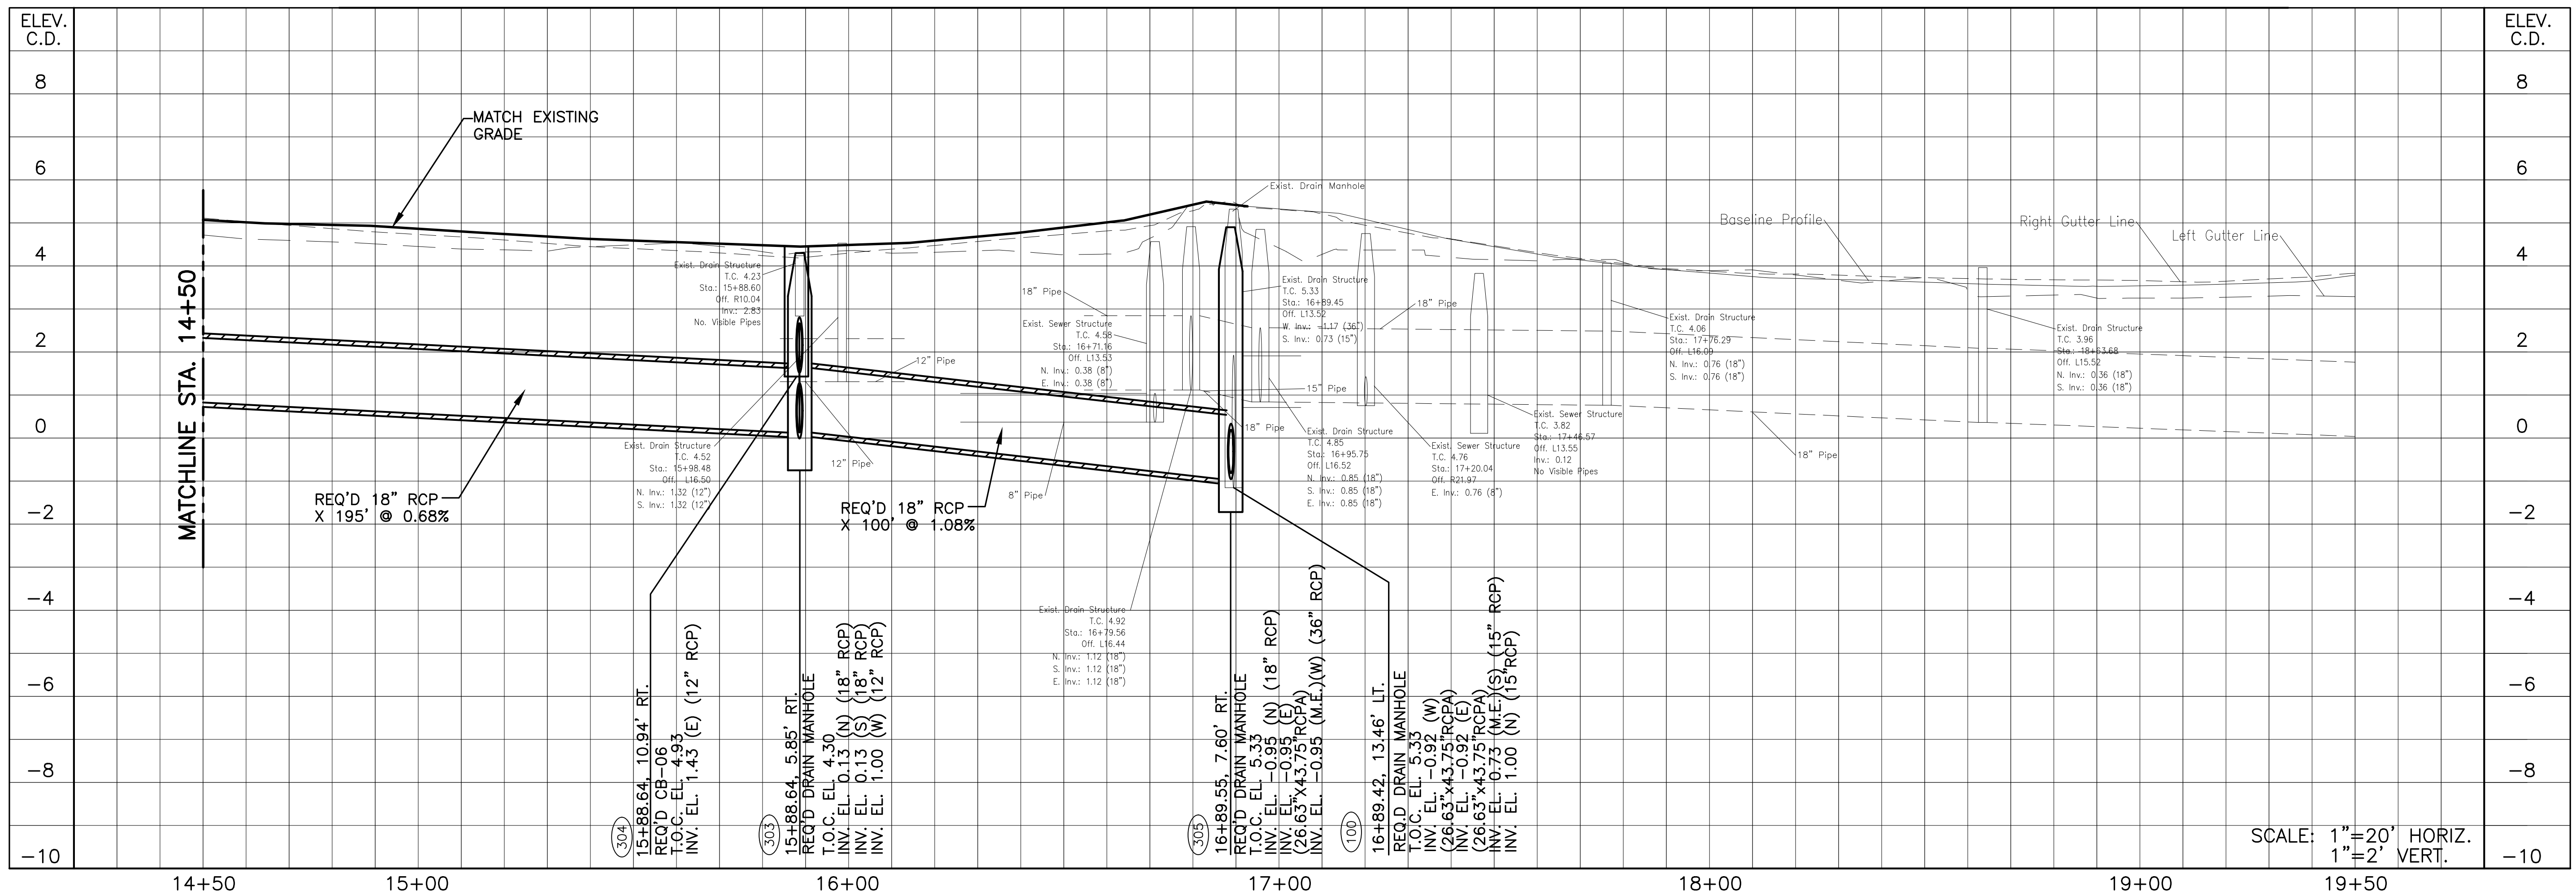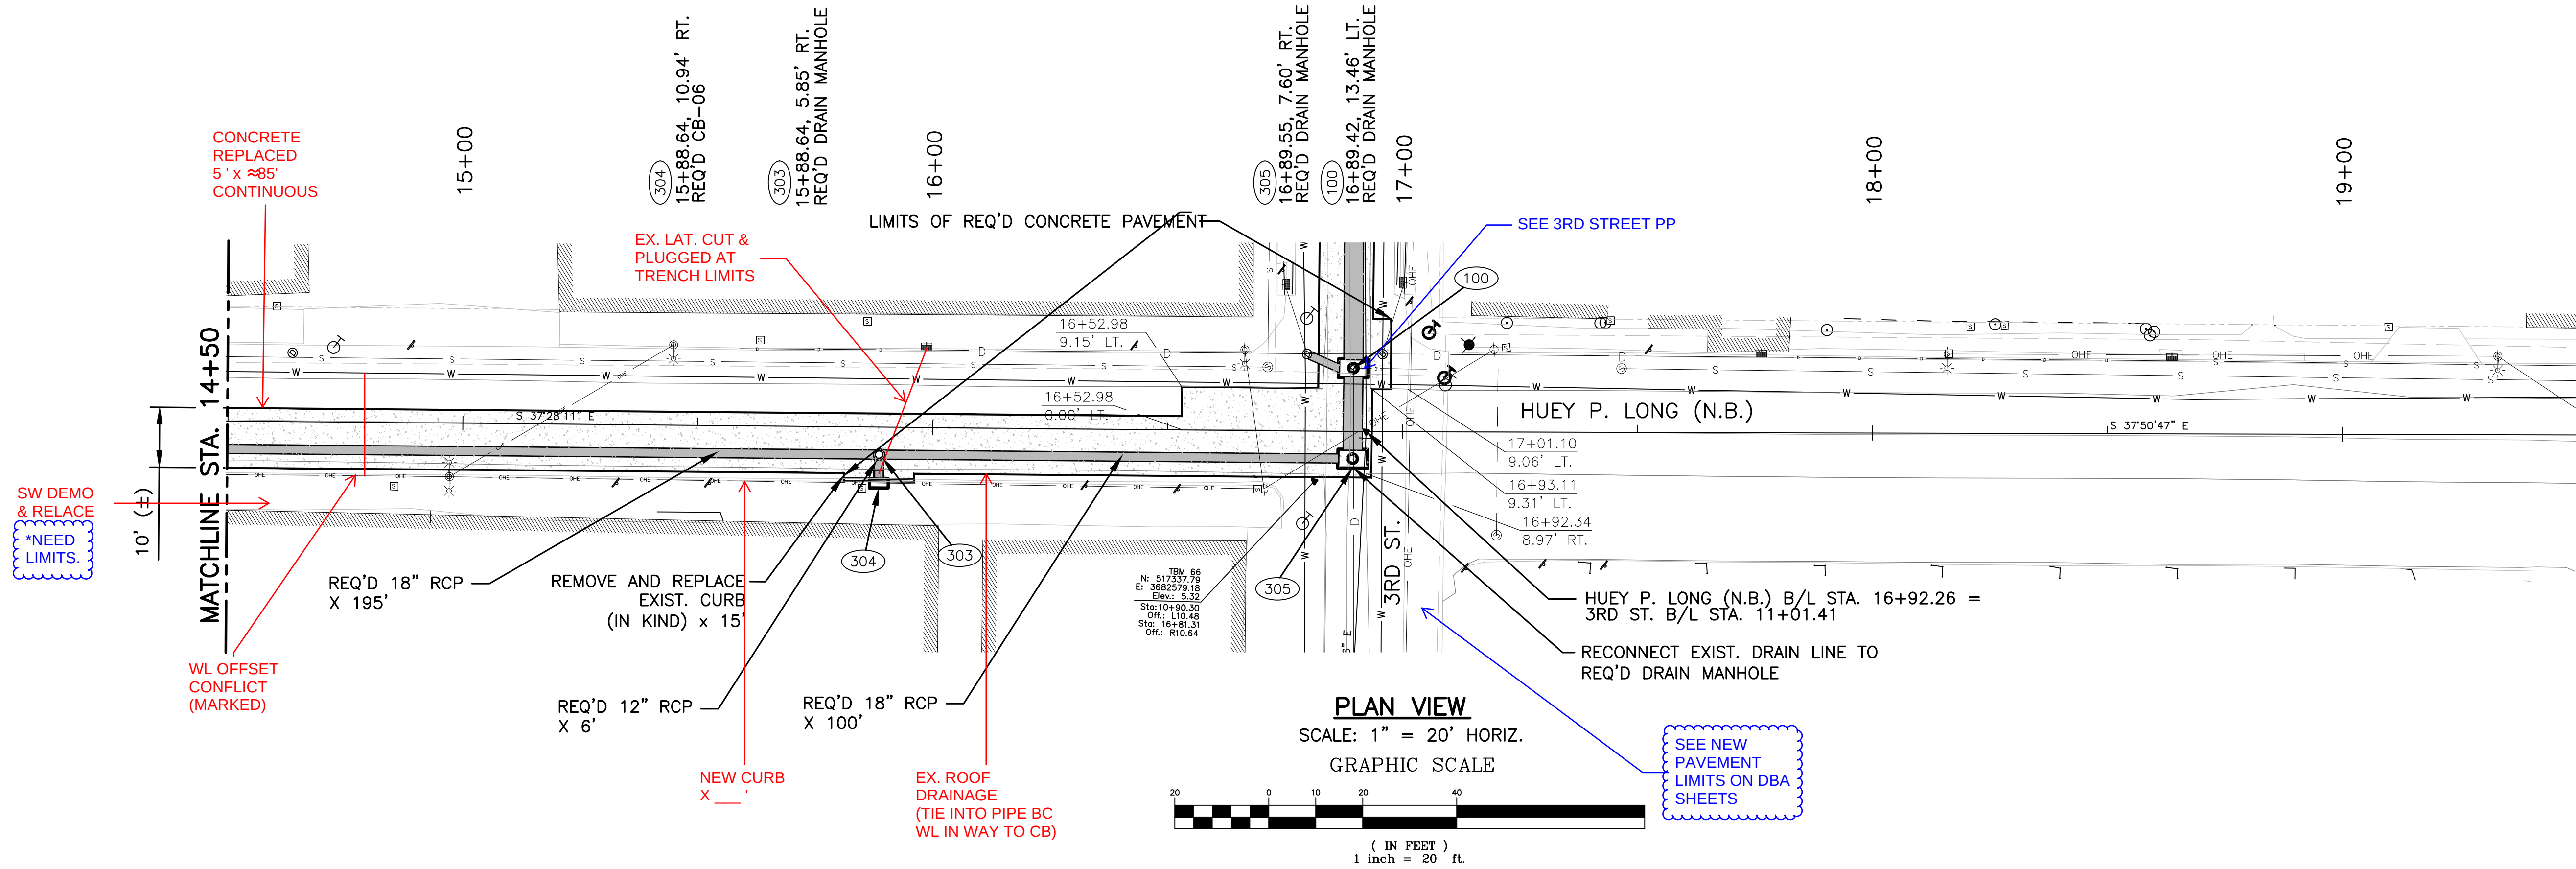

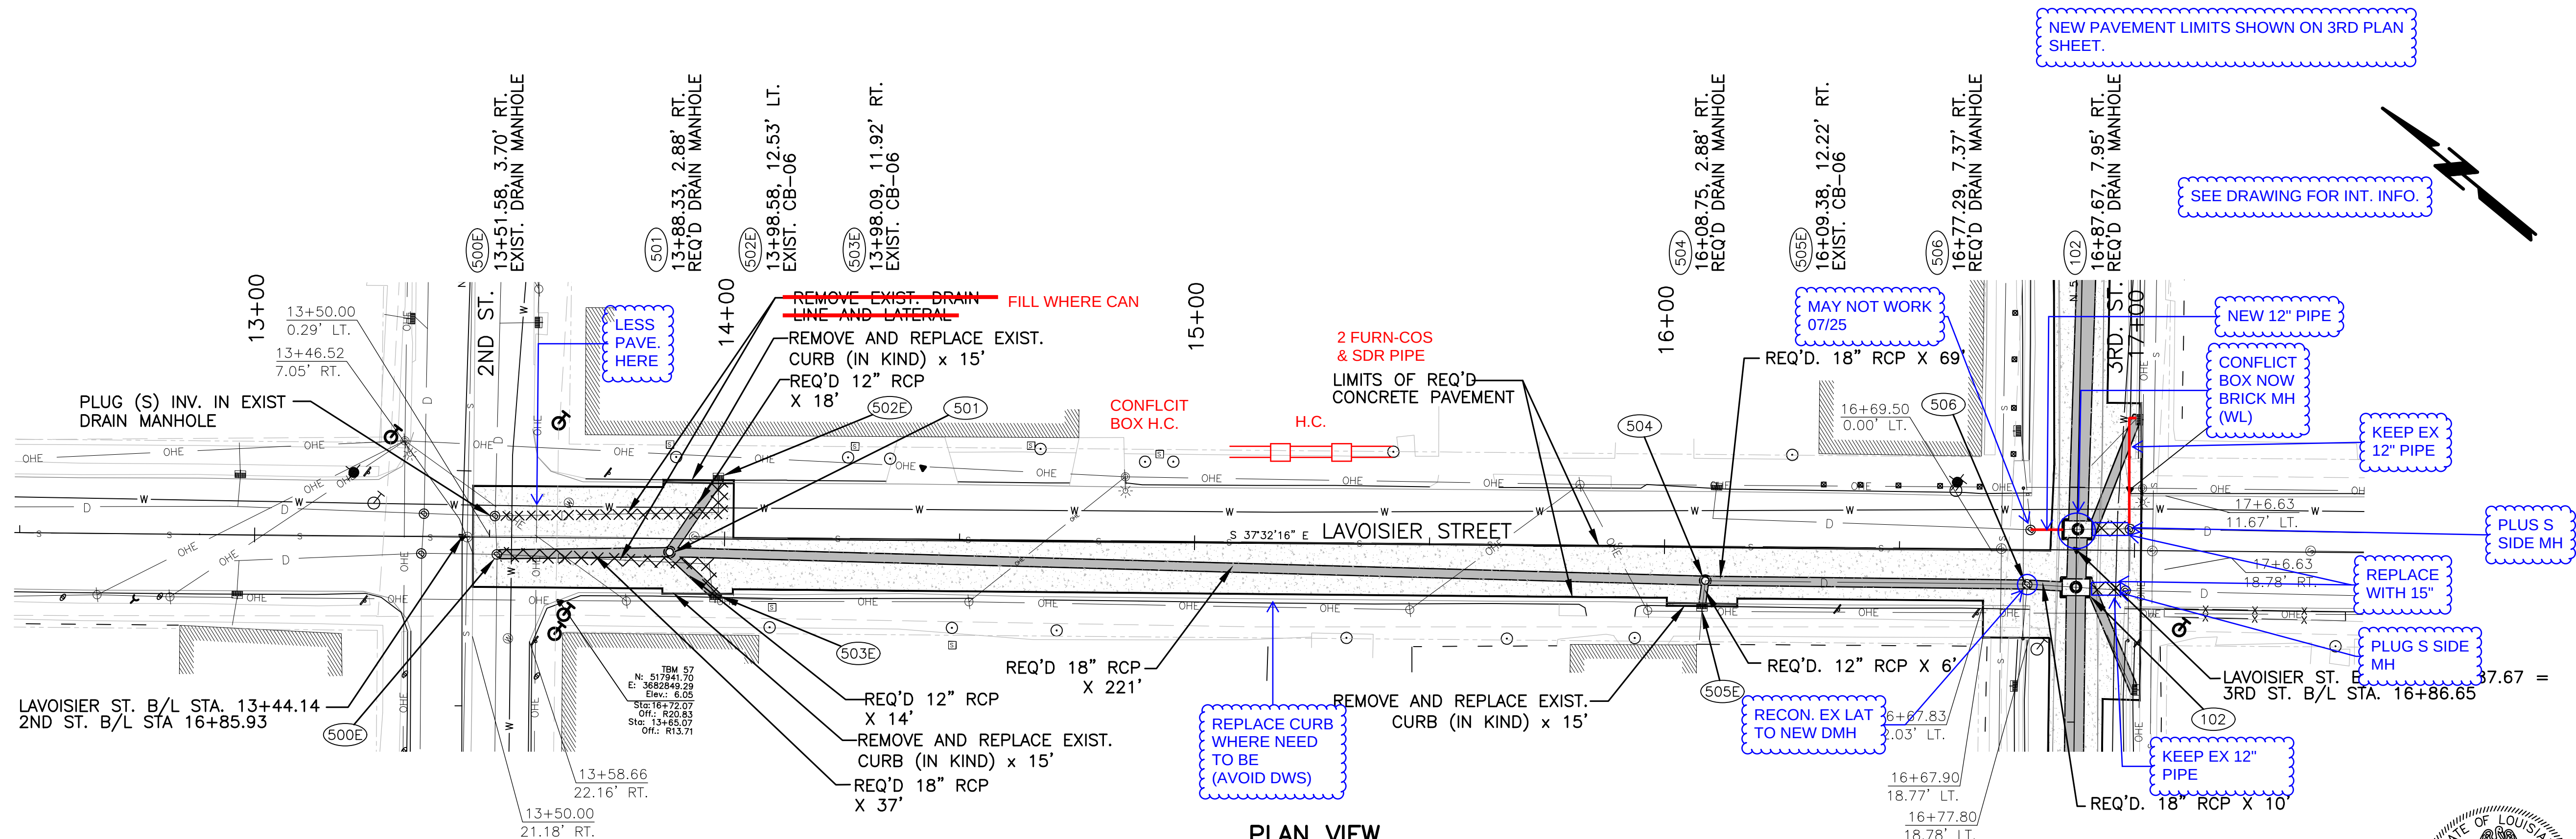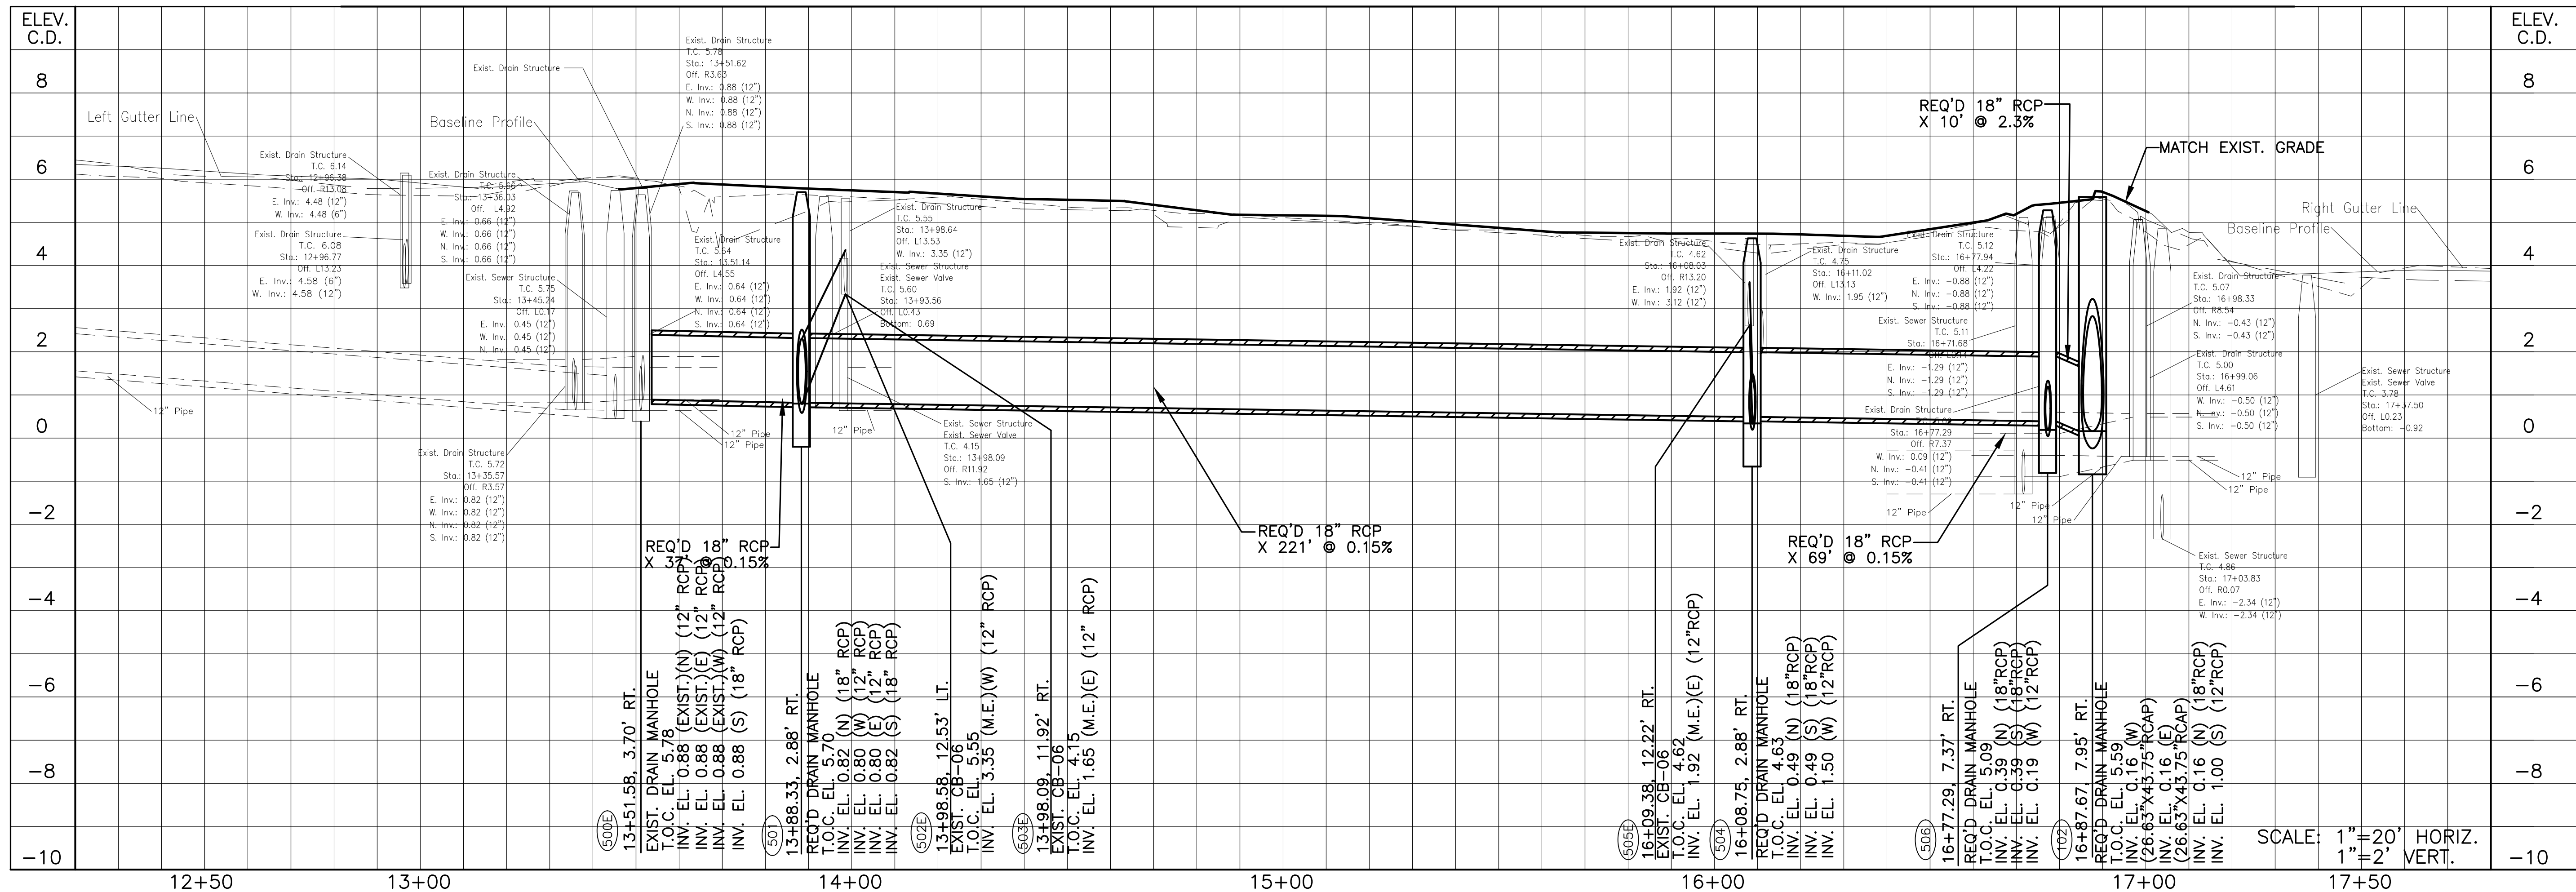

PLAN VIEW
SCALE: 1" = 20' HORIZ.
GRAPHIC SCALE

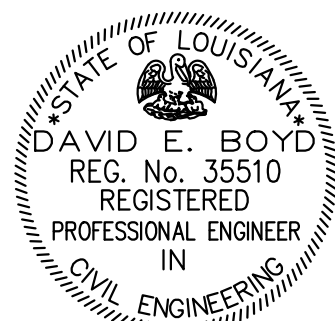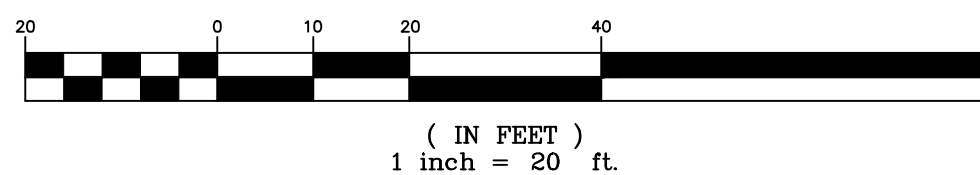



GRETTA DOWNTOWN DRAINAGE IMPROVEMENTS (PHASE 2) WATER & SEWER FORCE MAIN STANDARD DETAILS

BKI BURK-KLEINPETER, INC.
ENGINEERS, ARCHITECTS, PLANNERS, ENVIRONMENTAL SCIENTISTS
1100 GRIFFIN DRIVE, SUITE 100, NEW ORLEANS, LA 70115-5994
PHONE (504)486-3901 • FAX (504)486-1714
BKI JOB # - 9344-8320 BASE BID

DESIGNED	R.P.	CHECKED	D.B.	DATE	DEC., 2021
DETAILED	S.G.	CHECKED	D.B.	SHEET	1 of 9
NO.	DATE	BY	REVISION	DESCRIPTION	

COVER SECTION
N.T.S.

FRAME COVER
N.T.S.

MANHOLE COVER
N.T.S.

TYPICAL VERTICAL < UNDER > OR HORIZONTAL OFFSET DETAILS
FOR WATER AND SEWER FORCE MAINS
N.T.S.

TYPICAL VERTICAL < OVER > OFFSET DETAILS
FOR WATER AND SEWER FORCE MAINS
N.T.S.

TOP VIEW
N.T.S.

FRONT VIEW
N.T.S.

SIDE VIEW
N.T.S.

BRICK METER BOX FOR 4' AND LARGER METERS

VALVE MARKER
N.T.S.

TYPICAL AIR VALVE INSTALLATION
N.T.S.

SECTION "A - A"
N.T.S.

BOLLARDS FOR FIRE HYDRANTS
TO PROTECT FROM TRAFFIC
N.T.S.

FIRE HYDRANT ASSEMBLY DETAIL
N.T.S.

VALVE BOX MANDREL COVER FOR TRAFFIC AREAS
N.T.S.

VALVE BOX DETAIL (ON TRAFFIC AREA)
N.T.S.

MIN. COVER	PIPE SIZE (IN.)
3 FT.	8-10
4 FT.	>10

TRENCH DETAIL
N.T.S.

WATER AND SEWER FORCE MAIN STANDARD TRENCH DETAIL
FOR D.I., PVC-C900, PVC-C905 AND HDPE (MIN. THICKNESS, DR17) PIPES
N.T.S.

NOTES:

- WHERE GROUND SURFACE OR UNSTABLE TRENCH BOTTOM EXISTS, TRENCH BOTTOM SHALL BE STABILIZED (ASTM D3282) TO PROVIDE A WORKING SURFACE.
- TRENCH DETAIL SHOWN VULCAN V-1105, MIN. REQUIREMENTS TO SAFEGUARD THE INTEGRITY OF THE WATER LINE INSTALLATION AT HEREIN-SPECIFIED DEPTHS. THE CONTRACTOR SHALL PROVIDE SUFFICIENT SHEETING AND BRACING TO MAINTAIN SAFE WORKING CONDITIONS FOR HIS WORKMEN.

THRUST BLOCKING DETAILS
N.T.S.

TEMPORARY BLOW-OFF DETAIL
N.T.S.

TYPICAL FIRE HYDRANT AND VALVE LOCATIONS AT INTERSECTIONS
N.T.S.

CASING RESTRAINT DETAIL
N.T.S.

EXISTING	PROPOSED	LEGEND:	DESCRIPTION
		TEE, VALVE AND FIRE HYDRANT ASSEMBLY, FLANGED OR RESTRAINED MECHANICAL JOINT	
		BUTTERFLY VALVE	
		CROSS	
		TEE	
		TAPPING SLEEVE AND VALVE	
		REDUCER	
		BEND	

ORIGINAL 05/21/96

JEFFERSON PARISH DEPARTMENT OF ENGINEERING

WATER AND SEWER FORCE MAIN STANDARD DETAILS

REVISION	BY	DATE	REVISION	BY	DATE
03/07/12	J.C.	03/07/12	05/21/96	H.J.W.	02/20/03
01-08-15	P.D.	02/09/04	02/09/04	H.J.W.	02/11/04
12-28-17	CHS	03/12/07	03/12/07	R.M.	08/24/09
		01/30/09	01/30/09	CHS	08/24/09

FILE NUMBER 1746D

WATER1(2000).DWG









PRECAST METER BOX OPTION SPECIFICATIONS:

- SELF-CONSOLIDATING CONCRETE CONTAINING ADMIXTURES MEETING ASTM C494 TYPE II TO ENSURE UNIFORM SUSPENSION OF AGGREGATES THROUGHOUT.
- CONCRETE STRENGTH - 5,000 PSI (MIN.) @28 DAYS.
- REINFORCING STEEL: #4.5, AND 6 BAR PER ASTM A-615, GRADE 60.
- ASTM-A48 C-35 H-20/AASHTO M-306.
- LIFTING ANCHOR BY A.L.PATTERSON, INC. MODEL UA64G (OR APPROVED EQUAL) WITH MINIMUM SAFE WORKING LOAD OF 4,460 LBS PER ANCHOR.
- SHOP DRAWINGS MUST BE SUBMITTED TO JEFFERSON PARISH FOR APPROVAL.


Meter Size	Approximate Meter Length (In.)	Approximate Strainer Length (In.)	Min. A (In.)	Min. B (In.)	Min. C (In.)	Min. L (In.)	Min. L (Ft. - In.)
4"	20	20	20	30	30	98	8'-2"
6"	24	24	24	30	30	116	9'-8"
8"	30	30	30	40	30	143	11'-11"

PLAN OF DRAINAGE MANHOLE

N.T.S.

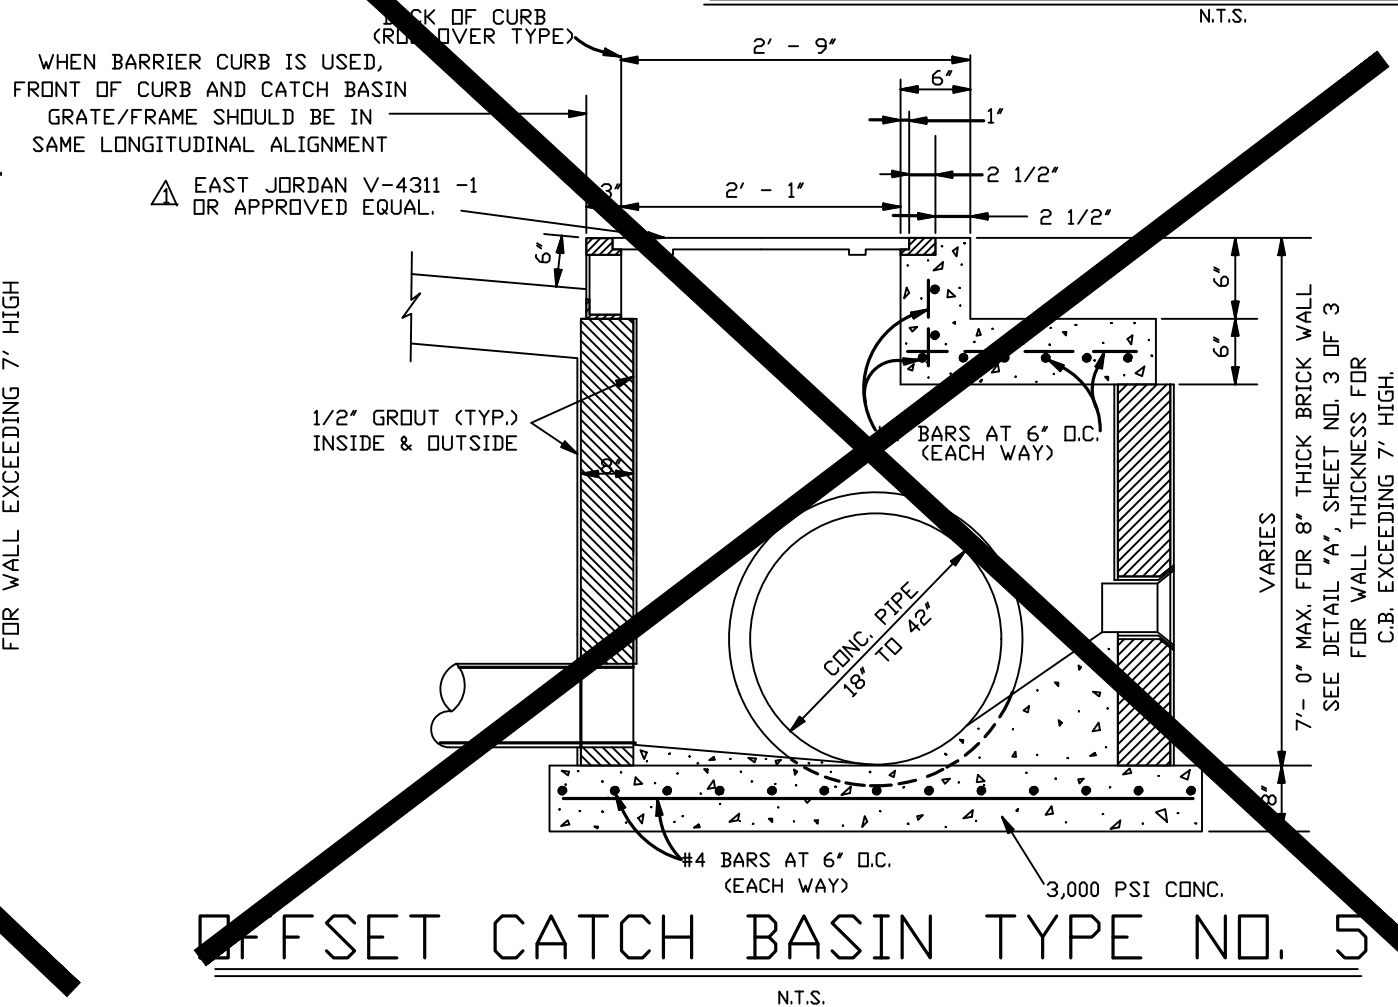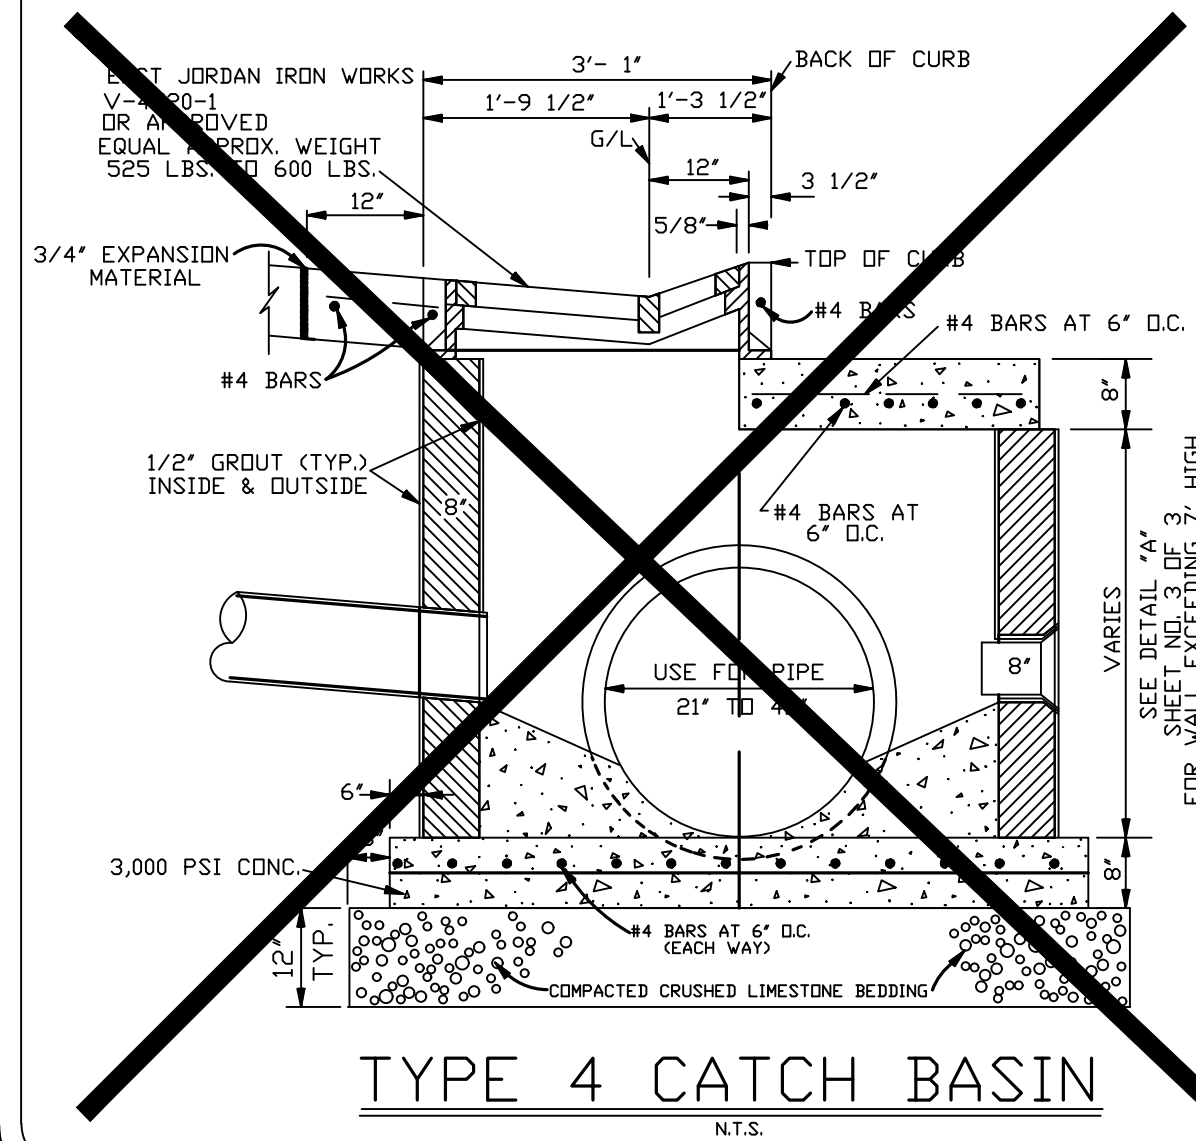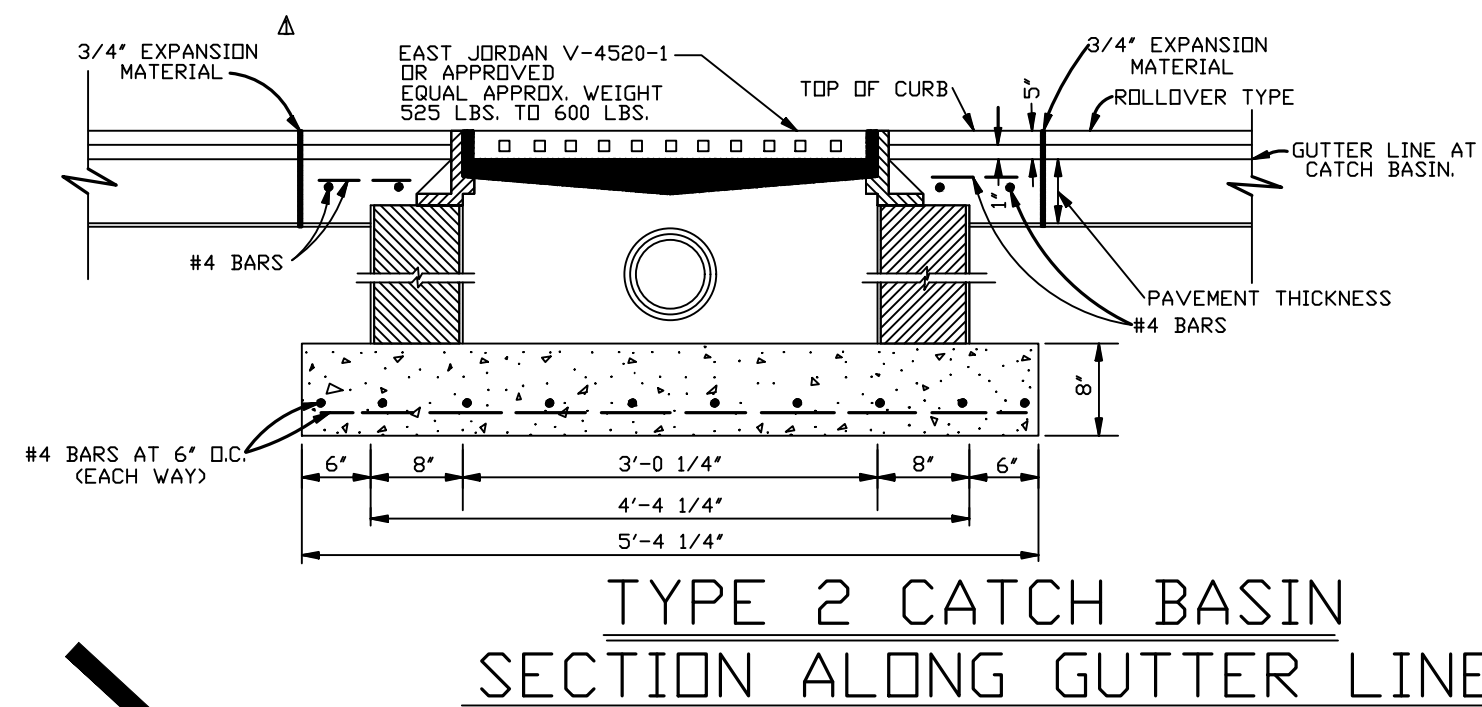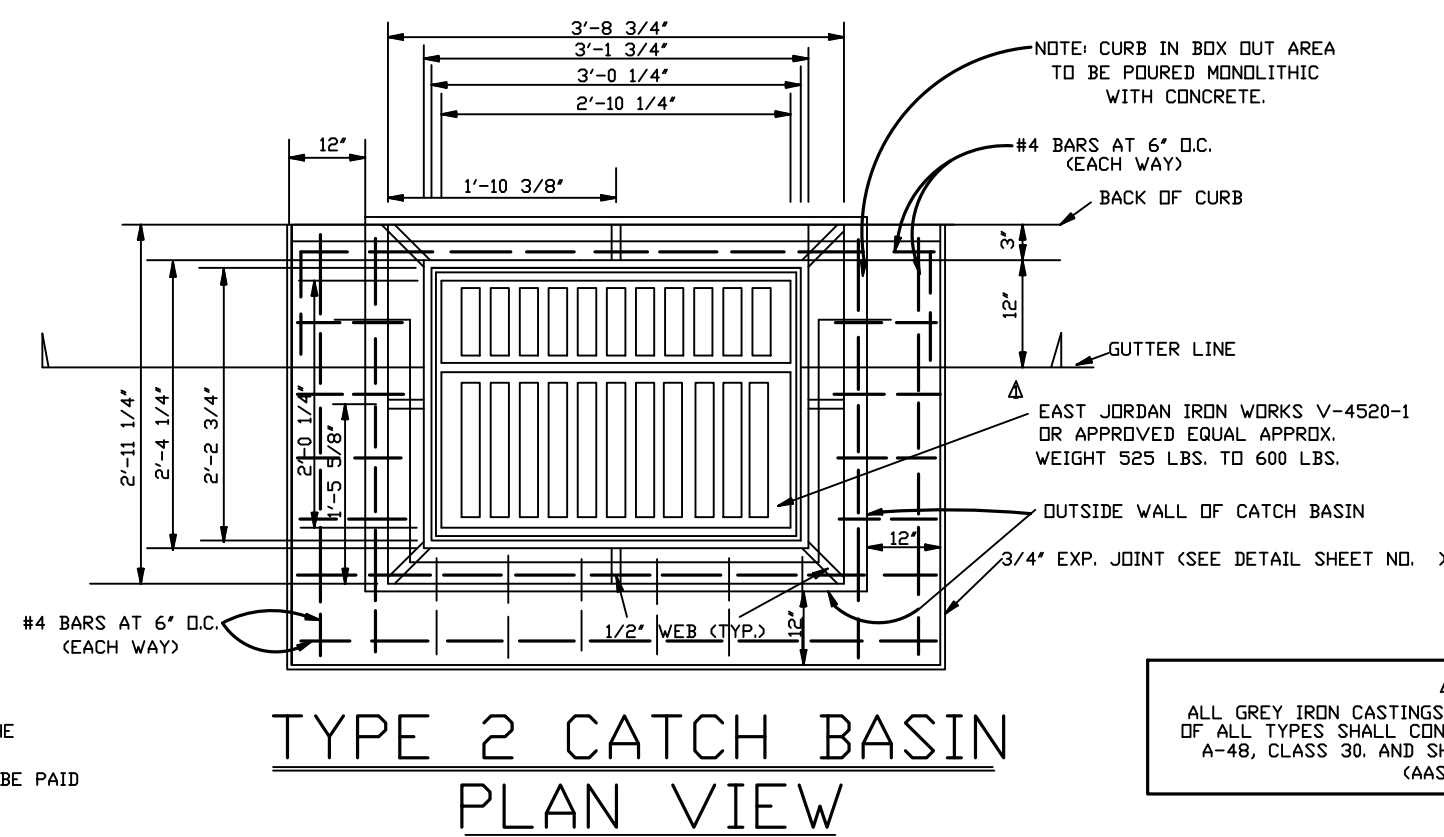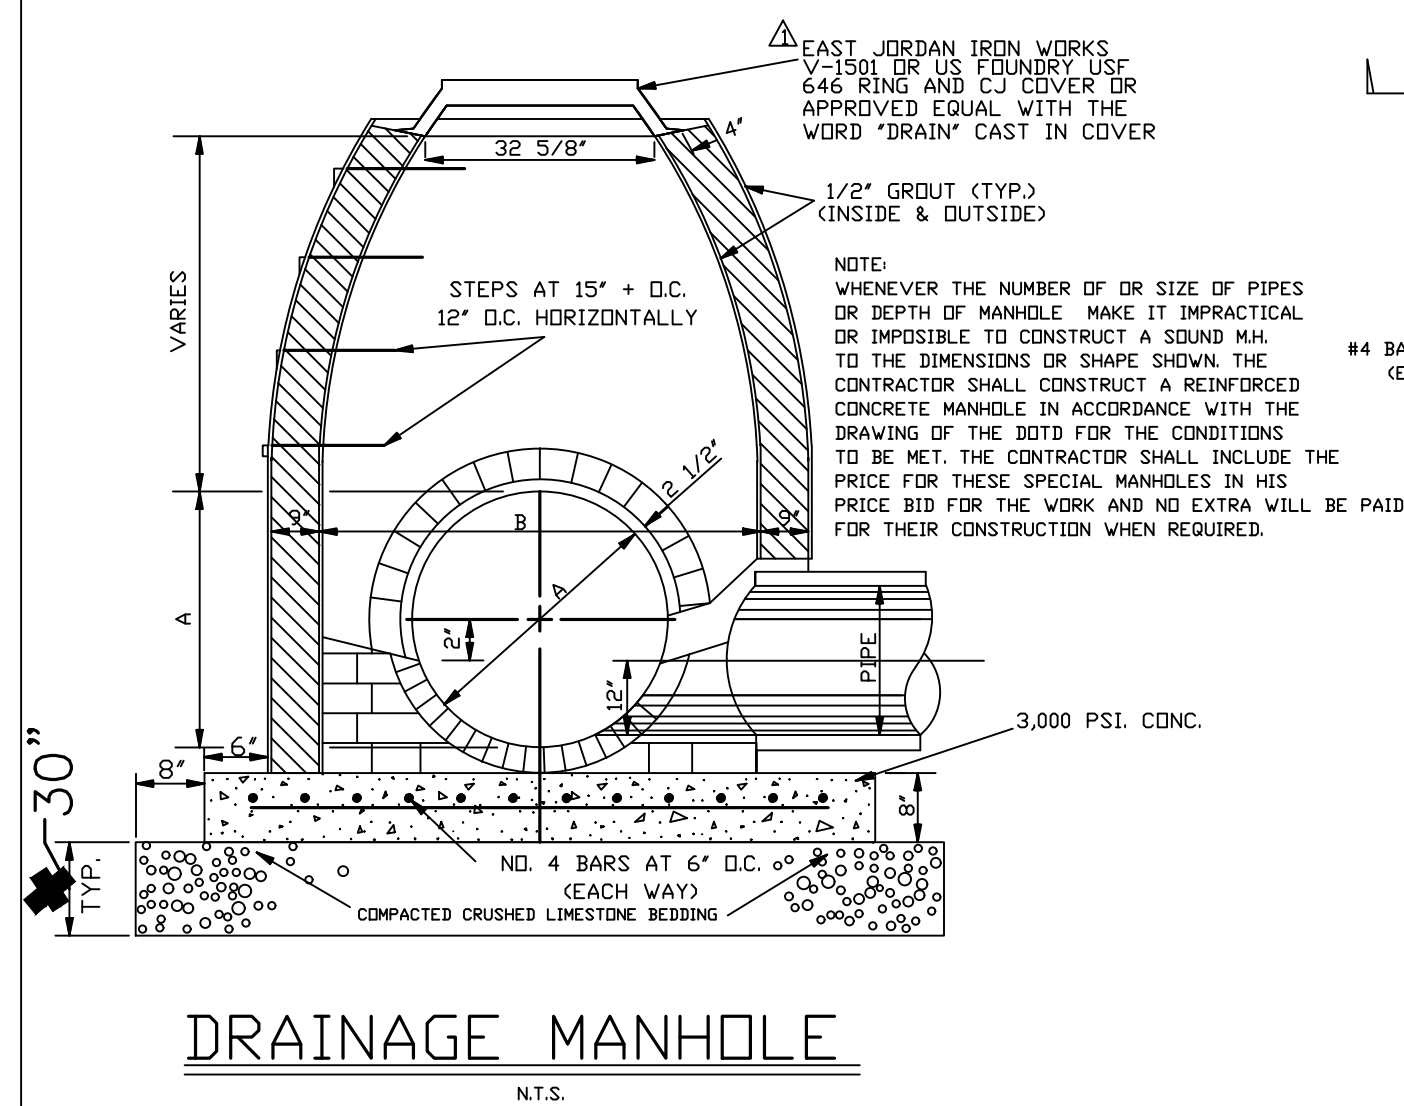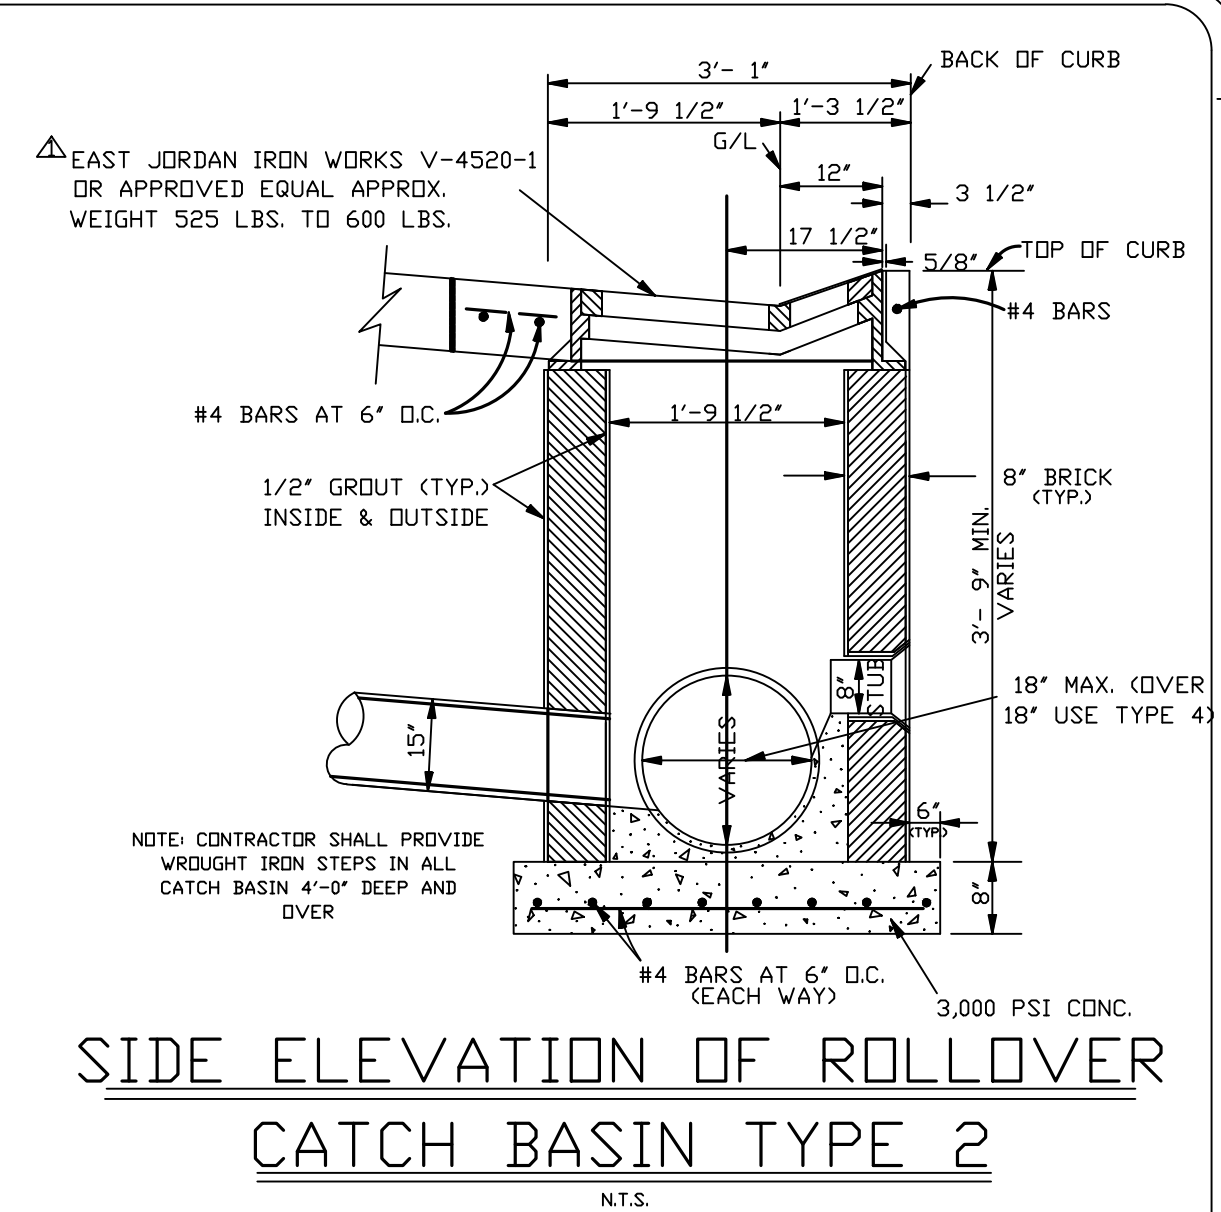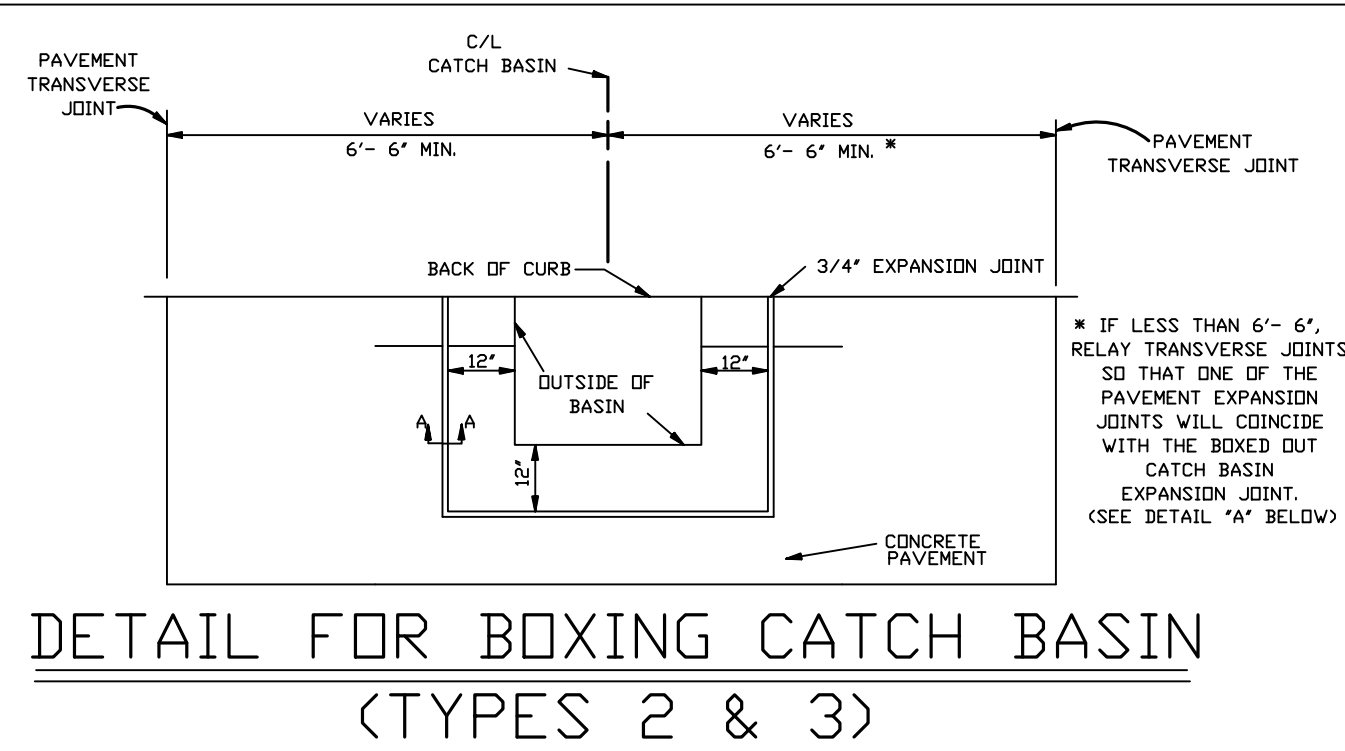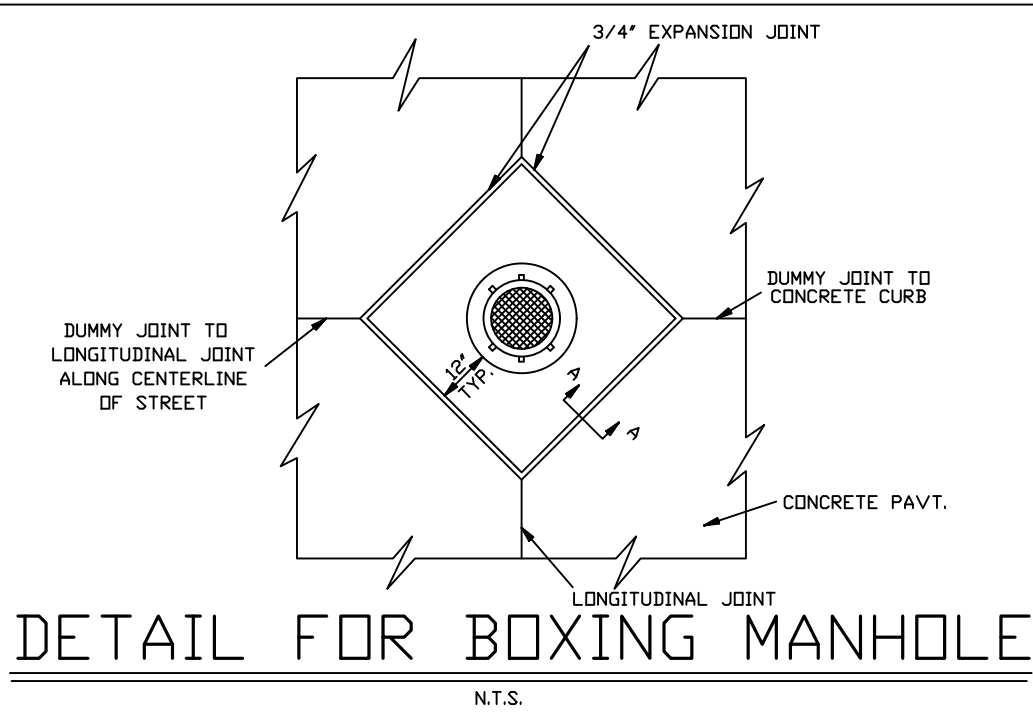

CANAL DISCHARGE PIPE CHART (C.S.P.)				
R.C.P. NOM. DIA.	WALL THICKNESS	R.C.P. I.D.	REQ'D C.S.P. I.D.	GAGE REQ'D
12"	2"	16"	16.5"	△ 14
15"	2.25"	19.5"	20"	△ 12
18"	2.5"	23"	23.5"	△ 12
21"	2.75"	26.5"	27"	△ 12
24"	3"	30"	30.5"	△ 12
27"	3.25"	33.5"	34"	△ 12
30"	3.50"	37"	37.5"	△ 12
36"	4"	44"	44.5"	△ 12
42"	4.5"	51"	51.5"	△ 12
48"	5"	58"	58.5"	△ 12
54"	5.5"	65"	65.5"	× 12
60"	6"	72"	72.5"	× 12
66"	6.5"	79"	79.5"	× 12
72"	7"	86"	86.5"	× 12
78"	7.5"	93"	93.5"	× 12
84"	8"	100"	100.5"	× 12
90"	8.5"	107"	107.5"	× 12
96"	9"	114"	114.5"	× 12

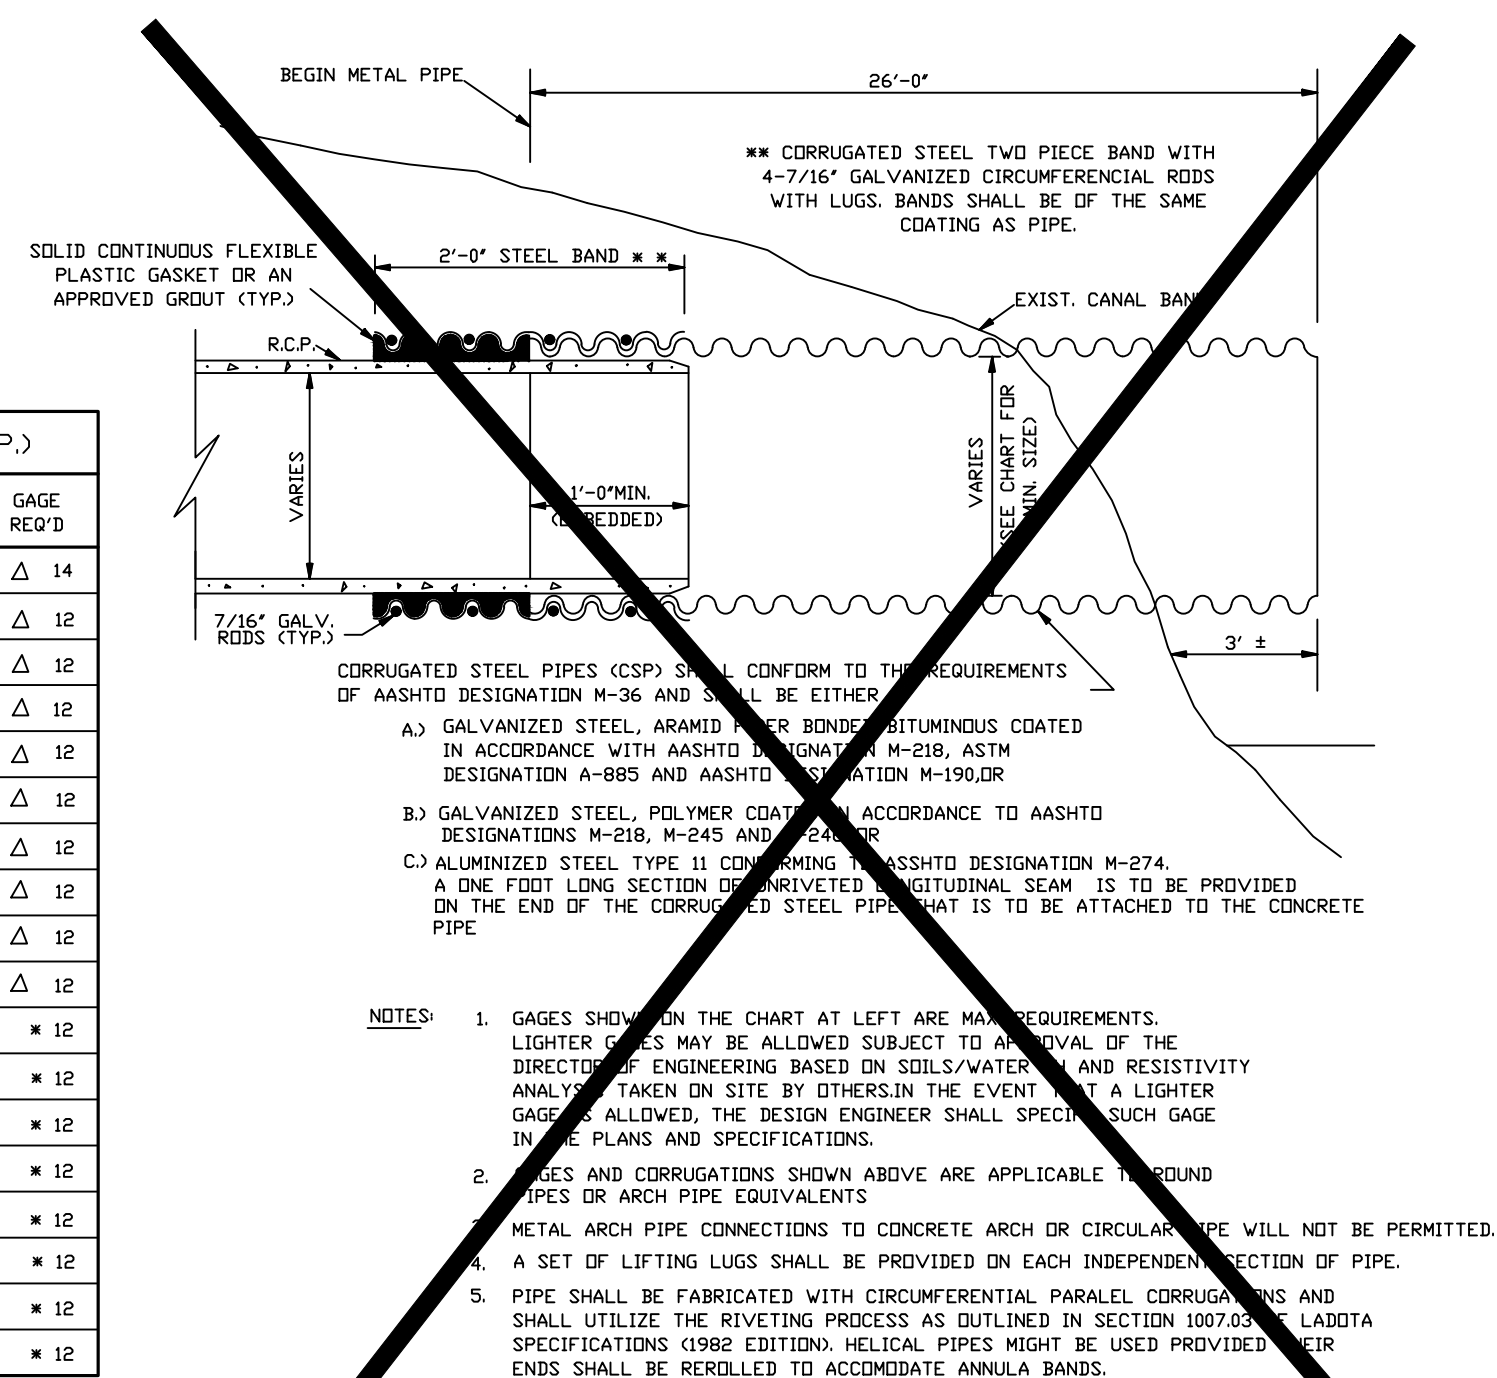

POLICY STATEMENT


REQUIRED TECHNICAL INFORMATION FOR DRAINAGE DITCHES
OR CANALS WHICH ABUT OR LIE IN THE PROPOSED SUBDIVISIONS





1. FURNISH A MINIMUM OF TWO (2) CROSS-SECTIONS, ONE AT THE UPSTREAM AND THE OTHER AT THE DOWNSTREAM OF ALL EXISTING DITCHES OR CANALS. THESE CROSS-SECTIONS SHALL BE TIED-IN WITH THE PROPERTY LINE/LINES.
2. SUPERIMPOSE THE MASTER DRAINAGE PLAN'S RECOMMENDED DITCH OR CANAL CROSS-SECTIONS ON THE EXISTING CROSS-SECTIONS, THEN DELINEATE THE REQUIRED MAINTENANCE SERVITUDE ON BOTH SIDES OF THE CANALS OR DITCHES, THESE SERVITUDES ARE THE DISTANCES BETWEEN PROPERTY LINES AND THE TOP OF THE PROPOSED DITCH OR CANAL BANKS. (20 FEET MINIMUM SERVITUDE FOR THE TOP WIDTH OF A DITCH LESS THAN 35 FEET AND 35 FEET MINIMUM SERVITUDE FOR THE TOP WIDTH OF A CANAL LARGER THAN 35 FEET).
3. IF NO RECOMMENDATIONS ARE GIVEN FOR THE PROPOSED CROSS-SECTIONS OF THE DITCHES OR CANALS IN THE MASTER DRAINAGE PLAN THEN FURNISH THE FOLLOWING INFORMATION:
 - (A). DETERMINE FLOW OF RUN OFF AT THE UPSTREAM REACH OF THE DITCH OR CANAL .
 - (B). CALCULATE RUN OFF GENERATED FROM THE PROPOSED SITE.
 - (C). CALCULATE THE PROPOSED CROSS-SECTIONS FOR THE DITCH OR CANAL BASED ON THE SUM OF THESE FLOWS THEN PROCEED AS STEP 2.
 4. IF THE EXISTING DITCH IS PROPOSED TO BE RELOCATED OR ABANDONED, THEN A SUITABLE CULVERT/CULVERTS SHALL BE SIZED AND AN ADEQUATE MAINTENANCE SERVITUDE SHALL BE SHOWN.
5. IN CALCULATING RUN OFF OR SIZING CULVERTS FOLLOW THE PROCEDURES OUTLINED IN THE JEFFERSON PARISH DRAINAGE DESIGN MANUAL.

CANAL DISCHARGE PIPE
N.T.S.















 JEFFERSON PARISH DEPARTMENT OF ENGINEERING			
DRAINAGE TITLE			
DRAINAGE STANDARD DETAILS			
DRAWN BY	D.J.D.	DATE	12/11/92
REVISION BY	H.J.W.	DATE	03/10/97
	NOF TO AUGMENT		
REVISION BY	P.D.	DATE	12/22/03
REVISION BY	J.C.	DATE	07/11/13
	—	DATE	—
	—	DATE	—
ISSUE	AUTOCAD LT. 2004		VIA DRAIN.DWG
FILE NUMBER		0025	

SHEET NO. 2 OF 3

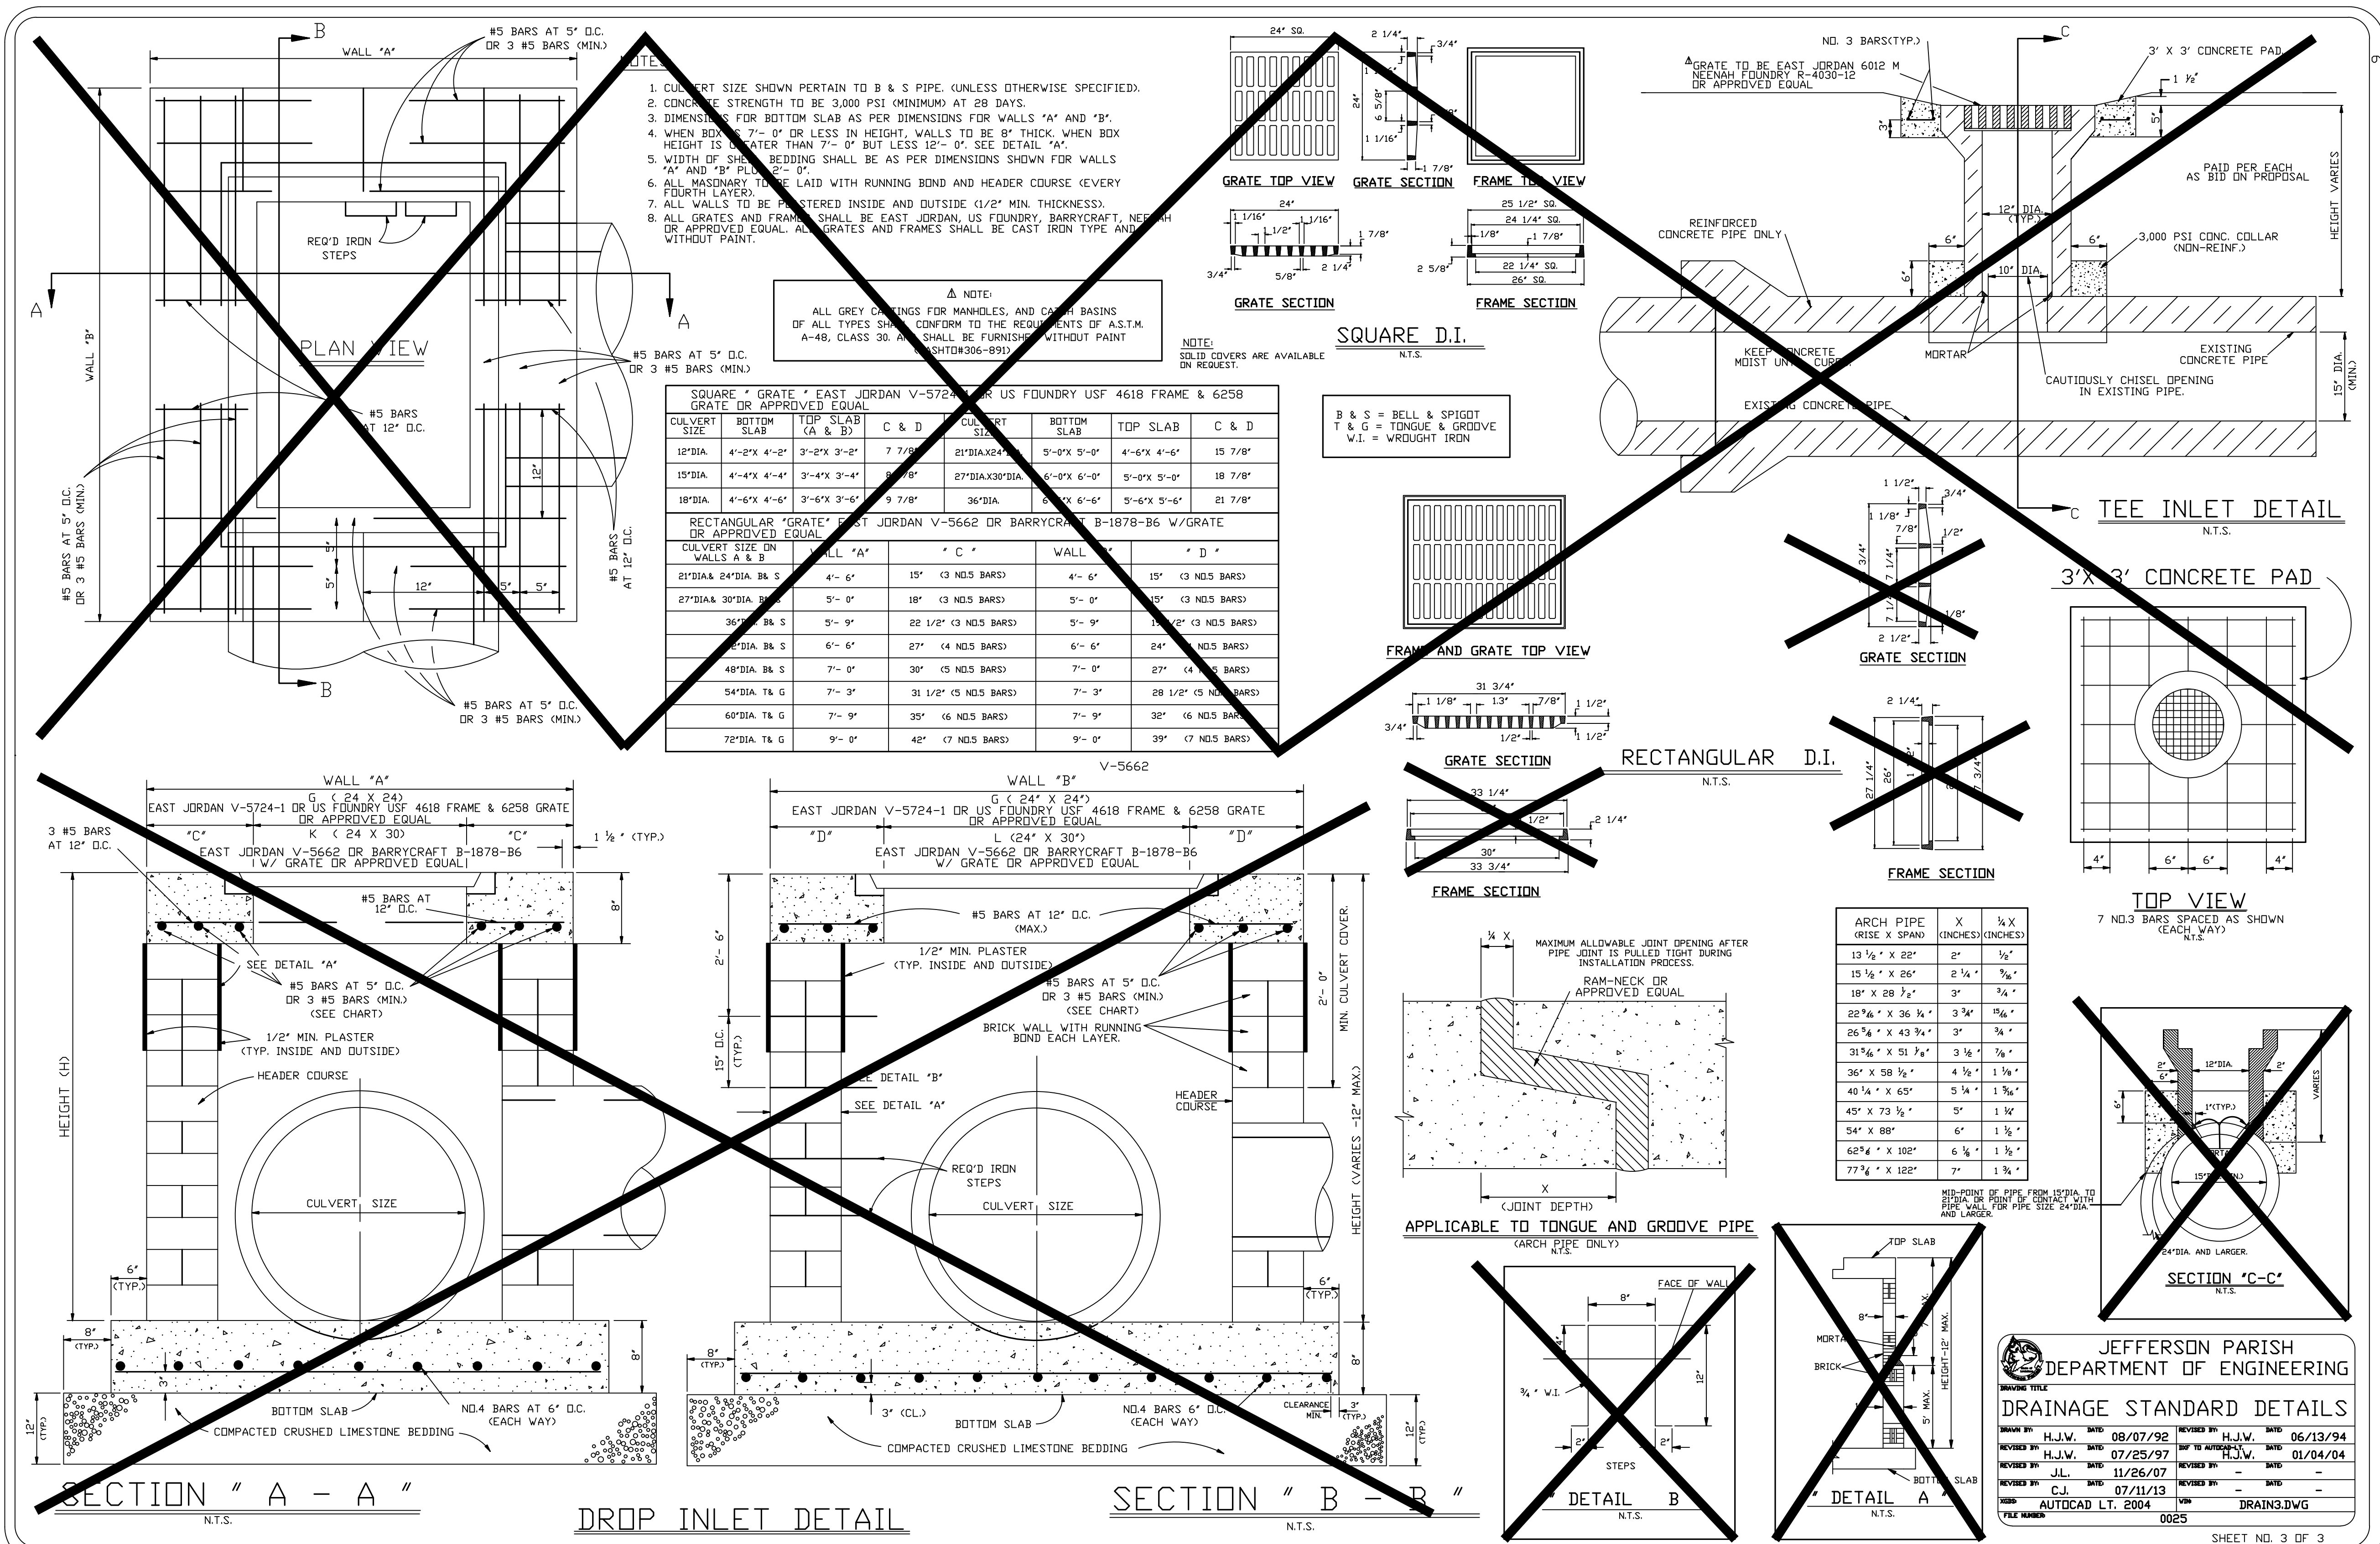

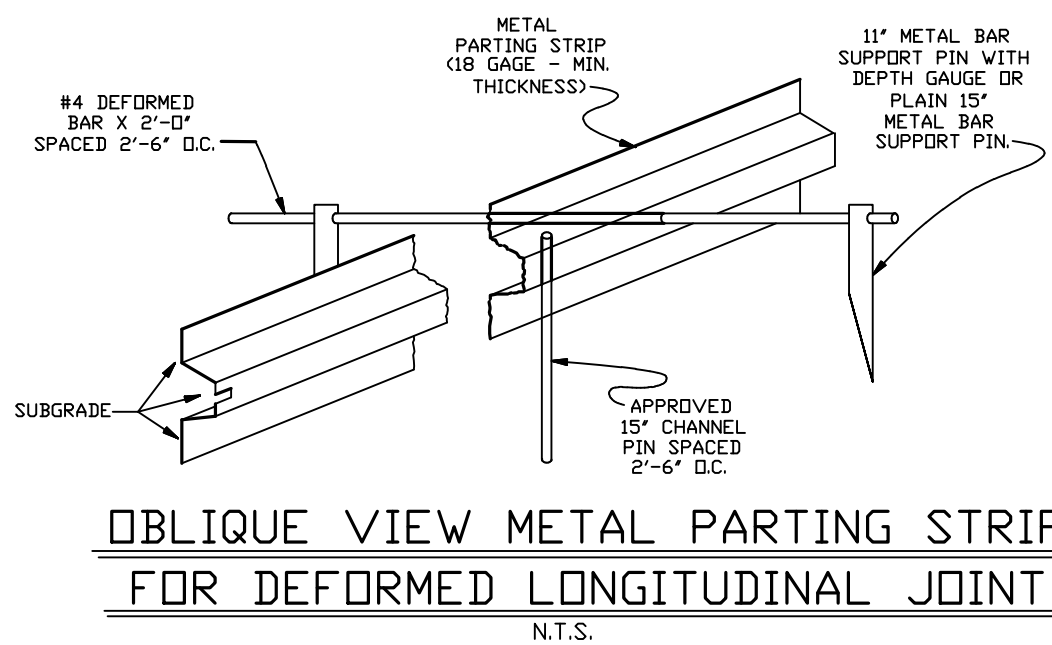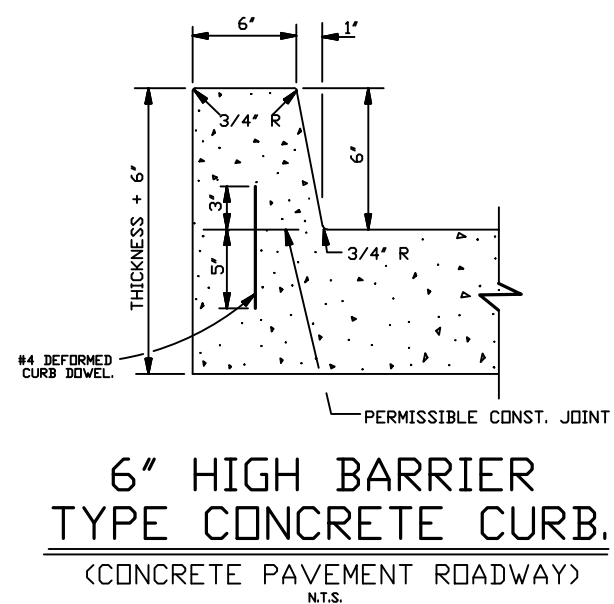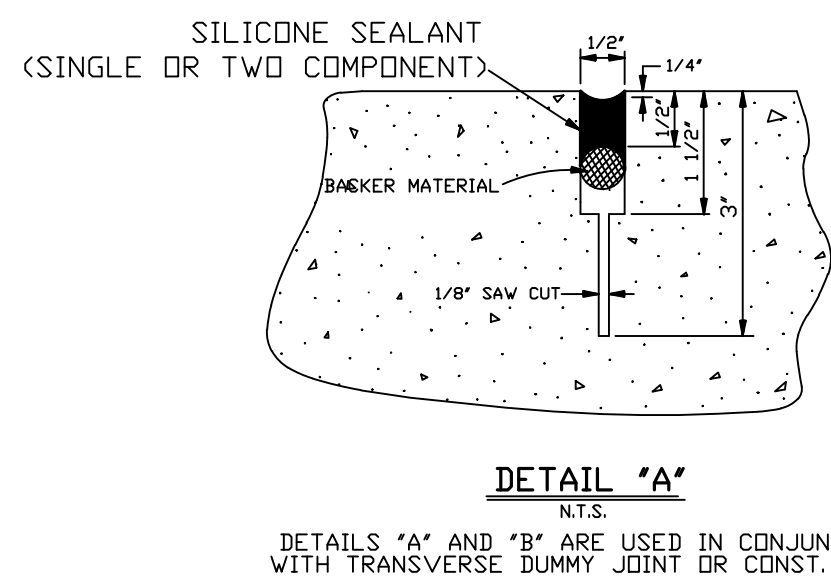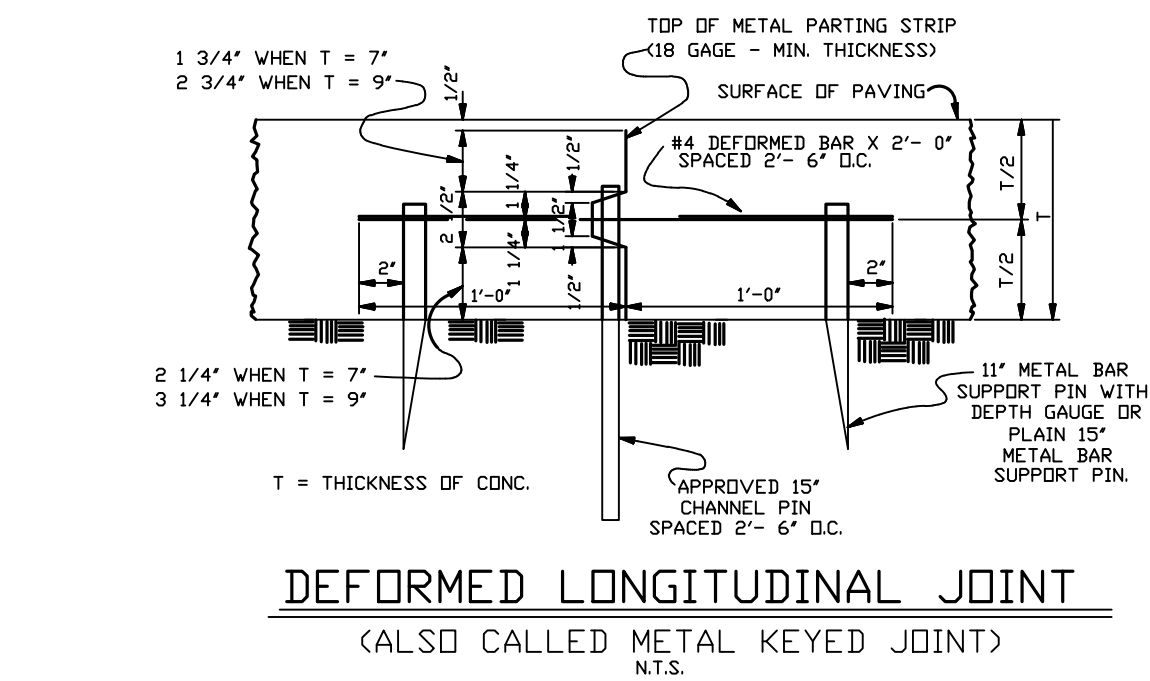

NOTES:
ALL JOINTS FOR CONCRETE PAVEMENT SHOWN IN I.A. D.D.T.D. STANDARD PLANS CP-01 CAN BE USED AT THE REQUEST OF THE ENGINEER WHO SHALL PROVIDE CONSTRUCTION DETAILS TO CONTRACTOR.

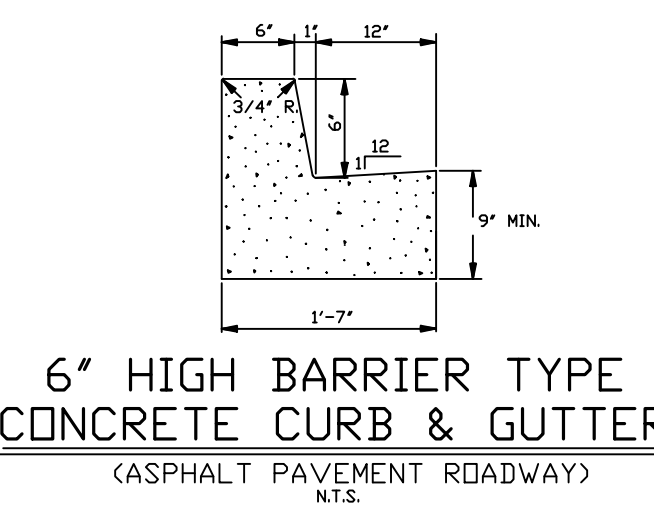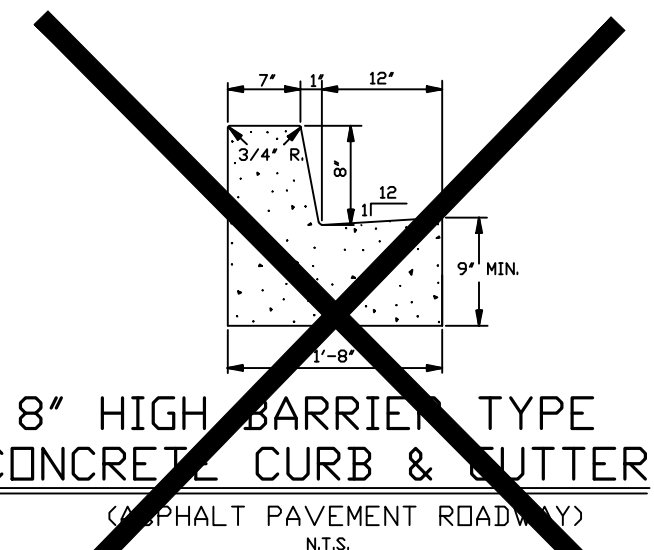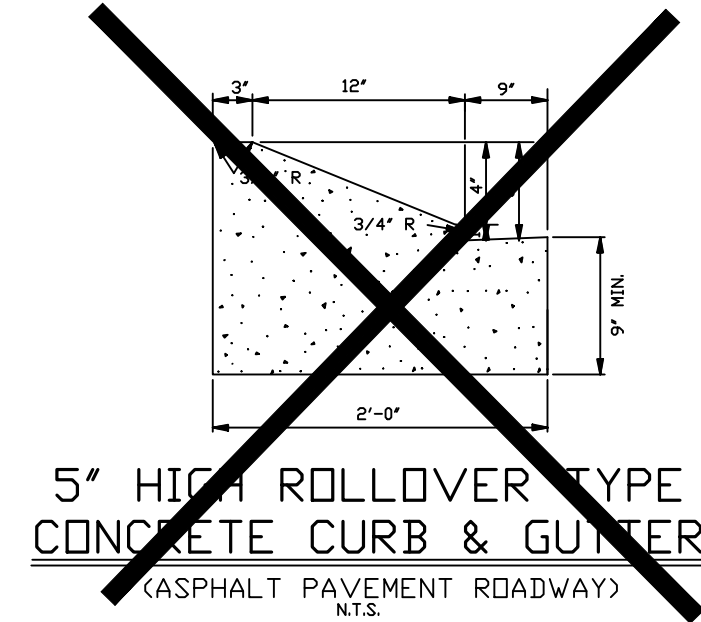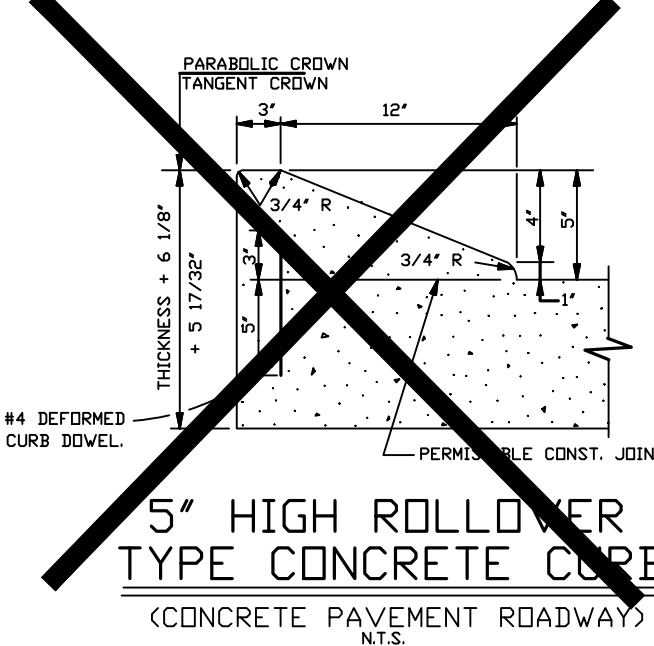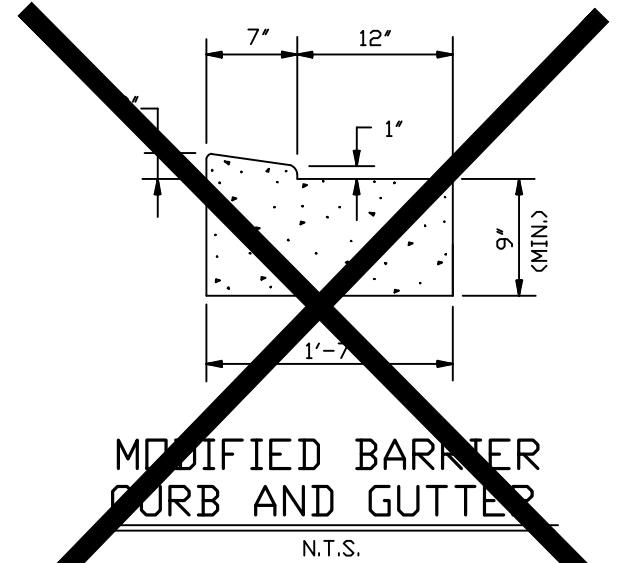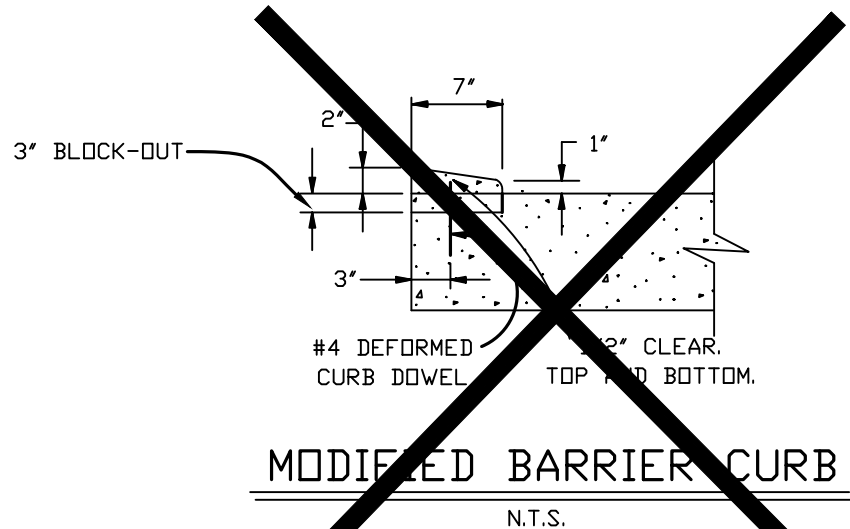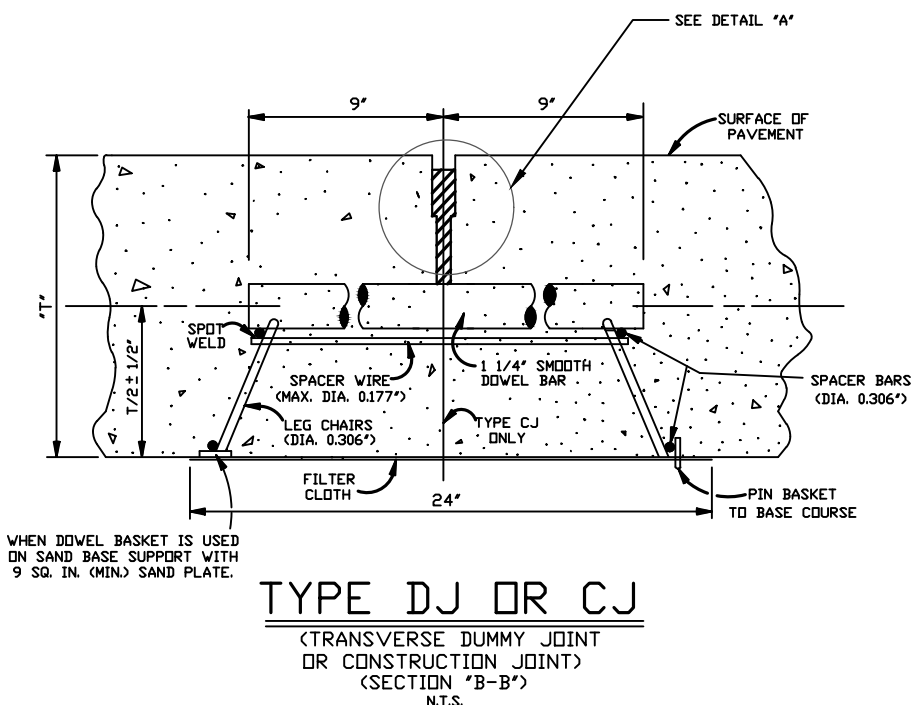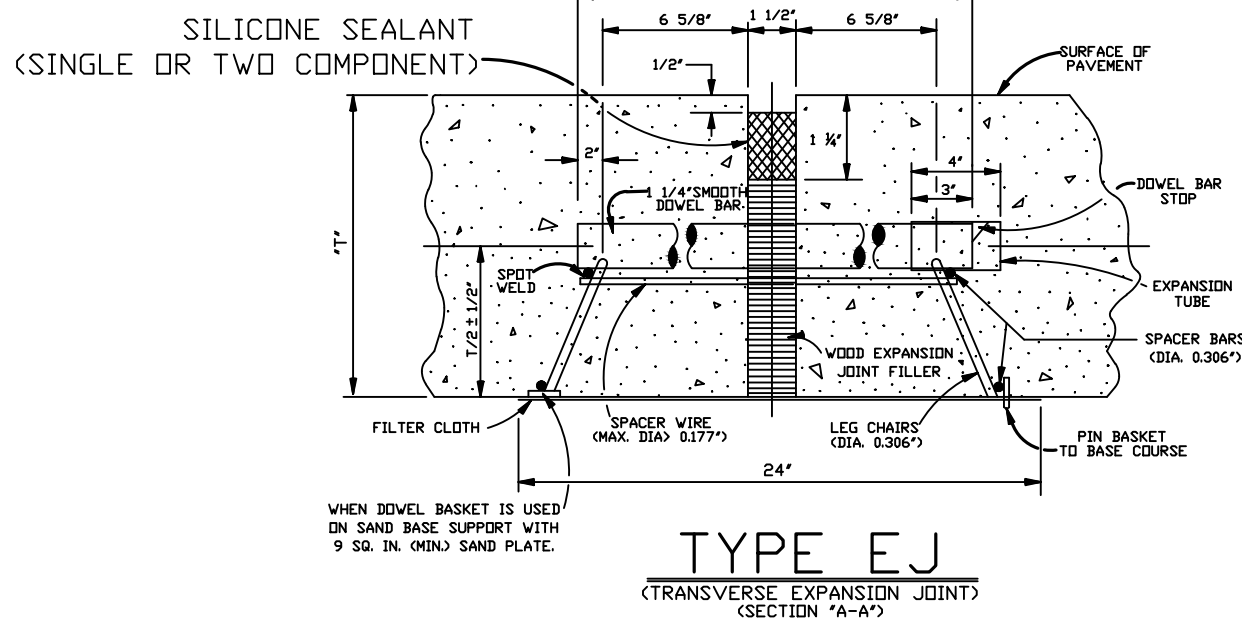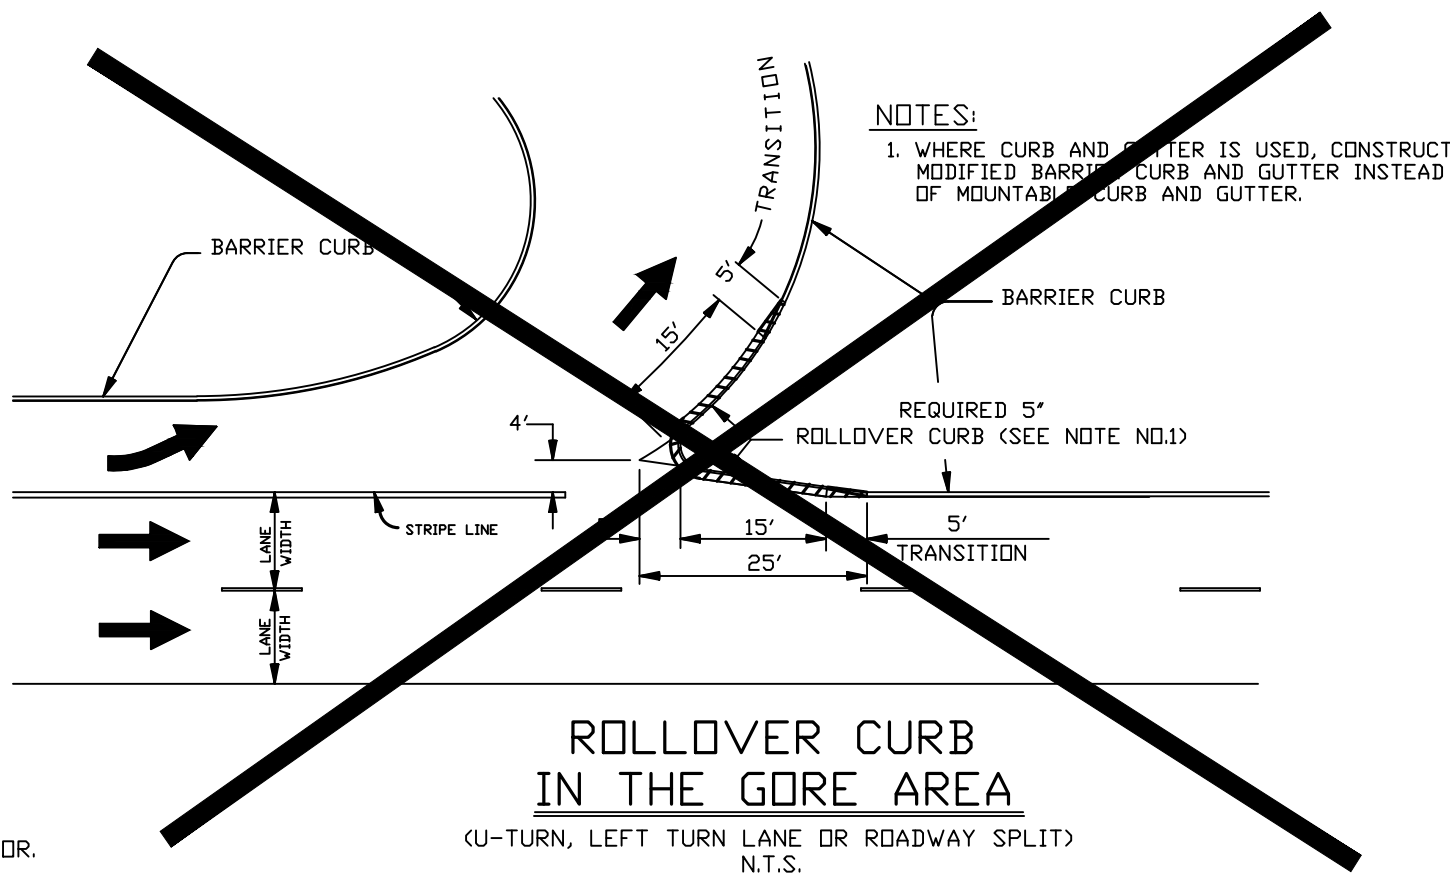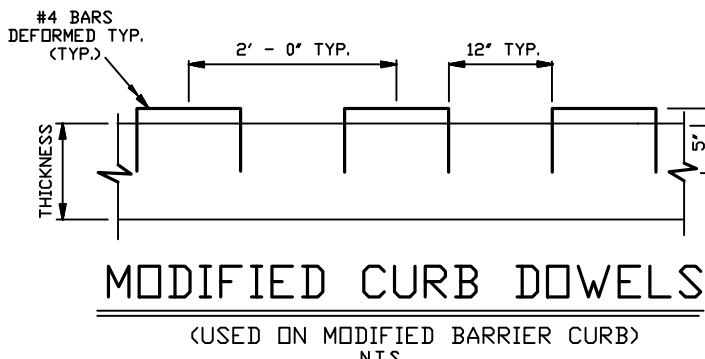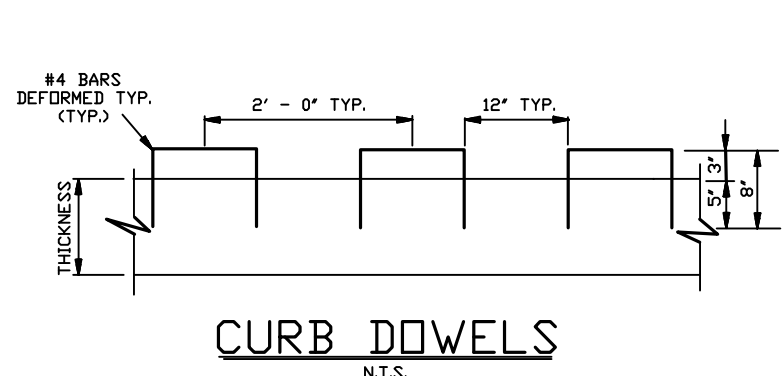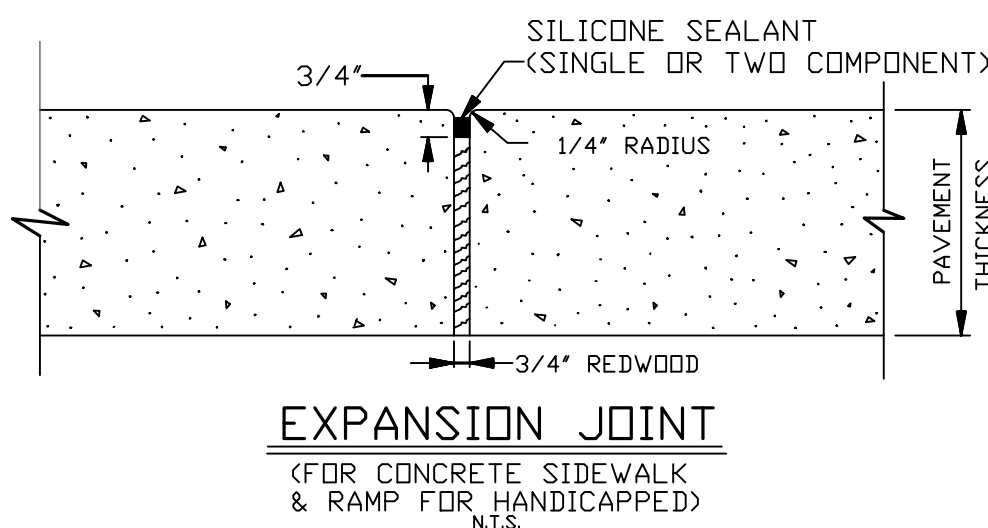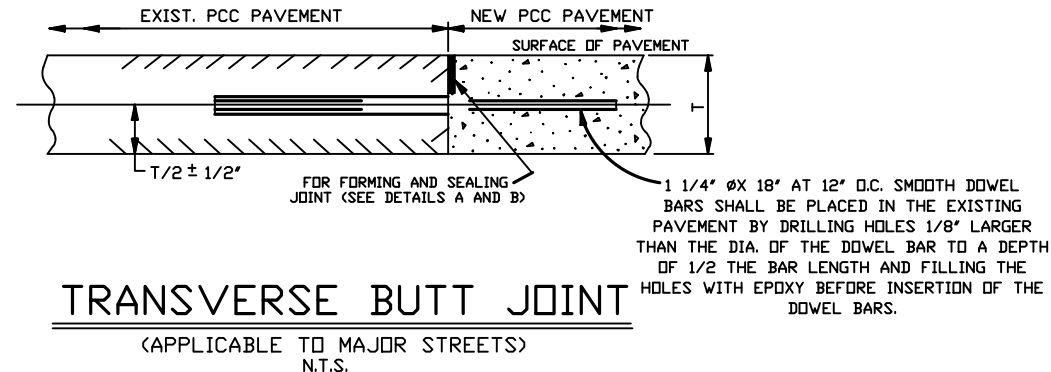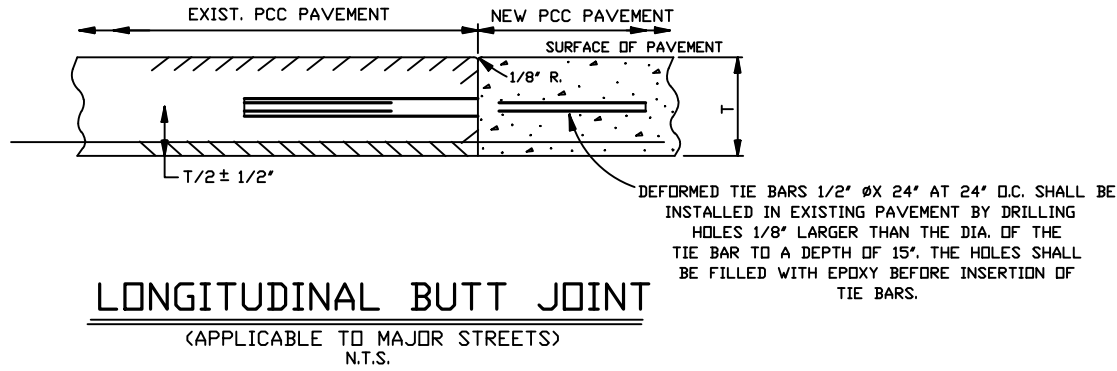


REVISION BY	C.J.	DATE	04/11/13
REVISION BY	C.J.	DATE	09/24/15

JEFFERSON PARISH DEPARTMENT OF ENGINEERING			
DRAWING TITLE TYPICAL ROADWAY DETAILS			
DRAWN BY	W.V.N.	DATE	03/12/91
REVISION BY	P.D.	DATE	10/13/00
REVISION BY	H.J.W.	DATE	08/18/00
REVISION BY	H.J.W.	DATE	01/30/01
REVISION BY	H.J.W.	DATE	05/21/03
REVISION BY	C.J.	DATE	05/13/11
REVISION BY	C.J.	DATE	07/18/12
FILE NUMBER	2925		


SHT 1 OF 2

DESIGNED	R.P.	DATE	DEC., 2021
CHECKED	D.B.	SHEET	5 of 9
DETAILED	S.G.	DATE	
CHECKED	D.B.	DATE	

NO.	DATE	REVISION DESCRIPTION	BY

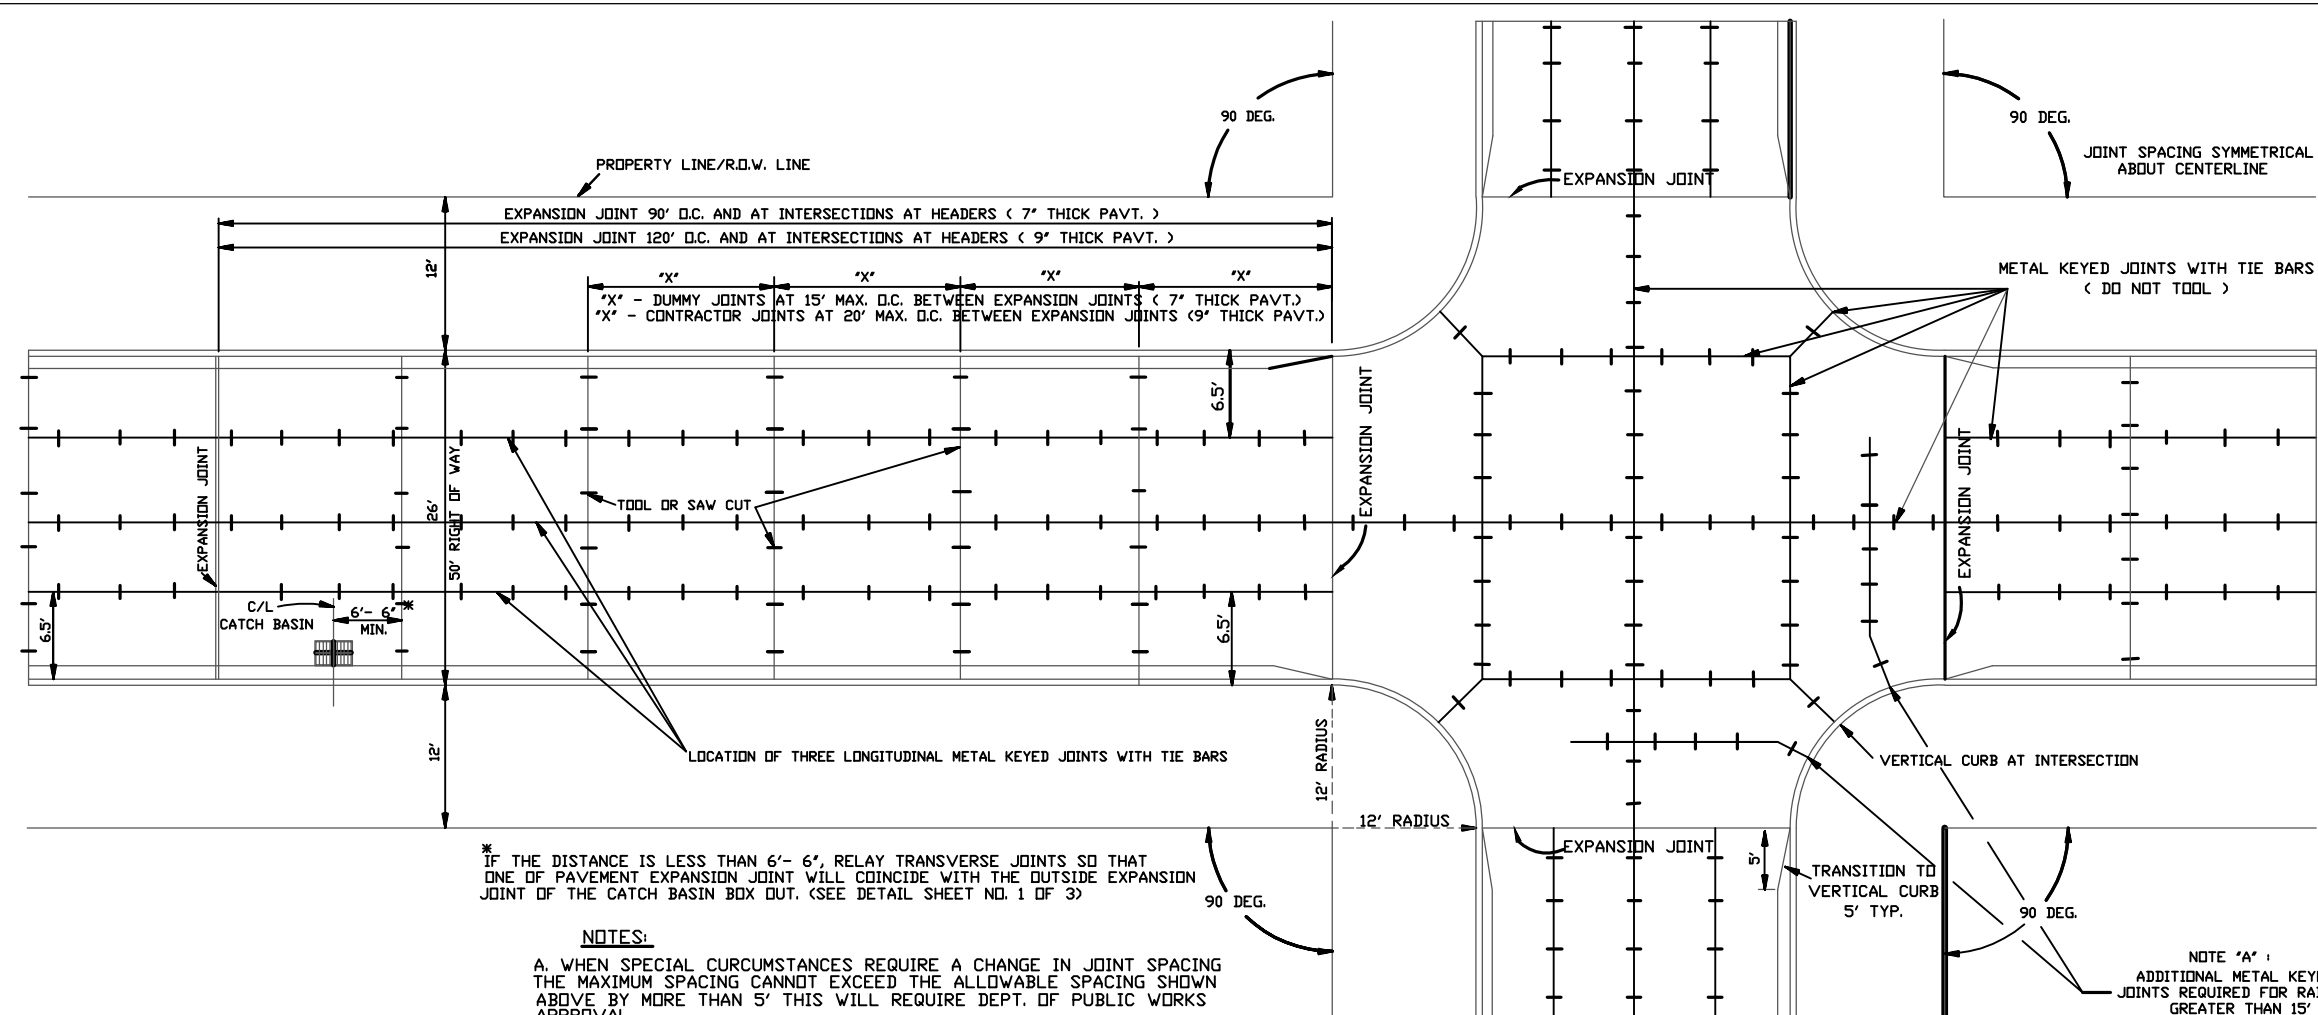


TYPICAL JOINT SPACING AND INTERSECTION
DETAILS FOR 90 DEG. INTERSECTIONS
(SHOWN FOR 26' STREET IN 50' R/W)
N.T.S.

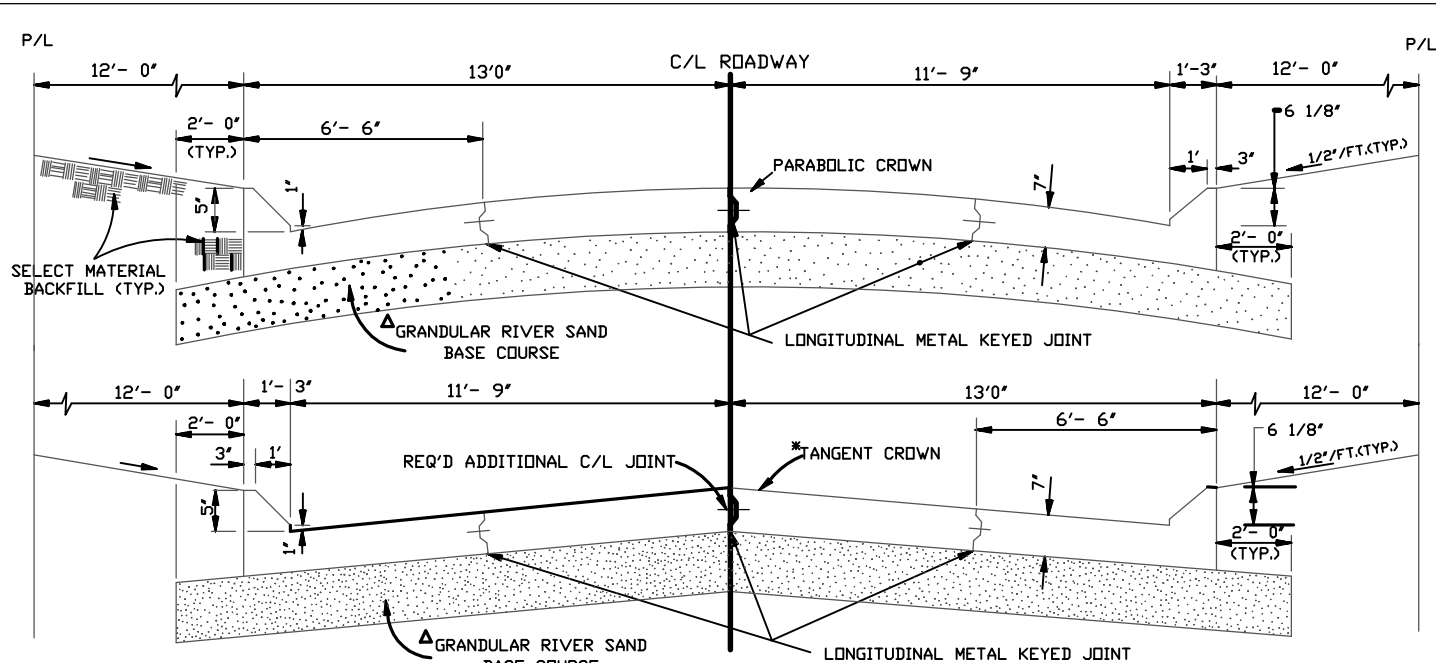



TYPICAL SECTION OF 26' ROADWAY
(WITH WRITTEN PERMISSION OF THE DEPT. OF ENGINEERING ONLY)
N.T.S.

PAVEMENT WIDTH	NUMBER OF UNITS	X	Y
18'	10	10'	1'-10"
20'	12	7.5'	1'-9"
22'	12	11'	1'-10"
24'	14	9'	1'-9"
26'	14	10.5'	1'-10.5"


NOTE:
THICKNESS OF GRANULAR BASE COURSE SHALL BE RECOMMENDED BY A SOIL ENGINEER OR BASED ON JEFFERSON PARISH SOIL MAP.

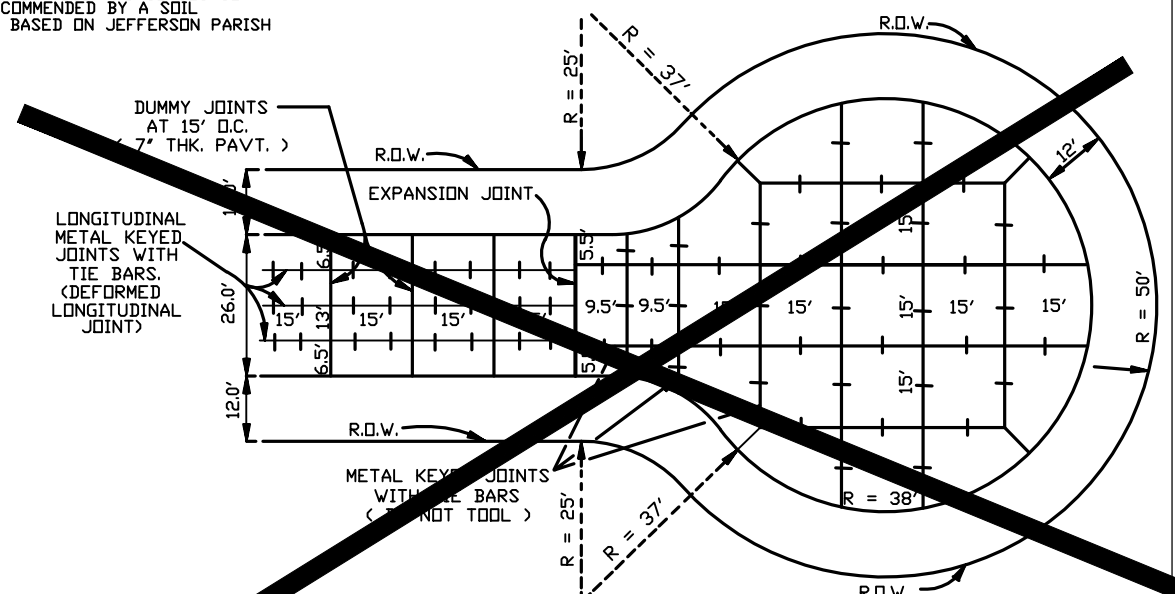



FULL CUL DE SAC (R= 38'/50')
(JOINT DETAIL)
REQUIRED IN DEAD-END STREETS BETWEEN 150' TO 300',
MEASURED ALONG CENTERLINE FROM
INTERSECTION OF PROJECTED EDGE OF ROAD OF
NEAREST INTERSECTING STREET TO END OF R.O.W.
N.T.S.

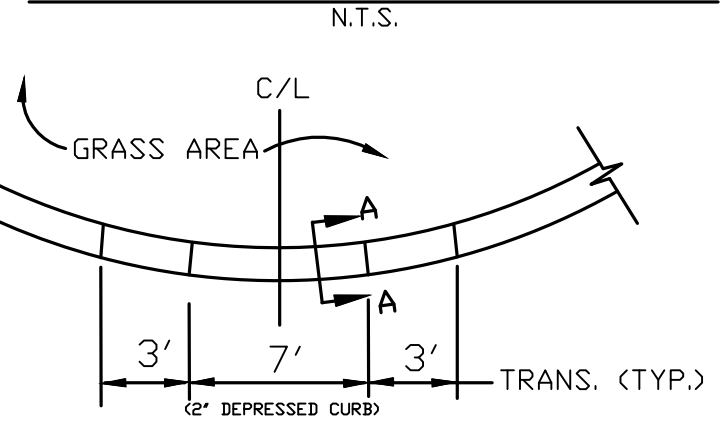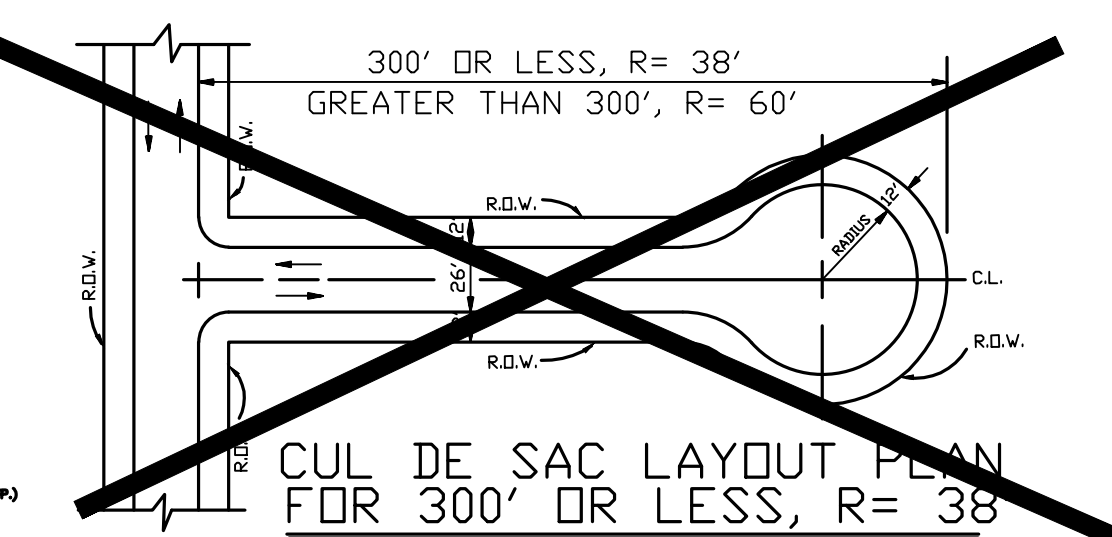



DETAIL "A - A"
MODIFIED DEPRESSED BARRIER CURB
(DRAINAGE TO CURB SHOWN) TO BE USED ON DRIVEWAYS
& OTHER AREAS WHICH REQUIRE THE DEPRESSION OF A BARRIER CURB
N.T.S.

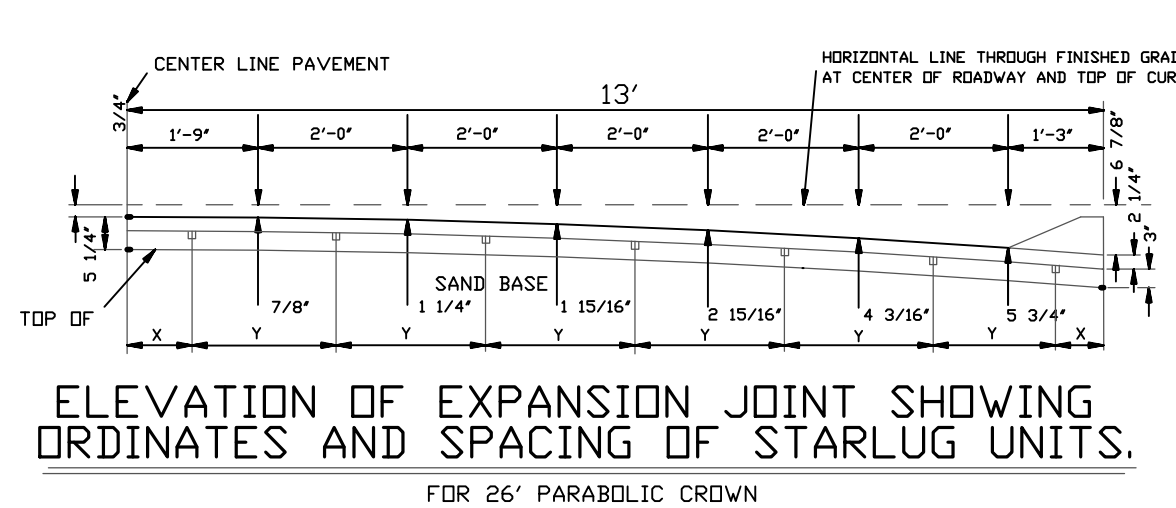

ELEVATION OF EXPANSION JOINT SHOWING
ORDINATES AND SPACING OF STARLUG UNITS.
FOR 26' PARABOLIC CROWN
N.T.S.

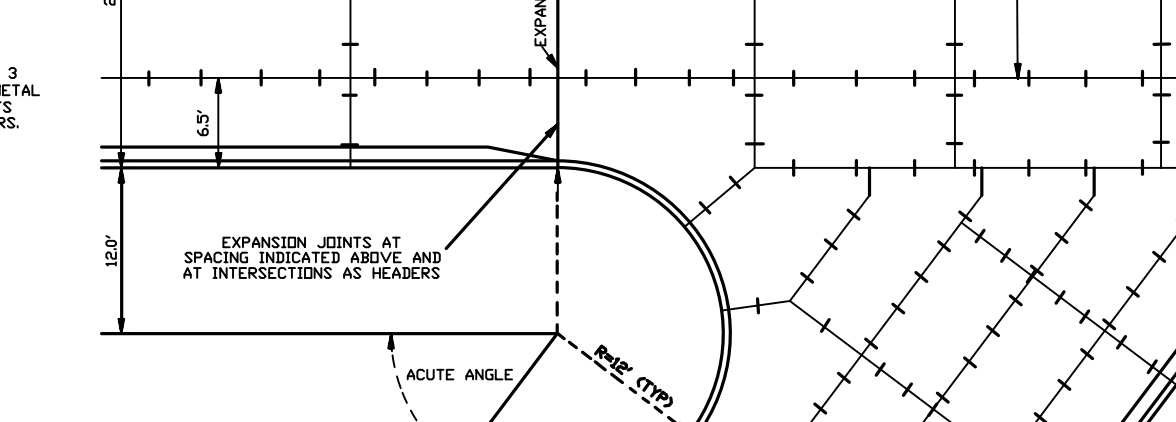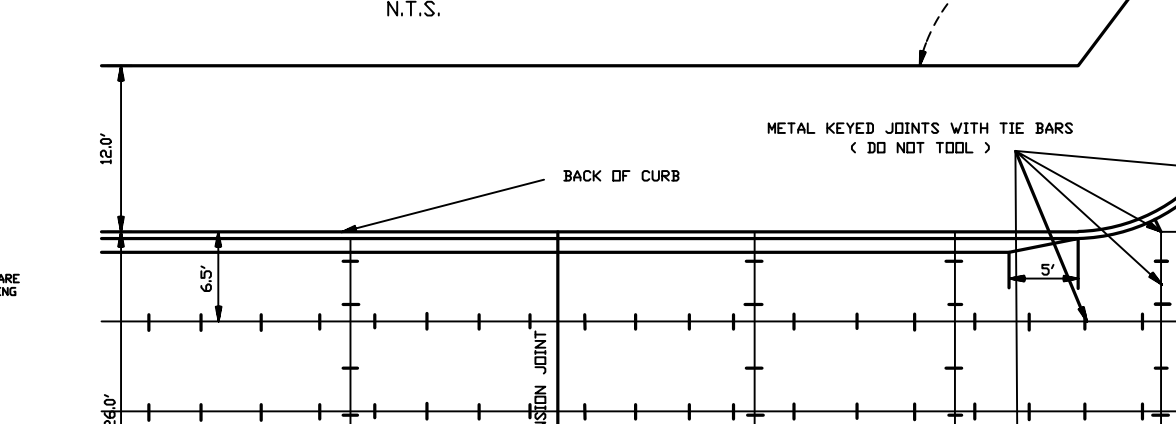

TYPICAL ANGLE INTERSECTION
SHOWN FOR 26' STREET IN 50' R.O.W.
N.T.S.

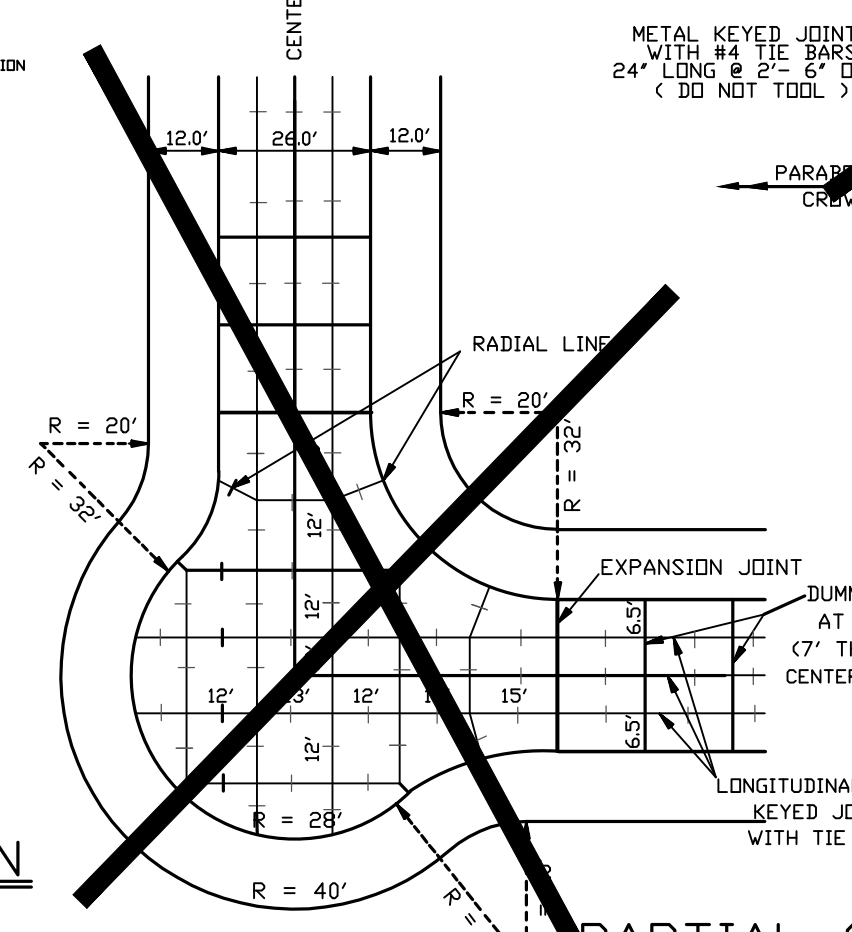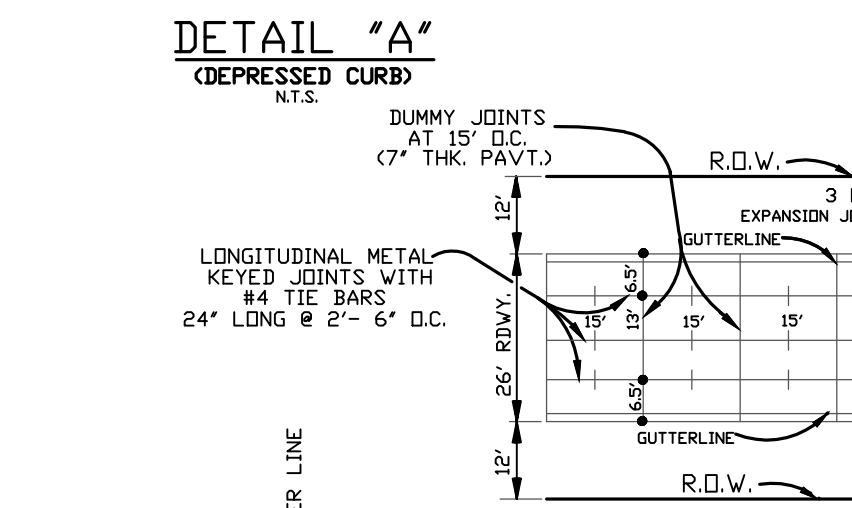


FULL CUL DE SAC (R= 60'/72')
(JOINT DETAIL)
REQUIRED ON DEAD-END STREETS OVER 300' IN
LENGTH, MEASURED ALONG CENTERLINE FROM
INTERSECTION OF PROJECTED EDGE OF ROAD OF
NEAREST INTERSECTING STREET TO END OF R.O.W.
SCALE: N.T.S.

JEFFERSON PARISH DEPARTMENT OF ENGINEERING			
TYPICAL ROADWAY DETAILS			
DRAWN BY:	D.J.D.	DATE:	07/17/92
REVIEWED BY:	H.J.W.	DATE:	06/03/04
REVIEWED BY:	H.J.W.	DATE:	10/29/04
REVIEWED BY:	C.J.	DATE:	09/24/15
FILE NUMBER:	2925A		
DATE:	12/02/03	DATE:	07/13/04
DATE:	07/13/04	DATE:	05/04/07
DATE:	07/25/16	DATE:	
SHT		2 OF 2	




CONCRETE PAVEMENTS

A. REPLACEMENT OF QUARTER POINT JOINTED SLABS

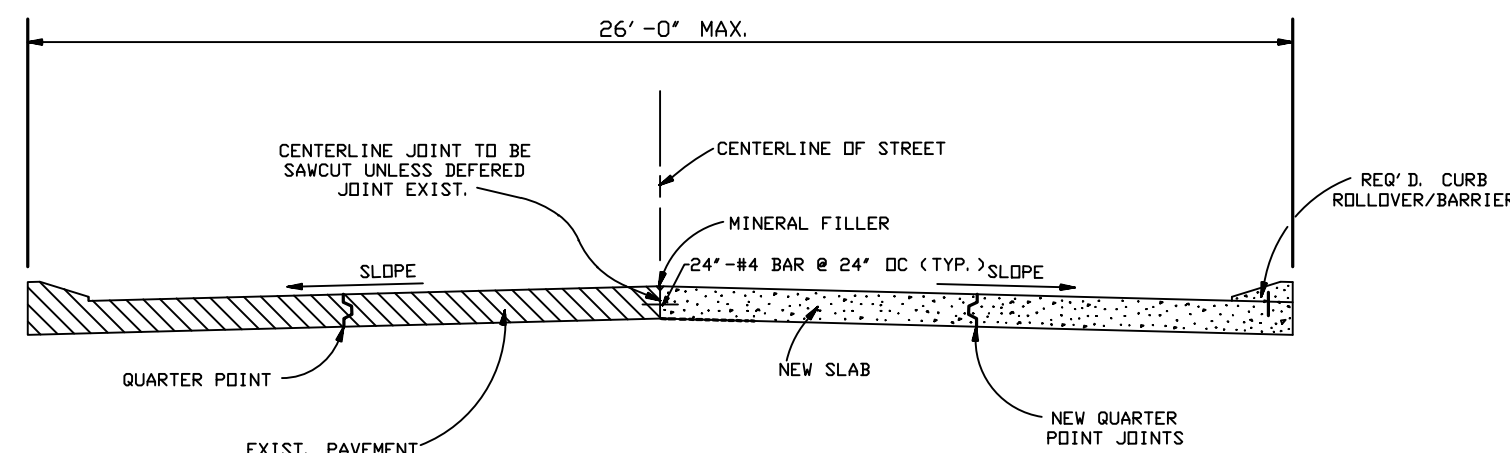


SECTION THRU STREET
(REPLACEMENT OF CENTERLINE)
N. T. S.

B. REPLACING JOINT WITH DAMAGED STARLUG SITUATION

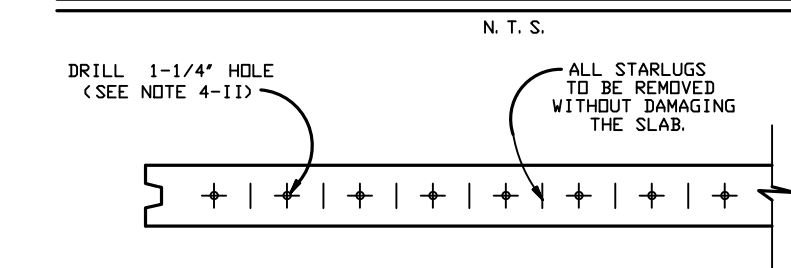


END VIEW
N. T. S.

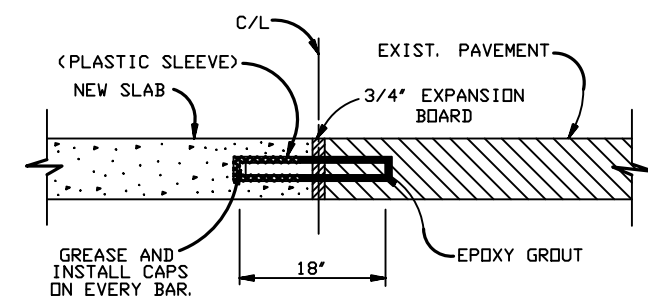


DOWEL BAR DETAIL
N. T. S.

C. CONCRETE REPLACEMENT OVER TRENCH

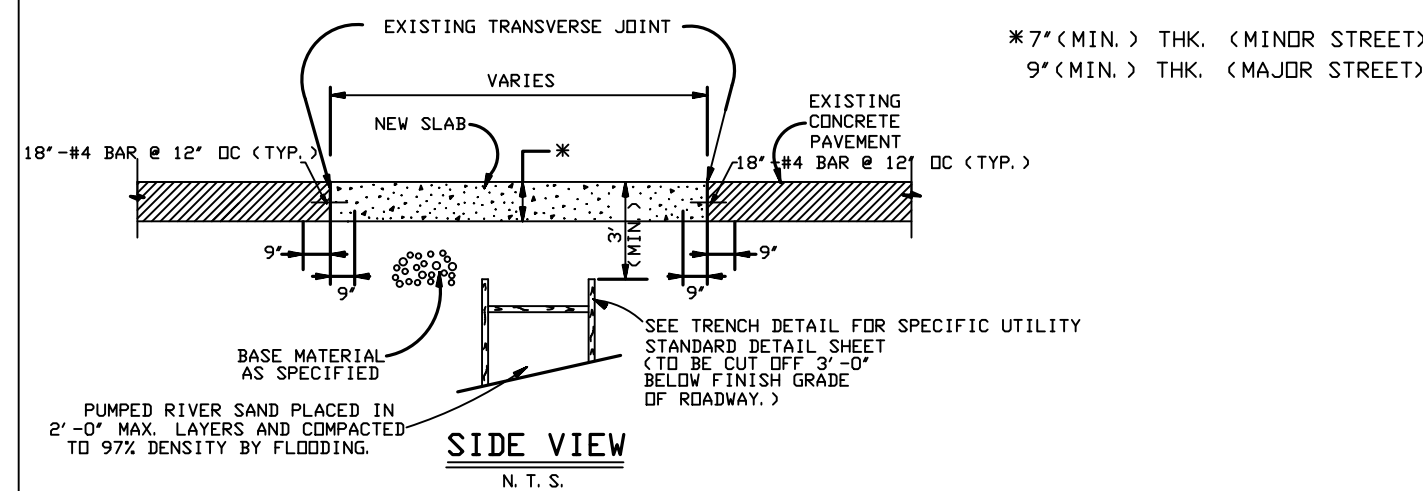

ASPHALT PAVEMENTS

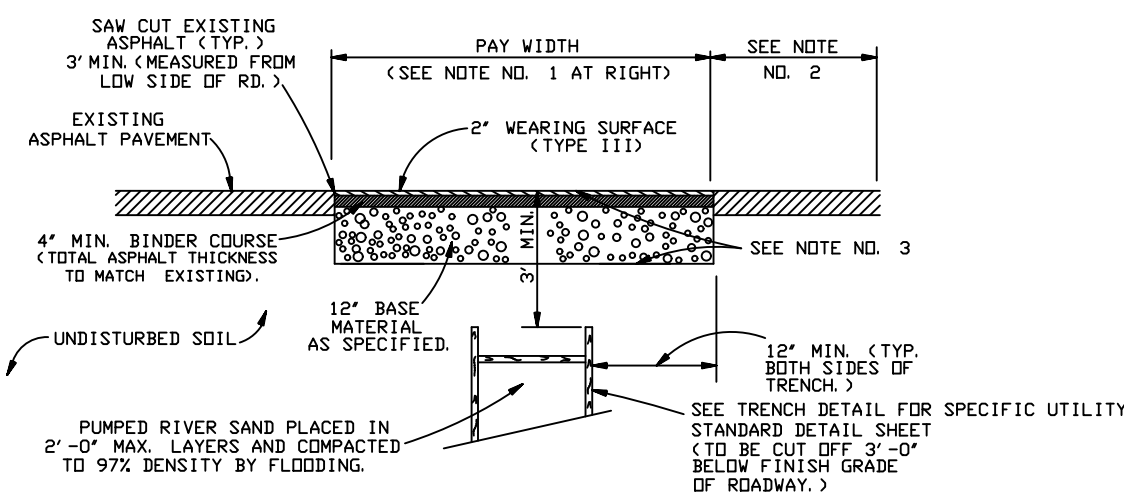


ASPHALT REPLACEMENT OVER TRENCH

NOTE:

1. IF TRENCH IS BETWEEN THE EDGE OF THE ROAD AND 1ST. QUARTER POINT, REMOVE SLABS TO THE QUARTER POINT AND REPLACE THE SECTION TO GRADE AND THICKNESS AS SPECIFIED, AND FORM BUTT JOINT.
2. IF TRENCH IS BETWEEN THE CURB AND CENTERLINE OF SLAB, PAST THE QUARTER POINT, SAW CUT THE PAVEMENT ALONG CENTERLINE, REMOVE HALF THE SLAB, REPLACE HALF SLAB WITH NEW CONCRETE TO SPECIFIED THICKNESS AND FORM A BUTT JOINT ALONG CENTERLINE.
3. EXISTING SLOPE MAY BE PARABOLIC OR TANGENT. SLOPE OF THE NEW SLAB SHALL MATCH THE EXISTING SLAB.

D. REPLACEMENT OF HALF PANEL SLABS

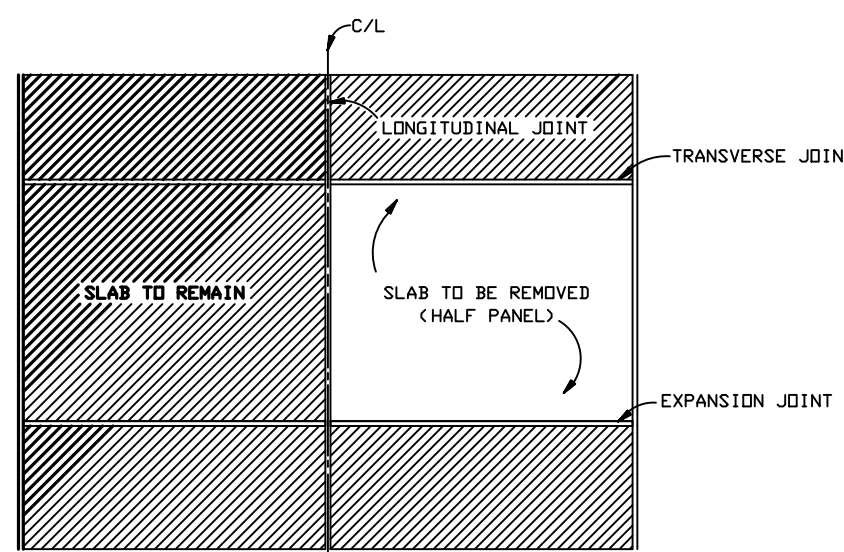

PLAN VIEW
N. T. S.

NOTES: (CONT.)

5. REMOVE THE SLAB JOINT TO JOINT.
6. REPLACE EXPANSION JOINT, TRANSVERSE OR LONGITUDINAL JOINT AS NEEDED.
7. REWORK THE BASE TO GRADE.
8. FILL UNEVEN SPOTS, DRESS THE AREA WITH RIVER SAND AND COMPACT.
9. POUR THE NEW SLAB TO REQUIRED GRADE AND APPROPRIATE THICKNESS.
10. REPAIR THE ADJOINING DAMAGED AREAS, AS NEEDED, WITH EPOXY OR OTHER APPROVED MEANS.
11. REMOVE CONCRETE SLAB, JOINT TO JOINT.
12. LONGITUDINAL JOINTS SHALL BE RESTORED IN ACCORDANCE WITH JEFFERSON PAVEMENT STANDARD PLANS.

NOTES:

1. DAMAGE TO STREET CAUSED BY CONTRACTOR'S OPERATIONS BEYOND PAY LIMITS SHALL BE REMOVED AND REPLACED AT NO ADDITIONAL COST TO THE OWNER.
2. IF LESS THAN 2' FROM EDGE OF CUT TO EDGE OF ROAD, REMOVE ALL ROAD FROM WITHIN THE STRIP AND INCLUDE IN THE PAY WIDTH.
3. CONTRACTOR SHALL BACKFILL WITH BASE MATERIAL AND 6' OF ASPHALT BINDER COURSE TO EXISTING GRADE AND MAINTAIN AREA AS A RIDING SURFACE FOR A MINIMUM OF ONE MONTH OR AS DIRECTED BY THE ENGINEER AND APPROVED BY JEFFERSON PARISH DEPARTMENT OF PUBLIC WORKS. ASPHALT BINDER MATERIAL SHALL BE REMOVED FROM TRENCH AND EXPOSED SURFACE MECHANICALLY COMPACTED TO REQUIRED COMPACTION PRIOR TO ASPHALT PLACEMENT.
4. WEARING COURSE MIX MAY BE USED AS A BINDER BUT NOT VICE-VERSA.

GENERAL:

1. CONTRACTOR IS RESPONSIBLE FOR CLEANING UP ALL DIRT OFF THE STREET AS A RESULT OF HIS CONSTRUCTION ACTIVITIES DURING CONTRACT PERIOD.
2. CONTRACTOR IS RESPONSIBLE FOR REPAIRING ALL DAMAGE TO ADJOINING PAVEMENT WHICH RESULTED FROM HIS CONSTRUCTION ACTIVITIES.
3. BRIDGE APPROACH SLABS OR SLABS AT SPECIAL LOCATIONS SHALL BE DESIGNED TO ACCOMMODATE FIELD REQUIREMENTS AND CONDITIONS, SUBJECT TO APPROVAL BY THE DEPARTMENT OF PUBLIC WORKS.
4. CONTRACTOR IS REQUIRED TO EXTEND SAND BASE/SUB-BASE MINIMUM OF 2 FEET BEYOND THE EDGE OF CONCRETE PAVEMENT OR ONE FOOT OF BASE COURSE (STONE) - 95% FOR ASPHALTIC PAVEMENTS.
5. CONCRETE MIX FOR CURBING SHALL BE THE SAME AS THAT OF THE ROADWAY.
6. AS IS POSSIBLE WITHOUT COST, THE GUTTER LINE OF THE ROADWAY SHALL BE ADJUSTED FOR SMOOTH FLOW OF SURFACE RUN-OFF TO THE NEAREST DRAINAGE INLET.
7. ALL TRAFFIC CONTROL DETAILS SHALL BE APPROVED BY THE TRAFFIC ENGINEERING DIVISION OF THE OFFICE OF PUBLIC WORKS ENGINEERING.

CONCRETE ROADWAY

1. ALL CONCRETE ROADWAY DIRECTLY AFFECTED BY CONSTRUCTION OR DAMAGED AS THE RESULT OF THE CONTRACTOR'S OPERATIONS SHALL BE REMOVED AND REPLACED FROM JOINT TO JOINT, UNLESS OTHERWISE DIRECTED BY THE ENGINEER AND APPROVED BY JEFFERSON PARISH DEPARTMENT OF PUBLIC WORKS.
2. TRANSVERSE (EXPANSION OR CONTRACTION) LONGITUDINAL AND CONSTRUCTION JOINTS SHALL ALL BE INSTALLED IN ACCORDANCE WITH JEFFERSON PARISH DEPARTMENT OF PUBLIC WORKS STANDARD DETAILS. IN CASES WHERE THE SECTION OF ROADWAY TO BE RESTORED ABUTS AN EXISTING ROADWAY, ALL TRANSVERSE AND LONGITUDINAL JOINTS SHALL LINE UP AND BE OF THE SAME TYPE AS THE EXISTING JOINTS (EXPANSION, CONTRACTION, ETC.) AND, IN ADDITION, INCLUDE THE MINIMUM NUMBER AND SPACING OF EXPANSION JOINTS SHOWN IN THE STANDARDS.
3. PRIOR TO RESTORATION OF THE ROADWAY, THE ENGINEER SHALL FORWARD TO THE DEPARTMENT OF PUBLIC WORKS A CONCRETE MIX SUBMITTAL PREPARED BY A REPUTABLE TESTING LABORATORY FOR THEIR APPROVAL.
4. THE THICKNESS OF THE CONCRETE PAVEMENT IS SEVEN INCHES FOR MINOR STREETS AND NINE INCHES FOR MAJOR STREETS. ALL CONCRETE PAVEMENT SHALL BE NON-REINFORCED.
5. THE FINAL ROADWAY SHALL HAVE 'DRAG FINISH' AS STIPULATED UNDER LOUISIANA STANDARD SPECIFICATIONS FOR ROADS AND BRIDGES' LATEST EDITION, UNLESS A TINE FINISH EXIST.
6. DENSITY TESTS WILL BE REQUIRED FOR ALL ROADWAY BASE MATERIALS WHERE REQUIRED IN THE CONTRACT. THE CONTRACTOR SHALL NOT BE ALLOWED TO RESTORE THE ROADWAY UNTIL ALL DENSITY TESTS HAVE BEEN COMPLETED AND THE RESULTS MEET DEPARTMENT OF PUBLIC WORKS SPECIFICATIONS.
7. THE CONTRACTOR SHALL GIVE A MINIMUM NOTICE OF 24 HOURS (EXCLUDING WEEKENDS AND HOLIDAYS) TO THE ENGINEER AND THE ASSIGNED TESTING LABORATORY PRIOR TO THE POURING OF ANY CONCRETE FOR ROADWAY RESTORATION.
8. CONCRETE REQUIREMENTS:
 - A. 7 SACKS OF CEMENT PER CUBIC YARD
 - B. 2' TO 4' SLUMP RANGE
 - C. THE ATTAINMENT OF A COMPRESSIVE STRENGTH OF 4,000 PSI MIN. IS DESIRABLE WITHIN THREE (3) DAYS OF THE POUR (IF STREET IS TO BE OPENED)
9. THE PAVEMENT SHALL NOT BE OPENED TO TRAFFIC UNTIL A COMPRESSIVE STRENGTH OF 4,000 PSI IS ATTAINED. IN NO CASE SHALL THE PAVEMENT BE OPENED TO TRAFFIC WITHIN A THREE (3) DAY PERIOD AFTER THE CONCRETE HAS BEEN PLACED.
10. DENSITY REQUIREMENTS (STANDARD PROCTOR)
 - A. BASE COURSE (SAND) - 97%
 - B. BASE COURSE (STONE) - 95%
 - C. SUB-BASE (SAND) - 97%

ASPHALT ROADWAY

1. SAW CUTTING USING A CONCRETE CUTTING TYPE SAW TO MAKE A TRUE STRAIGHT LINE TO A MINIMUM DEPTH OF ONE (1) INCH SHALL BE REQUIRED ALONG THE ENTIRE LIMITS OF THE AFFECTED AREA OF REMOVAL, UNLESS OTHER METHODS ARE AUTHORIZED BY THE ENGINEER AND APPROVED BY THE DEPARTMENT OF PUBLIC WORKS.
2. REQUIREMENTS 3 AND 10 SPECIFIED UNDER CONCRETE ROADWAY (ABOVE) SHALL ALSO APPLY FOR ASPHALT.
3. JOB MIX FORMULA (PER LA. D.O.T. STANDARDS)
4. ALL CONSTRUCTION MATERIALS, PROCEDURES, TESTING, FINISHING, ETC. SHALL CONFORM TO THE LATEST STANDARD SPECIFICATIONS FOR ROADS AND BRIDGES (DOTD LATEST EDITION). DEVIATIONS FROM THESE SPECIFICATIONS SHALL HAVE TO BE APPROVED BY JEFFERSON PARISH DEPARTMENT OF PUBLIC WORKS.

NOTES:

THIS TYPICAL ROADWAY RESTORATION PLAN WILL BE IN CONJUNCTION WITH THE FOLLOWING:

TYPICAL ROADWAY DETAILS
SHEET 1 OF 2 REVISED 04/11/13
SHEET 2 OF 2 REVISED 05/04/11

TYPICAL DRAINAGE DETAILS
SHEET 1 OF 3 REVISED 07/11/13
SHEET 2 OF 3 REVISED 07/11/13
SHEET 3 OF 3 REVISED 7/11/13

TYPICAL SIDEWALK DETAIL
SHEET 1 OF 1 REVISED 05/13/11

TYPICAL WATER DETAILS
SHEET 1 OF 1 REVISED 07/11/19

TYPICAL SEWER DETAIL
SHEET 1 OF 1 REVISED 07/11/13

TYPICAL (RCP), (RCPA) & PVC PIPE TRENCH DETAILS
SHEET 1 OF 1 REVISED 07/11/13



JEFFERSON PARISH
DEPARTMENT OF ENGINEERING

TYPICAL ROADWAY RESTORATION DETAIL

DRAWN BY	T.V.C.	DATE	05/18/94	REVISED BY	H.J.W.	DATE	07/13/01
REVISED BY	H.J.W.	DATE	04/29/03	ISS TO AUTOCAD LT		DATE	01/21/04
REVISED BY	H.J.W.	DATE	08/18/04	REVISED BY	H.J.W.	DATE	04/20/05
REVISED BY	C.J.	DATE	05/13/11	REVISED BY	C.J.	DATE	07/18/12
AUTOCAD LT. 2004				ROADRES1.DWG			

SHT 1 OF 1



		UNDISTURBED SUBGRADE NEAR ALLOWABLE SOIL BEARING CAPACITY (psf.)				
		300-400	401-500	501-600	601-700	>700
PIPE SIZE (RCP) (RCPA)	BEDDING LAYER					
(36" & 42")	(1)	8"	18"	16"	14"	12"
(42" & 48")	(2)	8"	8"	8"	8"	8"
TOTAL THICKNESS		28"	26"	24"	22"	20"
(48" & 54")	(1)	22"	20"	18"	14"	12"
(54" & 60")	(2)	22"	10"	10"	10"	10"
TOTAL THICKNESS		32"	30"	28"	24"	22"
(60" & 72")	(1)	34"	30"	26"	16"	14"
(72" & 96")	(2)	10"	10"	10"	10"	10"
TOTAL THICKNESS		44"	40"	36"	26"	24"

(1)	BEDDING LAYER
(RCP)	REINFORCED CONCRETE CIRCULAR (ROUND) PIPE.
[RCPA]	REINFORCED CONCRETE ARCH PIPE

57 LIMESTONE		
<u>U.S. SIEVE</u>	<u>METRIC SIEVE</u>	<u>PERCENT PASSING</u>
1½"	37.5 mm	100
1"	25 mm	95-100
½"	12.5 mm	25-60
#4	4.75 mm	0-10
#8	2.36 mm	0-5

U.S. SIEVE	METRIC SIEVE	PERCENT PASSING
1½"	37.5 mm	100
1"	25 mm	90–100
¾"	19 mm	70–100
½"	12.5 mm	60–90
⅜"	9.5 mm	50–80
#4	4.75 mm	35–65
#40	425 μm	12–32
#200	75 μm	5–12



MIN. COVER (PVC PIPE)	PAVEMENT TYPE
12"	CONCRETE
18"	ASPHALT
24"	NON-PAVED

- ***8. GEOTECHNICAL REPORT'S RECOMMENDATIONS FOR PIPE BEDDING, IF MORE STRINGENT, SHALL SUPERSEDE THESE MINIMUM THICKNESSES.

	JEFFERSON PARISH DEPARTMENT OF ENGINEERING						
	DRAWING TITLE TYPICAL (RCP), (RCPA) & (PVC) PIPE TRENCH DETAILS						
DRAWN BY:	C.J.	DATE:	11/04/2011	DESIGNED BY:	M.R.M.	DATE:	11/04/2011
REVISED BY:	C.J.	DATE:	05/10/2012	REVISED BY:	---	DATE:	---
REVISED BY:	C.J.	DATE:	07/11/2013	REVISED BY:	---	DATE:	---
REVISED BY:	C.J.	DATE:	02/10/2015	REVISED BY:	---	DATE:	---
XREF: AUTOCAD LT. 2008				W/N TYPICAL PIPE TRENCH DETAILS			
FILE NUMBER: _____				_____			



SOIL	TYPE	0-4"	4-6"	6-8"	8-10"
17	I	I	II	III	✓
9	I	I	II	III	✓
16	II	II	III	IV	✓
14	II	II	III	IV	✓
13	II	II	III	IV	✓
3	II	III	IV	V	✓
9	II	III	IV	V	✓
5	II	III	IV	V	✓
20	II	III	IV	V	✓
18	II	III	IV	V	✓
4	II	III	IV	V	✓
1	II	III	IV	V	✓
11	II	III	IV	V	✓
2	II	III	IV	V	✓
8	II	III	IV	V	✓

NOTES:

1. ONLY HARDWOOD SUCH AS OAK SHALL BE ALLOWED FOR SHEETING, BRACING, AND FOUNDATION LUMBER.
2. AT THE CONTRACTOR'S OPTION, FOUNDATION LUMBER MAY BE USED IN TRENCH TYPES I & II.
3. THE CONTRACTOR MUST REVIEW AND UNDERSTAND ALL DETAILS AND TABLES ON THIS STANDARD DRAWING SHEET PRIOR TO BIDDING. THE ABOVE TABLE DICTATES THE TYPE OF REQUIRED TRENCHES (TYPES I, II, III, IV, AND V) BASED ON THE SOIL TYPE (TYPES 1 - 20). THE SPECIFIC SOIL TYPE MUST BE IDENTIFIED IN THE BID DOCUMENTS FOR EACH CONSTRUCTION PROJECT. THIS, SIMPLY, CAN BE ACCOMPLISHED BY CIRCLING THE SOIL TYPE AND THE ASSOCIATED TRENCH TYPES (BOX THE ENTIRE ROW).
4. BEDDING MATERIALS FOR HOUSE CONNECTION TO BE IN CONFORMANCE WITH THE FOLLOWING SCHEDULE:

TYPE OF MAIN SEWER	TYPE OF REQUIRED HOUSE CONNECTION
TRENCH BEDDING	TRENCH BEDDING
V	IV
IV	III
III	II
II	I
I	CRUSHED LIME STONE OR GRAVEL ONLY

NOTE:

VERTICAL RISERS SHALL BE AVOIDED IF POSSIBLE. IF CONSTRUCTED, SPECIAL VERTICAL RISER SYSTEMS COMPONENTS (CONTROLLED SETTLEMENT JOINT, VERTICAL RISER ADAPTER, DEEP SOCKET & BEND, ETC.) SHALL BE USED AS PER ROYAL PLASTIC TRENDS MUNICIPAL SOLUTIONS' VERTICAL RISER SYSTEMS', OR APPROVED EQUAL. TEES OR TEE-WYES, WHICH ARE USED IN CONSTRUCTION OF VERTICAL RISERS SHALL BE SDR26 FITTINGS

PIPE TRENCH PER JEFFERSON
PARISH STANDARD,
INCLUDING STONE,
FOUNDATION LUMBER, PLASTER,
ETC.

	JEFFERSON PARISH DEPARTMENT OF ENGINEERING				
	DRAWING TITLE				
	SEWER STANDARD DETAILS				
	DRAWN BY: T.V.C. DATE: 03/05/92 REVISY BY: GL DATE: 08/30/95 REVISY BY: H.J.W. DATE: 07/27/00 REVISY BY: J.LC DATE: 10/05/06 CHECKED BY: L.L DATE: 03/06/92 REVISY BY: P.D DATE: 05/30/00 APP TO AUTOCAD BY: P.D DATE: 02/09/04 REVISY BY: C.J DATE: 07/11/13				
DESIGNED BY: AUTOCAD LT. 2006		YRS: 0		FILE NAME: SEWER1.DWG	
SCALE: AS SHOWN SHEET NO. 1 OF 2					

FILE NAME: I:\GRETTA DOWNTOWN DRAINAGE PHASE II (19-15)\CDS\3 - BID SET\1915_BID SET.DWG

GENERAL SITE NOTES

- ALL EXISTING SURFACE AND SUBSURFACE UTILITIES ARE TO BE VERIFIED BY THE CONTRACTOR IN THE FIELD PRIOR TO CONSTRUCTION.
- CONTRACTOR TO CALL "LOUISIANA ONE CALL" AT 1-800-272-3020 AT LEAST 5 WORKING DAYS BEFORE SCHEDULED DIGGING IN ORDER TO HAVE UNDERGROUND UTILITIES AND FACILITIES MARKED.
- CONTRACTOR SHALL BEAR THE FULL RESPONSIBILITY OF VERIFYING LOCATIONS OF EXISTING SURFACE AND SUB-SURFACE SITE ELEMENTS AND UTILITIES.
 - THE CONTRACTOR SHALL BE RESPONSIBLE FOR ANY DAMAGE TO SAID UTILITIES.
 - CONTRACTOR SHALL ALLOW ADEQUATE TIME, IN THE CONSTRUCTION SCHEDULE, FOR FIELD VERIFICATION AND POTENTIAL DESIGN REVISIONS.
- REFER TO WRITTEN SPECIFICATION FOR MORE DETAILED MATERIAL AND CONSTRUCTION REQUIREMENTS.
- AFTER BIDDING, CALL THE LANDSCAPE ARCHITECT AT (504) 345-2639 TO ASK ANY QUESTIONS.
- ALL PLANTED AREAS (WITHIN THE LANDSCAPE LIMIT-OF-WORK LINE) SHALL BE WATERED BY CONTRACTOR THROUGHOUT CONSTRUCTION.

SITE DEMOLITION AND PROTECTION NOTES

- EXISTING SITE ELEMENTS SHALL REMAIN AND BE PROTECTED UNLESS DESIGNATED TO BE REMOVED AND/OR SALVAGED.
- PROTECTION OF EXISTING FACILITIES AND SITE FEATURES SHALL INCLUDE ENTIRETY OF STRUCTURE, BOTH SURFACE AND SUB-SURFACE, UNLESS OTHERWISE NOTED.
 - PROVIDE PROTECTION TO ALL FINISHED WORK UNTIL ACCEPTED BY OWNER.
 - ALL EXISTING SITE ELEMENTS DESIGNATED AS REMAINING AND/OR PROTECTED SHALL BE CLEANED BY THE CONTRACTOR PRIOR TO FINAL ACCEPTANCE OF SITE WORK.
 - WHEN CLEANING EXISTING SITE ELEMENTS, THE CONTRACTOR SHALL UTILIZE INDUSTRY STANDARDS AND RECOMMENDED PRACTICES FOR THE MATERIAL.
- VERIFY THE LOCATION AND DIMENSION OF ITEMS TO BE REMOVED PRIOR TO COMMENCEMENT OF THE WORK.
- DEMOLITION AND REMOVAL OF EXISTING FACILITIES SHALL INCLUDE ENTIRETY OF STRUCTURE, BOTH SURFACE AND SUB-SURFACE, UNLESS OTHERWISE NOTED.
- ALL CONCRETE AND ASPHALT REMOVAL SHALL BE SAW CUT. EDGES OF MATERIAL TO REMAIN SHALL BE SHORED UP AND PROTECTED DURING CONSTRUCTION TO PRESERVE EDGE INTACT. REPAIRS TO DAMAGED EDGES TO BE DONE WITH CARE AND AT NO COST TO THE OWNER.
- REMOVE DEMOLISHED MATERIALS FROM SITE.
- DISPOSAL BY BURNING AND/OR BURYING IS PROHIBITED.
- ITEMS ENCOUNTERED BELOW GRADE AND NOT SHOWN ON THE DRAWINGS SHALL BE BROUGHT TO THE ATTENTION OF THE LANDSCAPE ARCHITECT IMMEDIATELY, PRIOR TO CONTINUATION OF WORK.

SITE MATERIALS NOTES

- REFER TO THE JEFFERSON PARISH DEPARTMENT OF ENGINEERING STANDARD DRAWINGS FOR THE FOLLOWING SITE IMPROVEMENTS:
 - ADA CURB RAMPS
 - CURB RAMP FOR THE HANDICAPPED
 - JP FILE NUMBER: 2925C
 - HANDICAPPED REQUIREMENTS
 - COMMERCIAL PLAN DETAIL NO. 5
 - JP FILE NUMBER: ENV-09
 - CONCRETE SIDEWALKS
 - TYPICAL SIDEWALK DETAIL
 - JP FILE NUMBER: 2922
 - CONCRETE CURB AND GUTTER
 - CURB AND CURB & GUTTER DETAILS
 - JP FILE NUMBER: 3508
 - DETAILS OF ROADWAY CURB AND GUTTER BOTTOM
 - COMMERCIAL PLAN DETAIL NO.8
 - JP FILE NUMBER: ENV-09
 - LAYOUT AND CONSTRUCTION OF ASPHALT AND PORTLAND CEMENT CONCRETE ROADWAYS
 - TYPICAL ROADWAY DETAILS SHT 1
 - JP FILE NUMBER: 2925
 - TYPICAL ROADWAY DETAILS SHT 2
 - JP FILE NUMBER: 2925A
 - DEMOLITION OF EXST. ROADWAY/UTILITY TRENCHING
 - TYPICAL DETAILS FOR PATCHING CUT ACROSS PARISH STREETS
 - COMMERCIAL PLAN DETAIL NO. 11
 - JP FILE NUMBER: ENV-09
 - RESTORATION OF ROADWAY PAVEMENT
 - TYPICAL ROADWAY RESTORATION DETAIL
 - JP FILE NUMBER: 2925C
 - INSTALLATION OF PIPE WITHIN UTILITY TRENCH
 - TYPICAL (RCP), (RCPA) & (PVC) PIPE TRENCH DETAILS
 - STANDARD DIMENSIONS PARKING STALLS
 - TYPICAL SPACE REQUIREMENTS FOR SELF-PARKING AT VARIOUS ANGLES
 - COMMERCIAL PLAN DETAIL NO. 3
 - JP FILE NUMBER: ENV-09- CONTRACTOR TO ENSURE LANDSCAPE ARCHITECT IS PRESENT AT THE COMMENCEMENT OF PAVER INSTALLATION TO CONFIRM ORIENTATION, ALIGNMENT, AND PATTERN OF PAVERS.

LAYOUT AND STAKING NOTES

- ON-SITE VERIFICATION OF ALL DIMENSIONS AND CONDITIONS SHALL BE THE RESPONSIBILITY OF THE GENERAL CONTRACTOR.
- DISCREPANCIES BETWEEN NOTED DIMENSIONS, DRAWING SCALE, AND/OR FIELD CONDITIONS MUST BE RESOLVED WITH THE LANDSCAPE ARCHITECT PRIOR TO CONSTRUCTION OF THE SITE ELEMENT(S) IN QUESTION.
- DIMENSIONS ANNOTATED ON ADDENDA AND CLARIFICATIONS TAKE PRECEDENT OVER PREVIOUS DOCUMENTS.
- CONTRACTOR TO LAY OUT SITE ELEMENTS AND VERIFY LAYOUT IN THE FIELD WITH LANDSCAPE ARCHITECT PRIOR TO CONSTRUCTION. CONTRACTOR TO GIVE LANDSCAPE ARCHITECT 24 HOURS NOTICE.
 - CONTRACTOR TO LAY OUT LANDSCAPE ARCHITECTURAL SITE ELEMENTS IN CONJUNCTION, AS PART OF THE VERIFICATION PROCESS.
 - SITE ELEMENTS ARE DIMENSIONED ON THE MATERIALS PLANS, LAYOUT PLAN, AND/OR PLANTING PLANS.
- WHERE DIMENSIONS ARE CALLED AS "EQUAL," SPACE REFERENCED ITEMS EQUALLY, MEASURED TO THEIR CENTERLINES.
- MEASUREMENTS ARE TO FACE OF BUILDING, WALL, OR FIXED SITE IMPROVEMENT. DIMENSIONS TO CENTERLINES IS AS INDICATED.
- INSTALL INTERSECTING ELEMENTS AT 90 DEGREE ANGLES TO EACH OTHER, UNLESS OTHERWISE NOTED.
- PROVIDE EXPANSION JOINTS WHERE CONCRETE FLATWORK MEETS VERTICAL STRUCTURES SUCH AS WALLS, CURBS, STEPS AND BUILDING ELEMENTS.

GRADING AND DRAINAGE NOTES

- CONTRACTOR SHALL FIELD VERIFY EXISTING GROUND AND/OR SUB-DECK LINE PROFILE. PROPOSED ELEVATIONS FOR CONTOURS & DRAINAGE STRUCTURES ARE SUBJECT TO CHANGE BASED ON FIELD VERIFICATION OF EXISTING ELEVATIONS.
- ALL GRADED SURFACES SHALL BE FINISHED TO UNIFORM LEVELS, SLOPED AND SMOOTHED WITHIN THE FOLLOWING TOLERANCES:
 - FINISHED SURFACE SHALL BE WITHIN $\frac{1}{8}$ INCH OF SPECIFIED ELEVATION.
- IT IS THE CONTRACTOR'S RESPONSIBILITY TO SET ALL NEW DRAIN LINES SO THAT POSITIVE DRAINAGE WILL OCCUR.
- WATER (RAIN WATER, PLUMBING, SEWERAGE, ETC.) MAY NOT DRAIN ONTO ADJACENT SITES/PROPERTIES.
- AT ENTRYWAYS TO BUILDINGS ALL WALKWAYS SHALL MEET THE FINISHED FLOOR ELEVATION WITH A MAXIMUM TRANSITION OF A $\frac{1}{2}$ INCH.
- IN THE PUBLIC R.O.W. DIRECT THE SURFACE FLOW OF STORMWATER TOWARDS THE BIORETENTION CELLS.

SITE SOIL PREPARATION NOTES

- DURING THE DEMOLITION AND EXCAVATION PHASE, REMOVE EXISTING SITE SOIL AND DISPOSE OF THE SOIL IN ACCORDANCE WITH SPECIFICATIONS. NOTIFY THE LANDSCAPE ARCHITECT ONCE THE SOIL HAS BEEN EXCAVATED AND REMOVED.
 - NO EXCAVATED OR DISTURBED SITE SOILS MAY BE REUSED. NEW SOILS MUST BE BROUGHT TO THE SITE.
 - NEW SOILS MAY REQUIRE AMENDMENT PRIOR TO INSTALLATION SO THAT THE SOIL MEETS THE SPECIFICATION REQUIREMENTS. THE ADDITION OF SOIL AMENDMENTS IS DETERMINED FROM SOIL TESTS CONDUCTED PRIOR TO WORK COMMENCING. SOIL AMENDMENT MAY INCLUDE:
 - INORGANIC MATERIAL SUCH AS SAND, SILT, OR CLAY
 - ORGANIC MATERIAL SUCH AS COMPOST, MANURE, ETC. PEAT MOSS IS NOT ALLOWED.
- PRIOR TO THE INSTALLATION OF PLANTING , CONTRACTOR TO PREPARE AND TEST SITE SOILS TO ENSURE A PROPER ENVIRONMENT FOR PLANT ROOT DEVELOPMENT.
- CONTRACTOR TO ENSURE SOILS LOCATED WITHIN PLANTING AREAS ARE DE-COMPACTED. DE-COMPACTION MAY BE ACHIEVED USING A ROTO-TILLING, DISKING, OR RIPPING TO A DEPTH OF 18 INCHES.
 - WHEN PERFORMING SOIL DE-COMPACTION, MULTIPLE PASSES ACROSS THE AREA WILL BE REQUIRED AND, WHEN POSSIBLE, SHOULD BE AT VARYING ANGLES TO ENSURE ADEQUATE COVERAGE.
 - WHEN USING DISC OR RIPPING EQUIPMENT, IT IS REQUIRED THAT THE FINAL PASSES OVER THE AREA BE MADE WITH A ROTO-TILLER TO BREAK UP ANY LARGE CLUMPS IN ORDER TO FACILITATE IN FINE GRADING ACTIVITIES.
- CONTRACTOR TO ENSURE ALL DEBRIS OVER 2" IN DIAMETER HAS BEEN REMOVED FROM THE SOIL(S).
- CONTRACTOR TO ENSURE THAT ALL SOIL AMENDMENTS ARE MIXED THOROUGHLY WITH THE EXISTING SOIL.
- DURING THE REMAINDER OF THE PLANTING INSTALLATION, VARIOUS AREAS OF THE SITE MAY BE RE-COMPACTED DUE TO THE USE OF EQUIPMENT AND VEHICLES. THIS COMPACTION IS TYPICALLY ISOLATED WITHIN THE UPPER 4-6" OF THE SOIL. CONTRACTOR TO ENSURE THAT PRIOR TO THE INSTALLATION OF PLANT MATERIAL IN THESE AREAS, THE COMPACTION IS REDUCED TO 80% OR LESS USING PREVIOUSLY DESCRIBED METHODS.

WATERING NOTES

- CONTRACTOR RESPONSIBLE FOR MAINTAINING AND WATERING PLANT MATERIAL AT DELIVERY, PRIOR TO INSTALLATION, ONCE INSTALLED, AND THROUGHOUT CONSTRUCTION.
- CONTRACTOR TO ENSURE THAT THE SOILS WITHIN PLANT STORAGE NURSERY BE SATURATED SEMI-WEEKLY (TWICE EVERY 7 DAYS).
- PLANTING AREAS AND PLANTERS TO RECEIVE 2 $\frac{1}{2}$ TO (3) THREE INCHES OF WATER PER SATURATION.
 - WATERING MAY BE APPLIED TO SINGLE-TRUNK TREES VIA TREE WATERING BAGS
 - WATERING MAY BE APPLIED TO ALL OTHER PLANT MATERIALS VIA HAND WATERING.
- WATER MEASUREMENTS MAY INCLUDE RAIN WATER DOCUMENTED BY THE NATIONAL WEATHER SERVICE OR PRE-APPROVED THIRD PARTY.
- THE SCHEDULED WATERING MUST BE EVENLY DISPERSED WITHIN THE WEEK. THE CONTRACTOR MAY NOT WATER THE PLANTS ON CONSECUTIVE DAYS.

PLANTING NOTES

- THE LOCATION OF ALL PLANTING AREAS AND THE SHRUBS WITHIN THEM ARE TO BE LAID OUT IN THE FIELD BY THE CONTRACTOR AND APPROVED BY THE LANDSCAPE ARCHITECT PRIOR TO INSTALLATION. GIVE LANDSCAPE ARCHITECT 72 HOURS NOTICE.
- QUANTITIES ARE GIVEN FOR INFORMATION PURPOSES ONLY. THE CONTRACTOR SHALL BE RESPONSIBLE FOR PERFORMING AN INDEPENDENT QUANTITIES TAKE-OFF TO DETERMINE QUANTITIES THAT MEET SPECIFIED SPACING, COVERAGE, AND THE DESIGN INTENT.
- ALL SHRUBS SHALL BE CONTAINER GROWN UNLESS NOTED OTHERWISE.
- PLANT MATERIAL MAY ONLY BE PRUNED BY THE NURSERY AT A MINIMUM THREE MONTHS PRIOR TO DELIVERY. THIS WILL HELP ENSURE ALL PLANTS ARE IN GOOD HEALTH WHEN DELIVERED TO THE SITE.
- ONCE DELIVERED, PLANT MATERIALS MAY NOT BE PRUNED PRIOR TO INSTALLATION.
- CONTRACTOR TO ENSURE THE LANDSCAPE ARCHITECT IS PRESENT DURING ALL SHRUB INSTALLATION AS WELL AS ALL POST INSTALLATION PRUNING SESSIONS.
- CONTRACTOR TO ENSURE THAT THE PRUNING OF INSTALLED PLANT MATERIAL BE CONDUCTED BY THE FOLLOWING PROFESSIONALS. THESE PROFESSIONALS MUST ALSO HAVE A THOROUGH KNOWLEDGE OF THE DESIGN INTENT.
 - SHRUBS AND HEDGES BY A LOUISIANA LICENSED LANDSCAPE HORTICULTURIST.
- PRIOR TO INSTALLATION, ALL PLANT MATERIALS SHALL BE IRRIGATED AND STORED UPRIGHT (VERTICAL) WITH SUFFICIENT SUN PROTECTION TO PREVENT WILT, DIE BACK, AND/OR DRY OUT.
- ALL PLANT MATERIAL MUST BE PROPERLY IDENTIFIED WITH NURSERY TAGS.
- ALL PLANT MATERIAL MUST BE FREE OF DISEASE AND PESTS.
- ALL PLANT MATERIAL MUST SHOW NO SIGNS OF PHYSICAL ROOT, ROOT FLARE, TRUNK, BRANCH, AND/OR CROWN DAMAGE.
- PRIOR TO FINAL ACCEPTANCE, THE LANDSCAPE ARCHITECT RESERVES THE RIGHT TO REJECT ANY PLANT MATERIAL THAT DOES NOT MEET THE STANDARDS DESCRIBED IN AMERICAN STANDARD FOR NURSERY STOCK, APPROVED BY ANSI.
- REFER TO THE FOLLOWING SPECIFICATION SECTIONS FOR ALL REQUIREMENTS PERTAINING TO PLANTING:
 - SECTION 32 93 00 PLANTS



GRETTA DOWNTOWN DRAINAGE IMPROVEMENTS (PHASE 2) GENERAL AND PLANTING NOTES



BKI

BURK-KLEINPETER, INC.

ENGINEERS, ARCHITECTS, PLANNERS, ENVIRONMENTAL SCIENTISTS
LANDSCAPE ARCHITECTS
10119-5994
PHONE (504)386-5501 FAX (504)386-1714

DESIGNED T.F. CHECKED D.D.

DETAILED T.F. CHECKED D.D.

DATE DEC, 2021 SHEET 1 of 1


NO.

DATE

REVISION DESCRIPTION

BY


LEGEND:

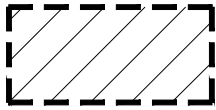

ROADWAY AND SUBBASE
TO BE REMOVED




CURB AND/OR GUTTER
TO BE REMOVED

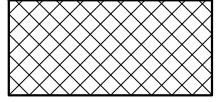

STAMPED SIDEWALK TO
BE REMOVED

NOTES:


1. REMOVAL OF ROADWAY SHALL INCLUDE ALL BASE COURSE AND SUBBASE MATERIALS, UNLESS OTHERWISE NOTED.

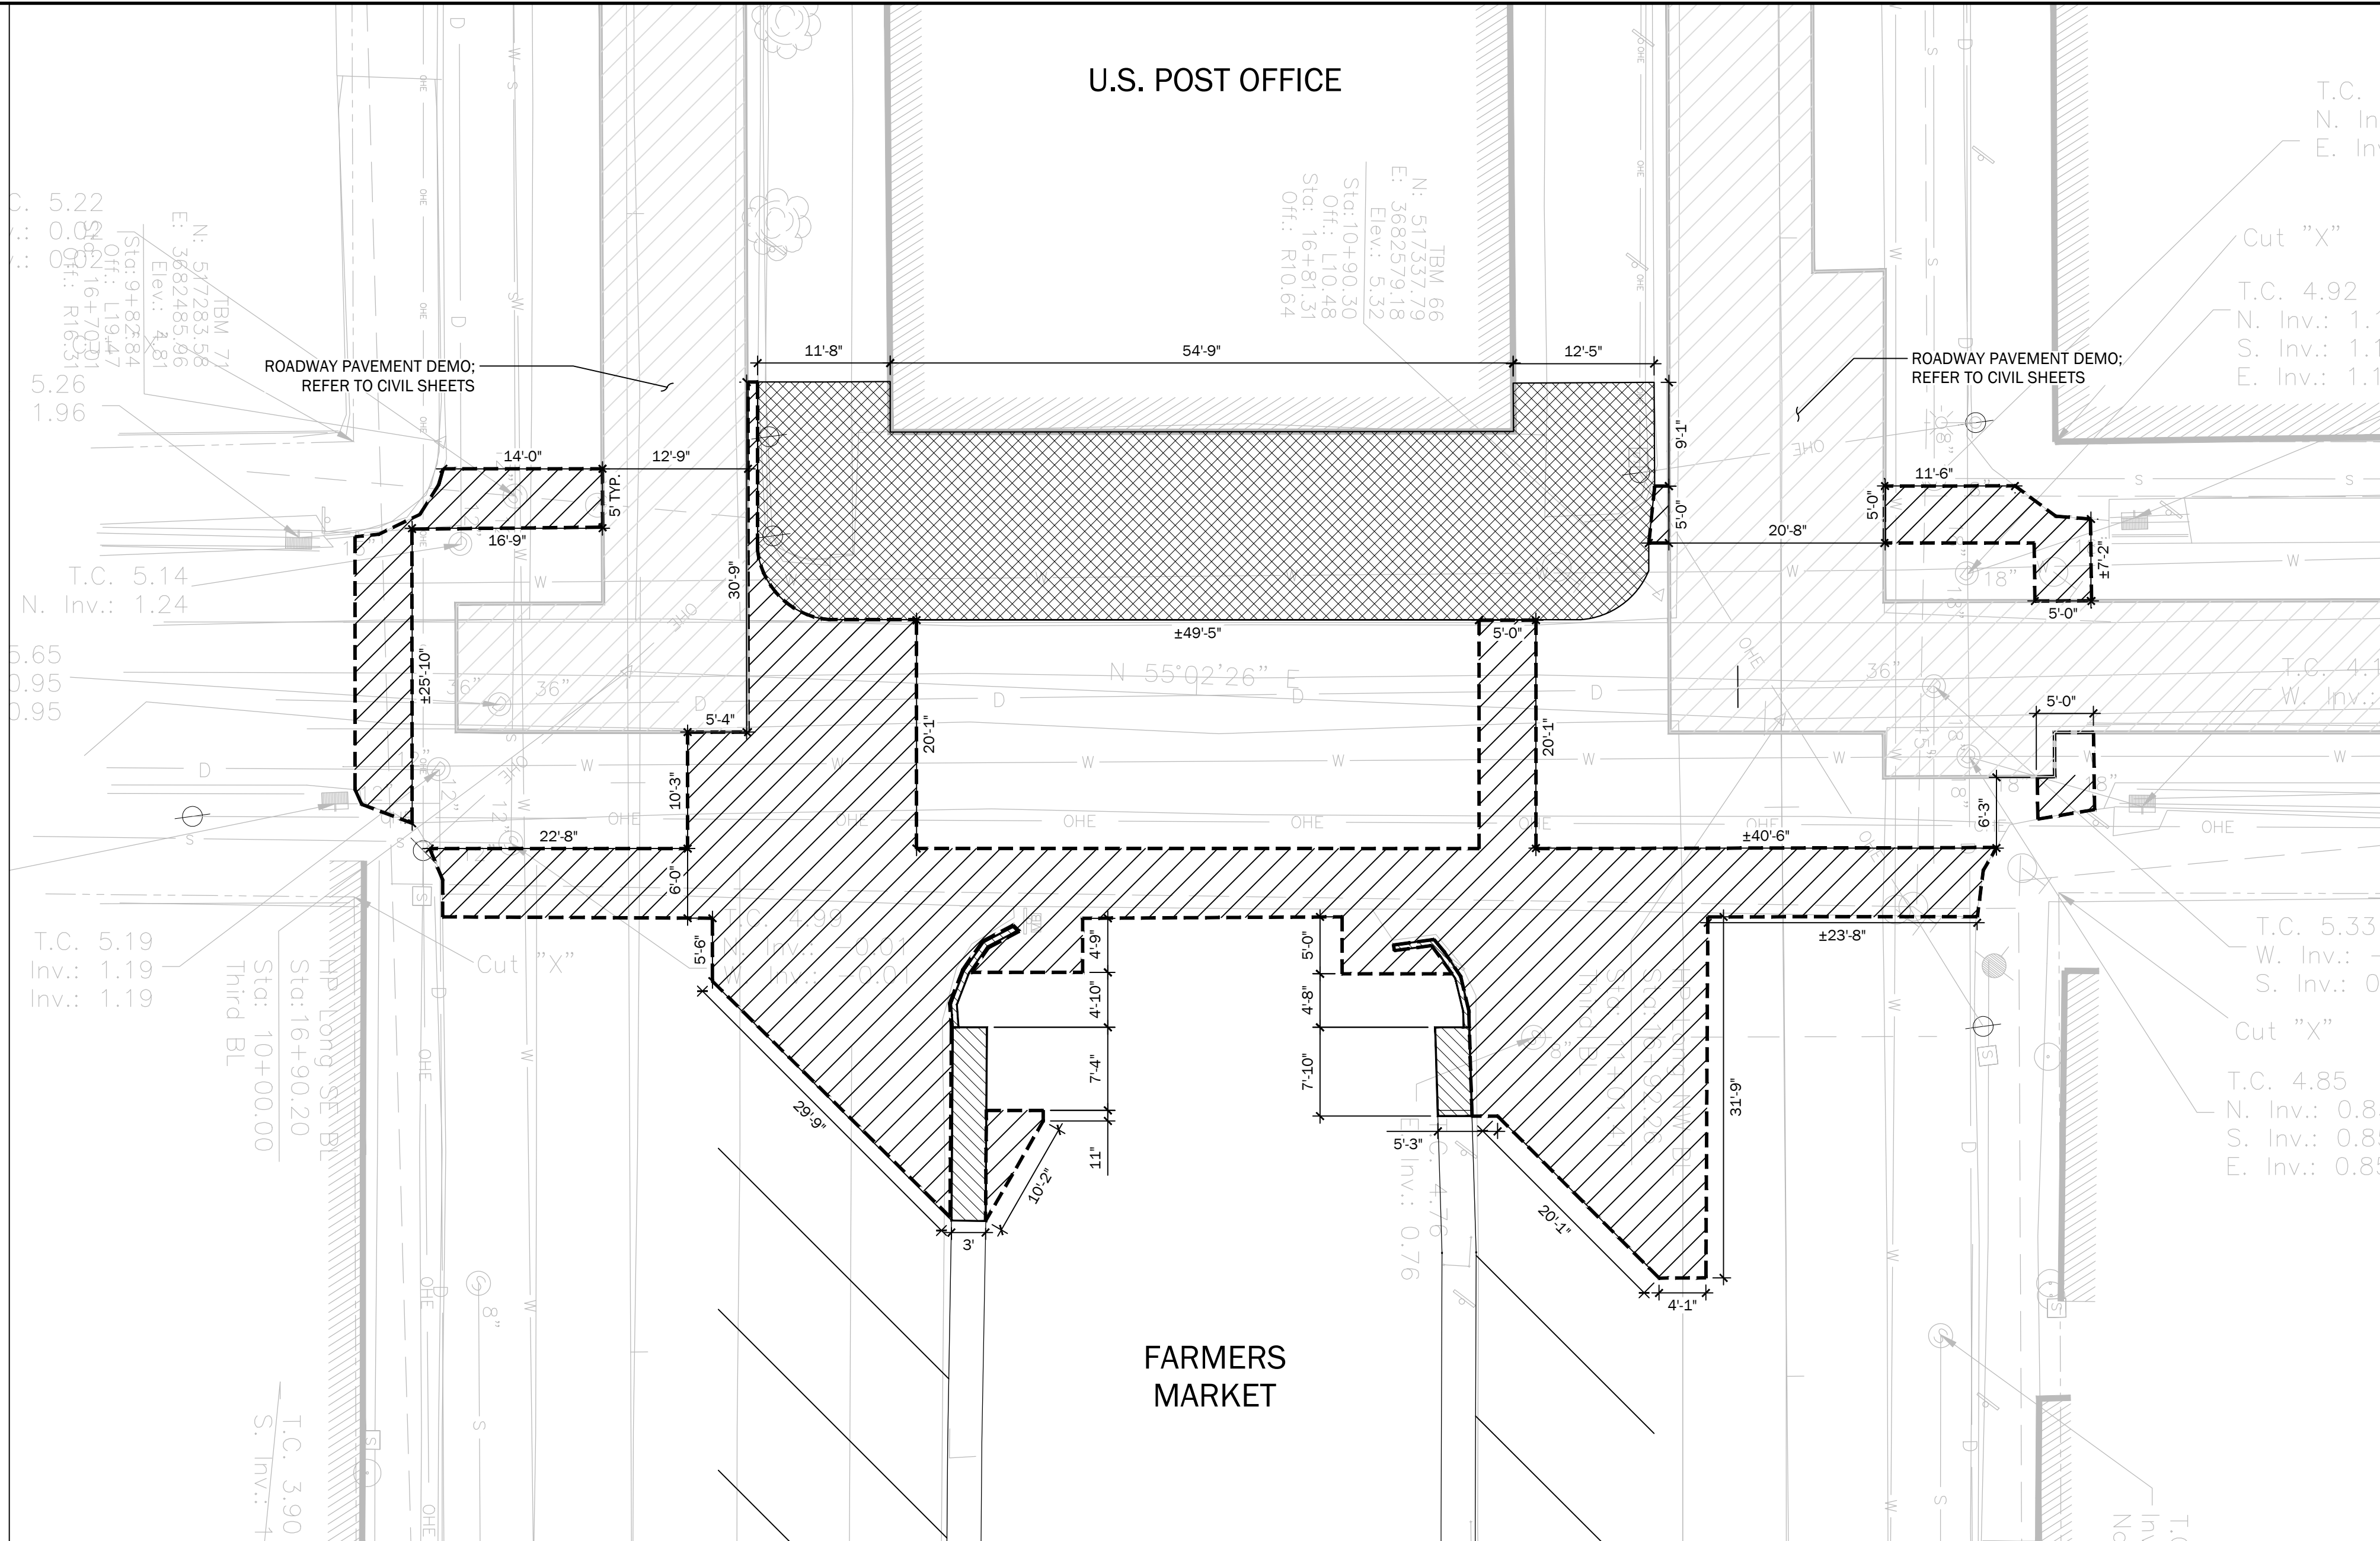


1

DEMOLITION PLAN

scale: $1'' = 10' - 0''$

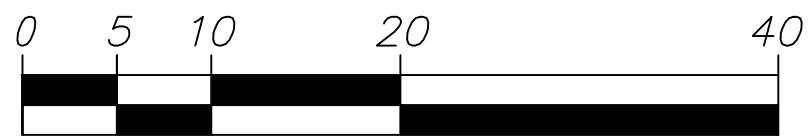

SCALE: 1"=10'-0"

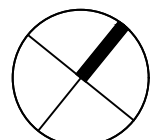

NORTH



GRETNA DOWNTOWN DRAINAGE IMPROVEMENTS (PHASE 2)

DEMOLITION PLAN



BURK-KLEINPETER, INC.





ENGINEERS, ARCHITECTS, PLANNERS, ENVIRONMENTAL SCIENTISTS
4176 CANAL STREET, NEW ORLEANS, LA 70119-5994
PHONE (504)486-5901•FAX (504)488-1714

BKI JOB # - 9344-8320- ADD ALT

					DESIGNED	T.F.
					CHECKED	D.D.
					DETAILED	T.F.
					CHECKED	D.D.
					DATE	DEC. 2021
					SHEET	1


FILE NAME: I:\GRETNA DOWNTOWN DRAINAGE PHASE II (19-15)\CDS\3 - BID SET\1915_BID SET.DWG

LEGEND:

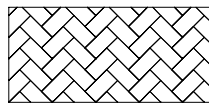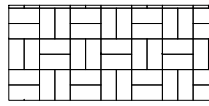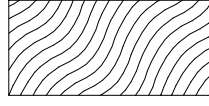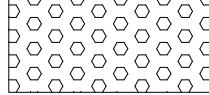-  VEHICULAR PAVERS:
HERRINGBONE W/
SOLIDER COURSE
-  PEDESTRIAN PAVERS:
BASKETWEAVE W/
SOLIDER COURSE
-  BIORETENTION AREA
-  TRUNCATED DOME PAVERS

NOTES:


1. REMOVAL OF ROADWAY SHALL INCLUDE ALL BASE COURSE AND SUBBASE MATERIALS, UNLESS OTHERWISE NOTED.

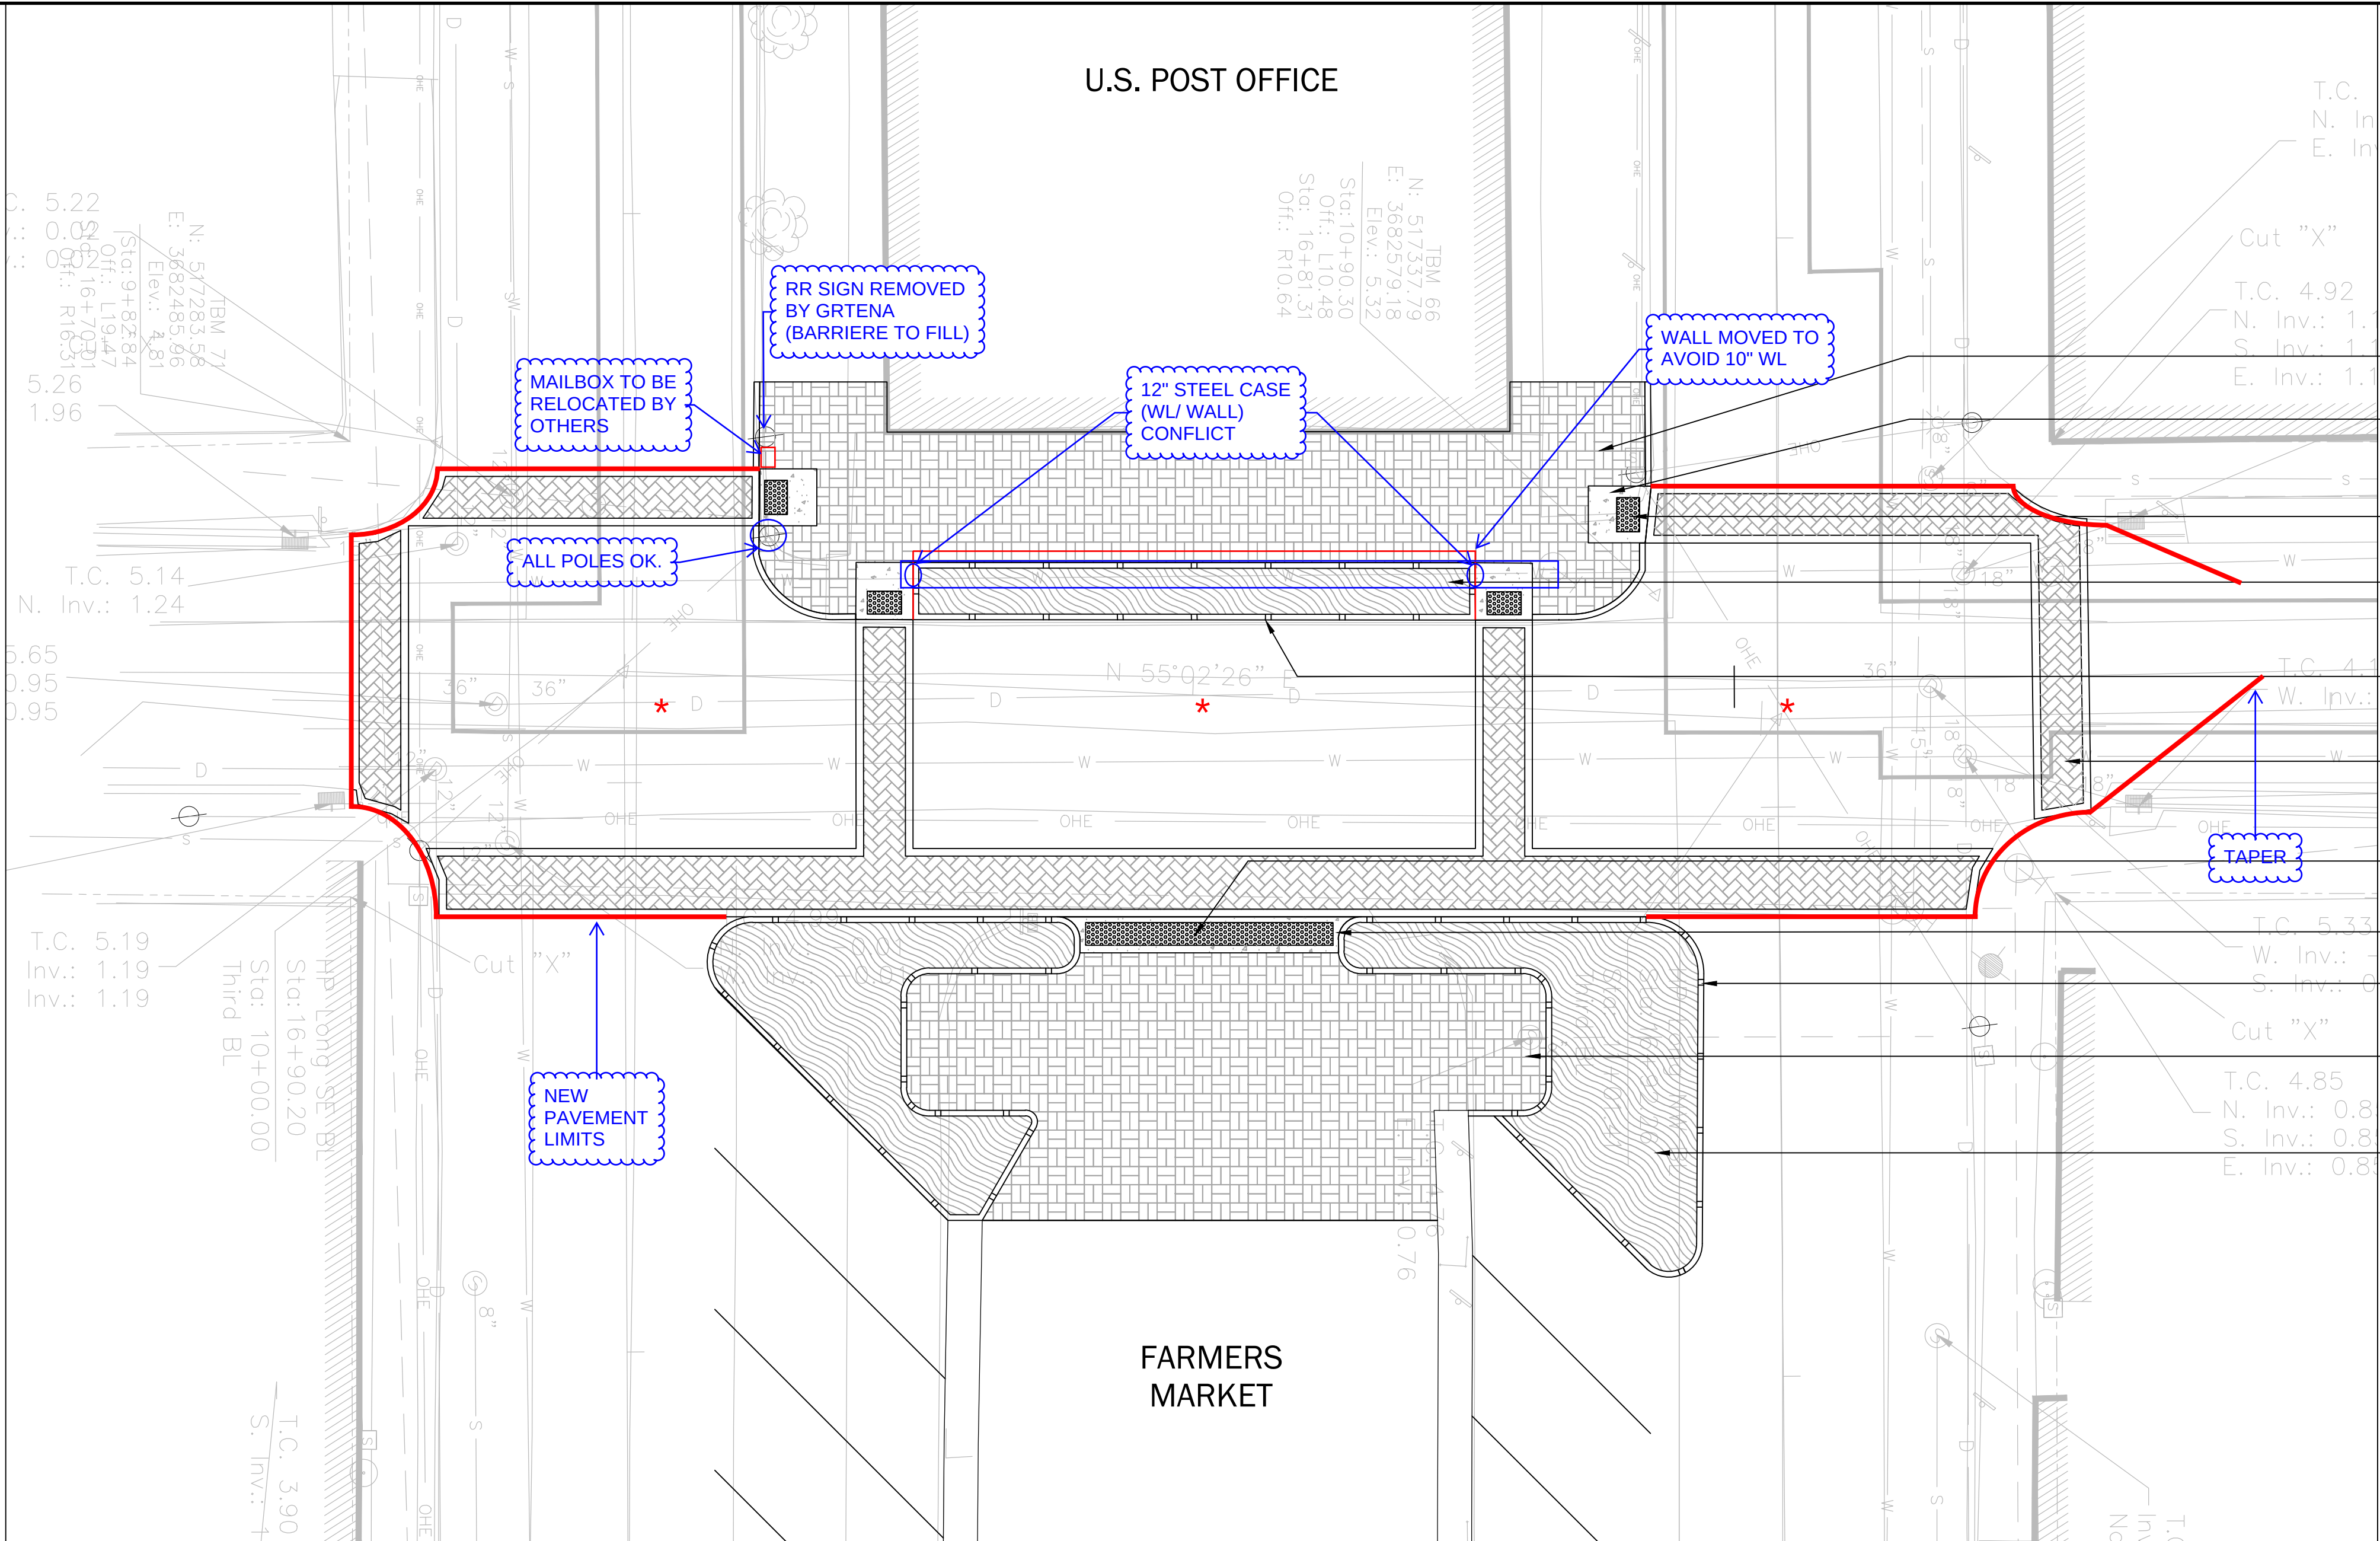

1

MATERIALS PLAN

scale: 1" = 10' - 0"

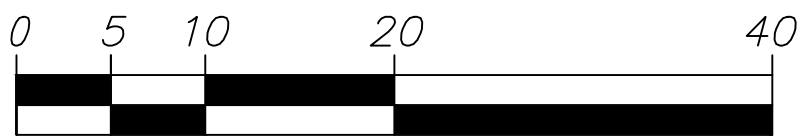

SCALE: 1"=10'-0"

* PAVEMENT CHANGES



- 1
G7

PEDESTRIAN PERVIOUS
PAVERS
- ADA RAMP PER PARISH STANDARDS
- 3
G7

TRUNCATED DOME PAVERS
- 7
G7

STREET BASIN - TYPICAL
SECTION
- 5
G7

CURB GAP INLET
- 2
G7

VEHICULAR PAVERS ON
CONCRETE BASE
- 3
G7

TRUNCATED DOME PAVERS
- ADA RAMP PER PARISH STANDARDS
- 5
G7

CURB GAP INLET
- 1
G7

PEDESTRIAN PERVIOUS
PAVERS
- 7
G7

STREET BASIN - TYPICAL
SECTION

SHEET
NUMBER

63



GRETNA DOWNTOWN DRAINAGE
IMPROVEMENTS (PHASE 2)
MATERIALS PLAN




**BURK-KLEINPETER, INC.**
ENGINEERS, ARCHITECTS, PLANNERS, ENVIRONMENTAL SCIENTISTS
440 CALLE REYES, SUITE 200, NEW ORLEANS, LA 70119-5994
PHONE (504)486-5501 • FAX (504)486-1714

BKI JOB # — 9344-8320— ADD ALT

DESIGNED	T.F.
CHECKED	D.D.
DETAILED	T.F.
CHECKED	D.D.
DATE	DEC, 2021
SHEET	1 OF 1

NO.	DATE	REVISION DESCRIPTION	BY

FILE NAME: I:\GRETNA DOWNTOWN DRAINAGE PHASE II (19-15)\CDS\3 - BID SET\1915_BID SET.DWG

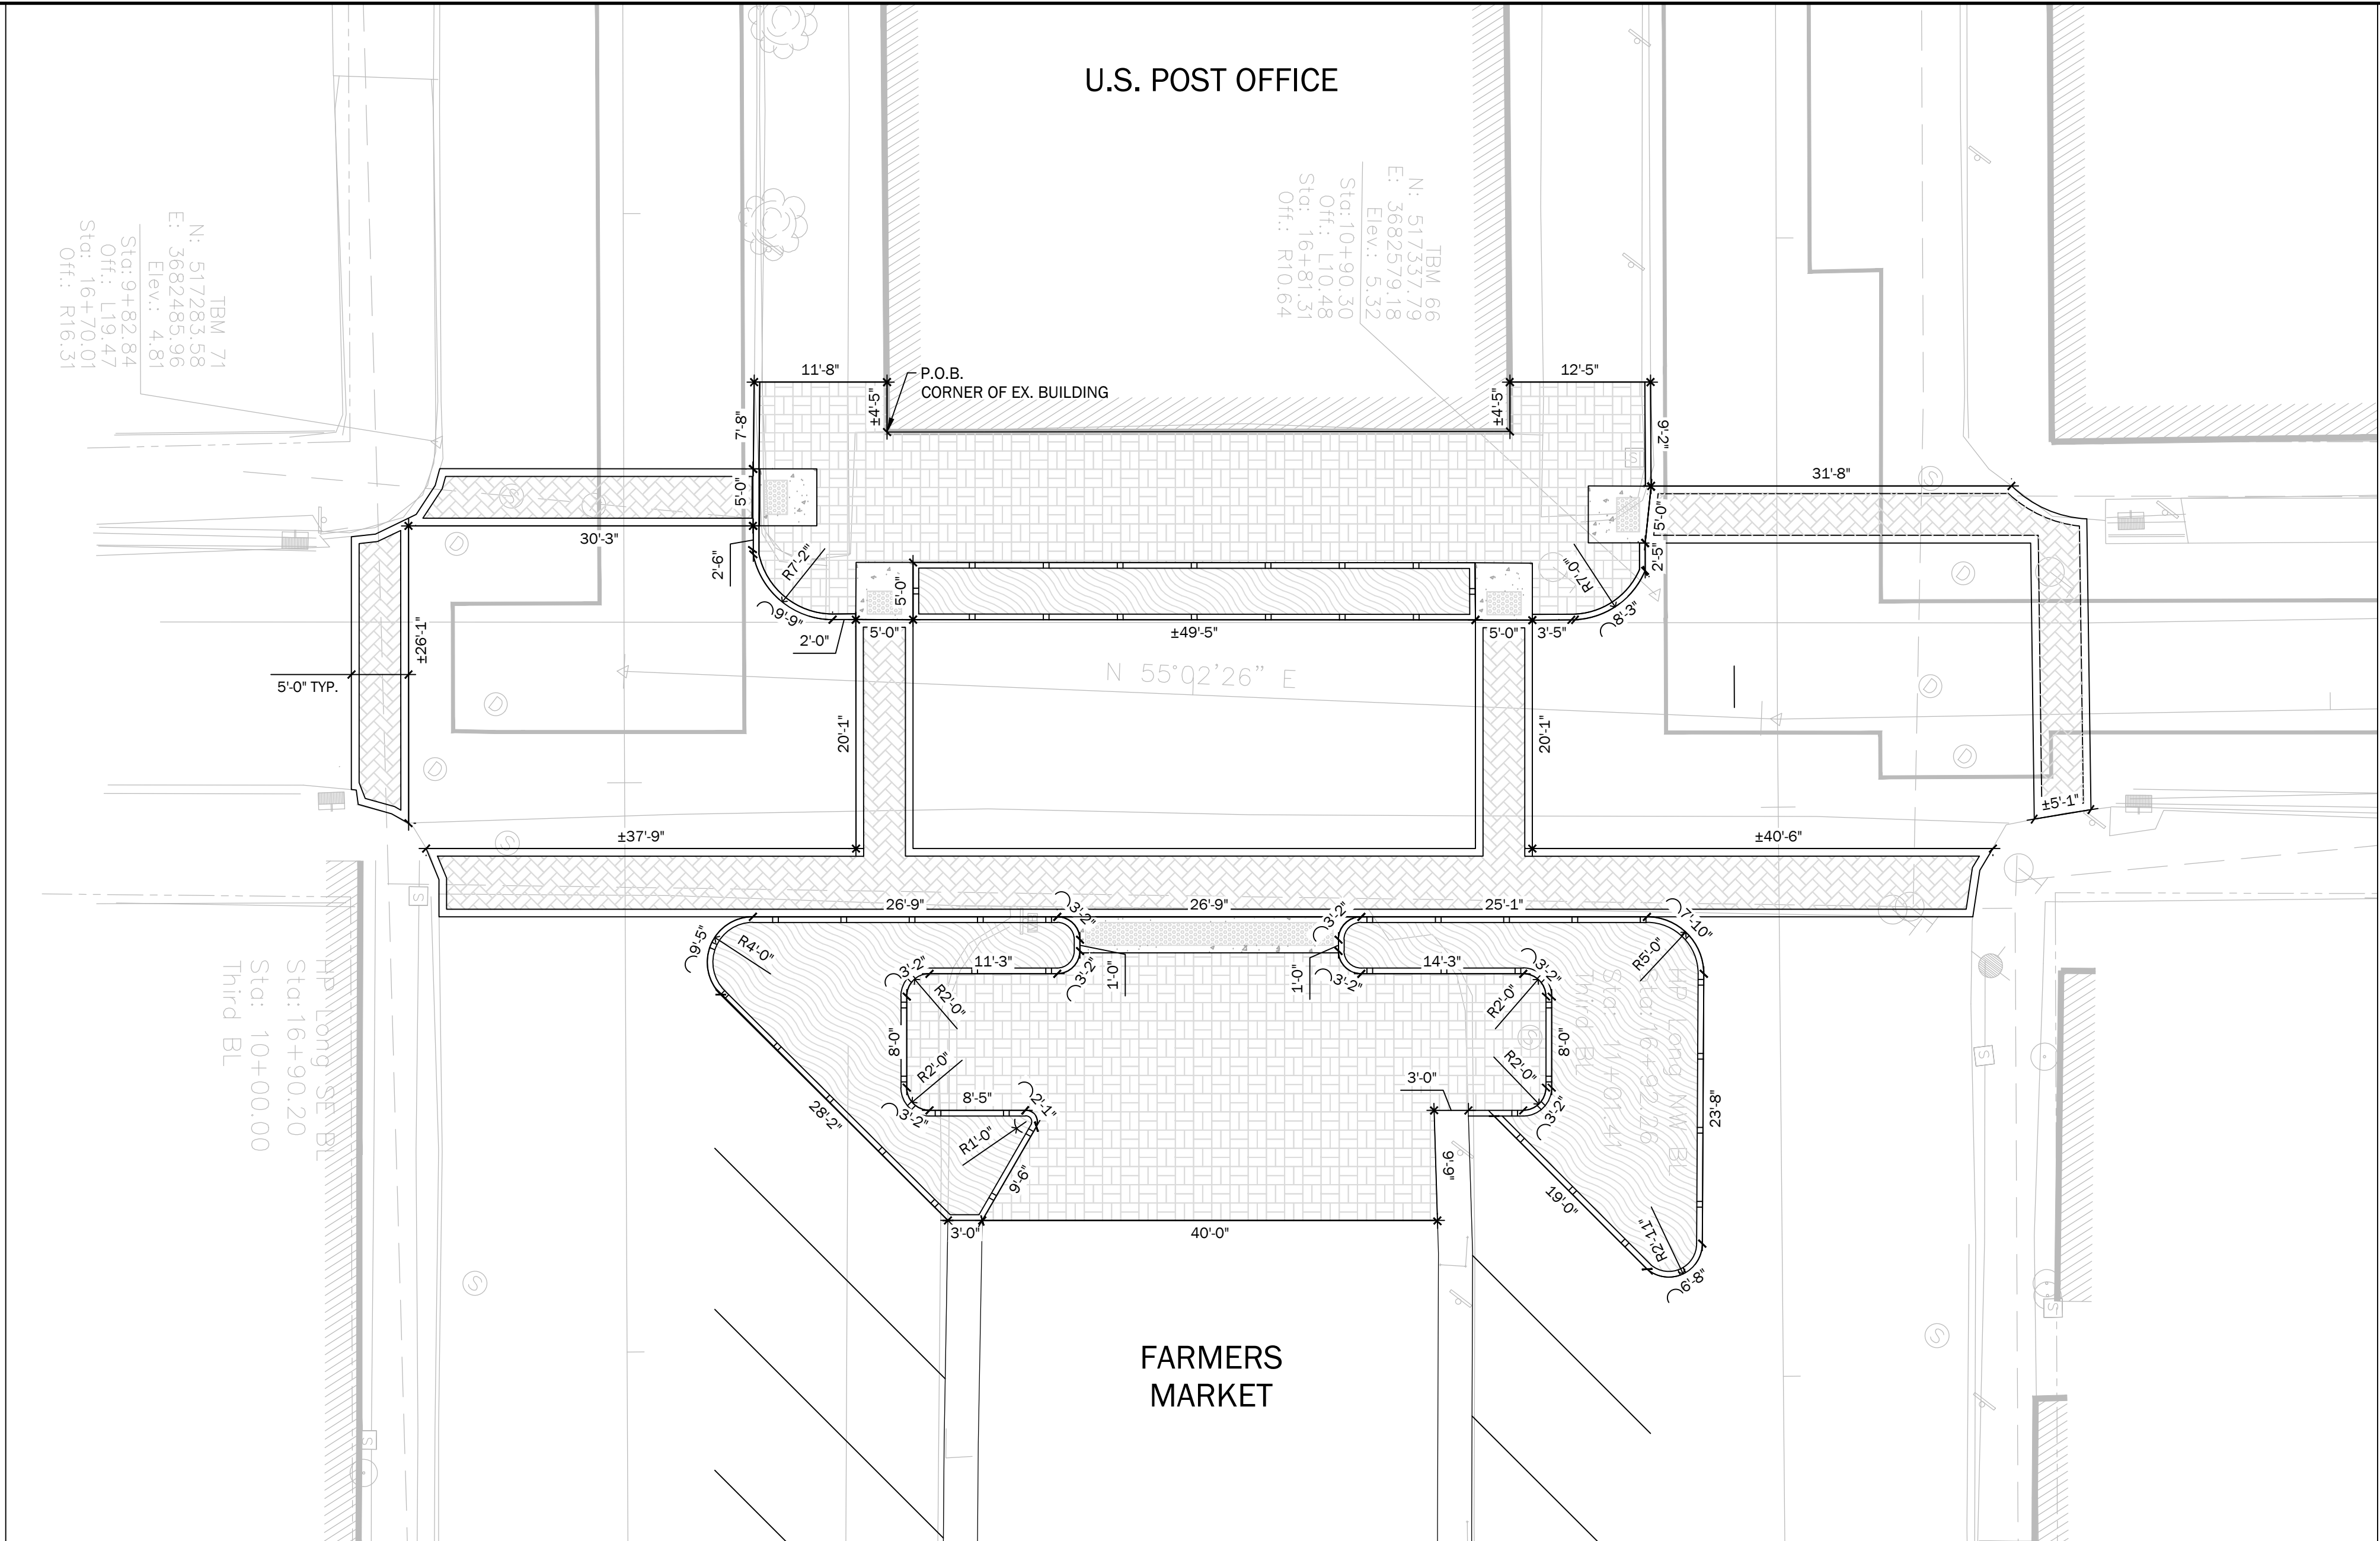

1 LAYOUT PLAN
scale: 1" = 10' - 0"



SHEET
NUMBER

G4



GRETNA DOWNTOWN DRAINAGE
IMPROVEMENTS (PHASE 2)
LAYOUT PLAN



**BURK-KLEINPETER, INC.**
ENGINEERS, ARCHITECTS, PLANNERS, ENVIRONMENTAL SCIENTISTS
440 Poydras Street, Suite 2100, New Orleans, LA 70112-3199
PHONE (504)486-5501 • FAX (504)486-1714

BKI JOB # — 9344-8320— ADD ALT

DESIGNED	T.F.	CHECKED	D.D.
	CHECKED		D.D.
DATE	DEC, 2021	SHEET	1 OF 1
NO.	DATE	REVISION DESCRIPTION	
		BY	

LEGEND:

———— SOLID PVC PIPE (6 INCH

--- PERFORATED PVC PIPE (6 INCH)

STAND PIPE $\frac{6}{G7}$

0.00 — PROPOSED ELEVATION


M.E.  MEET EXISTING

BOC ———+
TOC

BOC: BOTTOM OF CURB
TOC: TOP OF CURB

NOTES


1. ALL CROSSWALKS TO FOLLOW THE SLOPE OF THE ROADWAY PROFILE.
 - 1.1. MAX CROSS SLOPE ON CROSSWALKS SHALL BE 2%.
2. CROSSWALKS SHALL MEET THE EXISTING GRADE OF THE SIDEWALKS OR ADA RAMP

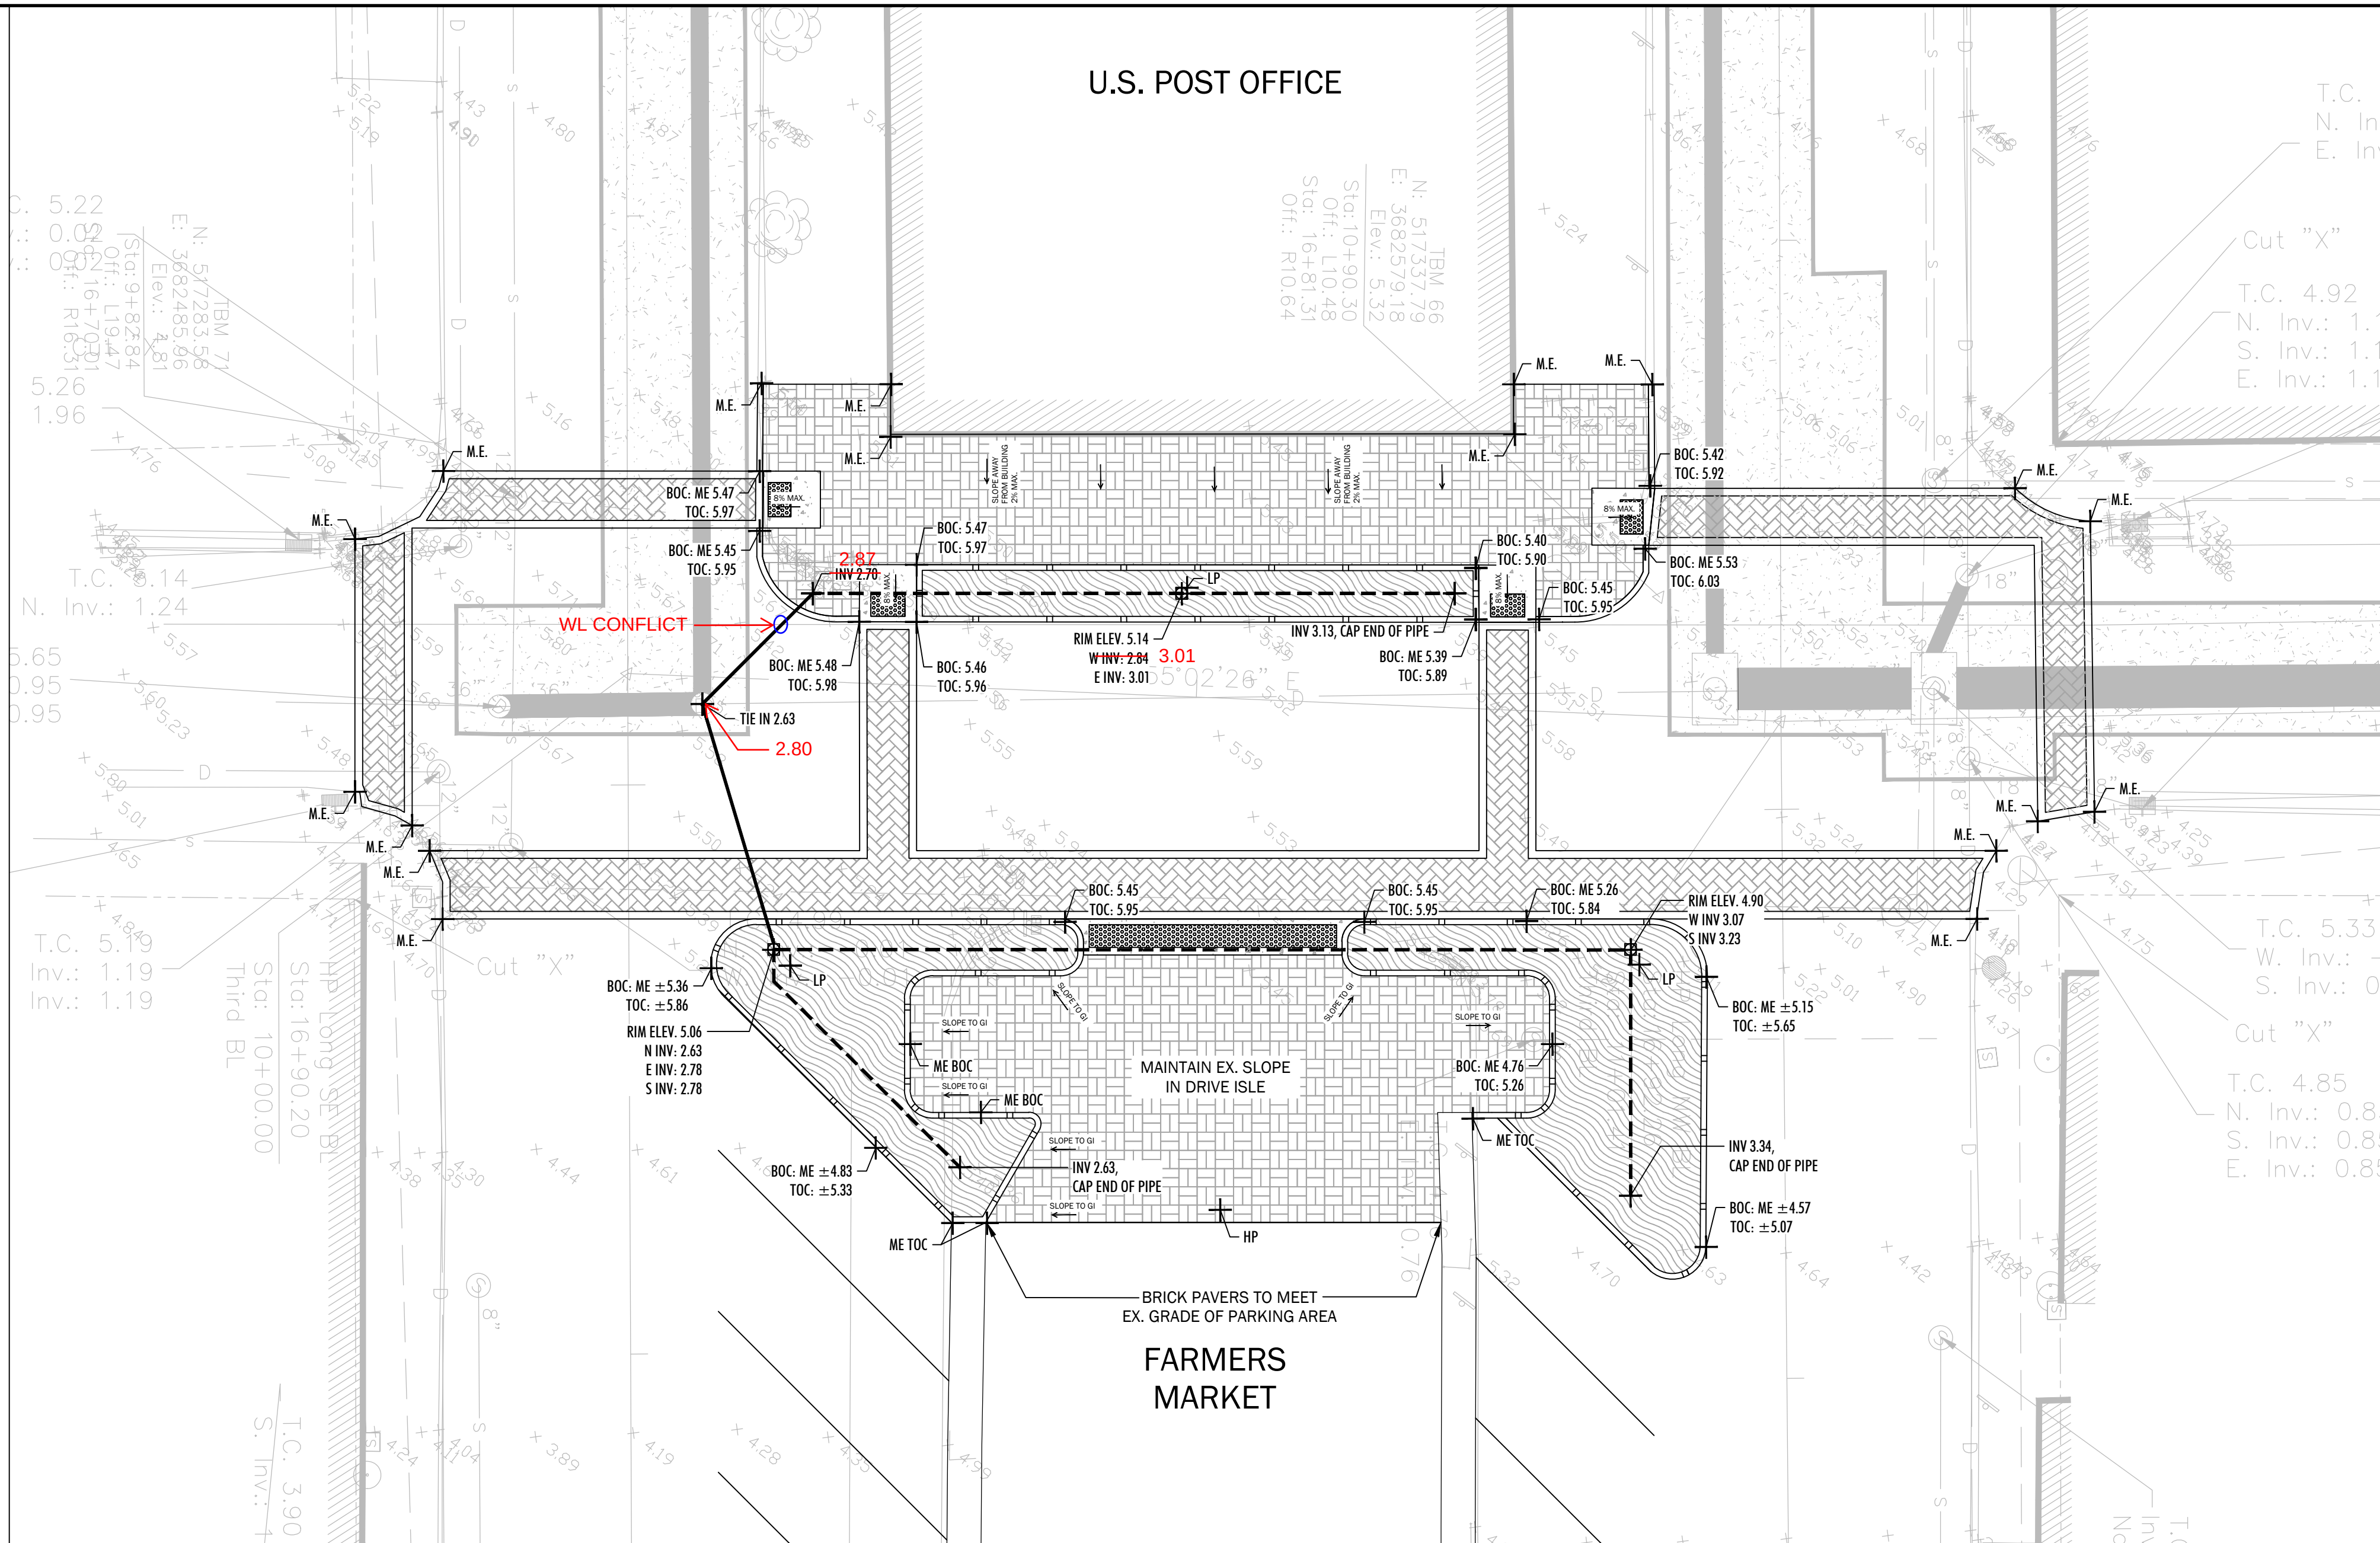


1

GRADING & STORMWATER PLAN

scale: $1'' = 10' - 0''$

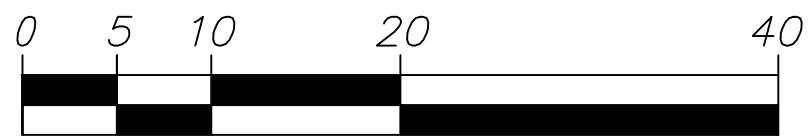

SCALE: 1"=10'-0"

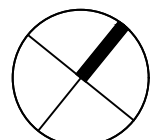

NORTH



GRETNA DOWNTOWN DRAINAGE
IMPROVEMENTS (PHASE 2)
GRADING & STORMWATER PLAN



BURK-KLEINPETER, INC.
ENGINEERS, ARCHITECTS, PLANNERS, ENVIRONMENTAL SCIENTISTS
4176 CANAL STREET, NEW ORLEANS, LA 70119-5994
PHONE (504)486-5901 • FAX (504)488-1714

BKI JOB # - 9344-8320- ADD ALT

[illegible]

FILE NAME: I:\GRETNA DOWNTOWN DRAINAGE PHASE II (19-15)\CDS\3 - BID SET\1915_BID SET.DWG

PLANT SCHEDULE			
SHRUBS	BOTANICAL NAME	COMMON NAME	SIZE
	Agapanthus africanus	African Lily	1 gal.
	Liriope muscari 'Big Blue'	Big Blue Lilyturf	2.5 qt.

- SHRUB PLANTING - PLAN
- 2
- G8
- BIORETENTION PLANTING WITH AGGREGATE - SECTION
- 1
- G8

Liriope muscari 'Big Blue'
(239)


Agapanthus africanus
(79)

AP 10th St. BL
Sta: 16+90.20
Sta: 10+00.00
Third BL

1

PLANTING PLAN

scale: 1" = 10' - 0"

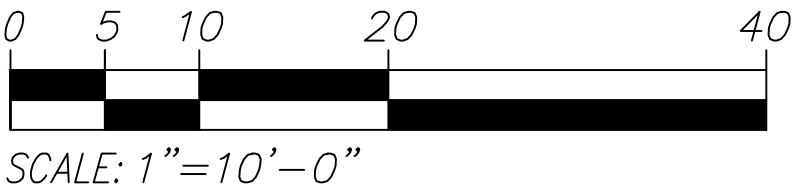

U.S. POST OFFICE

FARMERS MARKET



Agapanthus africanus
(48)

Liriope muscari 'Big Blue'
(104)

Liriope muscari 'Big Blue'
(240)

Agapanthus africanus
(105)

SHEET NUMBER

G6



GRETNA DOWNTOWN DRAINAGE IMPROVEMENTS (PHASE 2)

PLANTING PLAN



**BURK-KLEINPETER, INC.**


ENGINEERS, ARCHITECTS, PLANNERS, ENVIRONMENTAL SCIENTISTS
414 Poydras Street, Suite 2000, New Orleans, LA 70119-5994
PHONE (504) 486-5501 • FAX (504) 486-7174

BKI JOB # — 9344-8320 — ADD ALT

					DESIGNED	T.F.
					CHECKED	D.D.
					DETAILED	T.F.
					CHECKED	D.D.
					DATE	DEC. 2021
					SHEET	1 OF 1



NOTES:
1. ENSURE ADJACENT SURFACES FLOW INTO PLANTING AREA

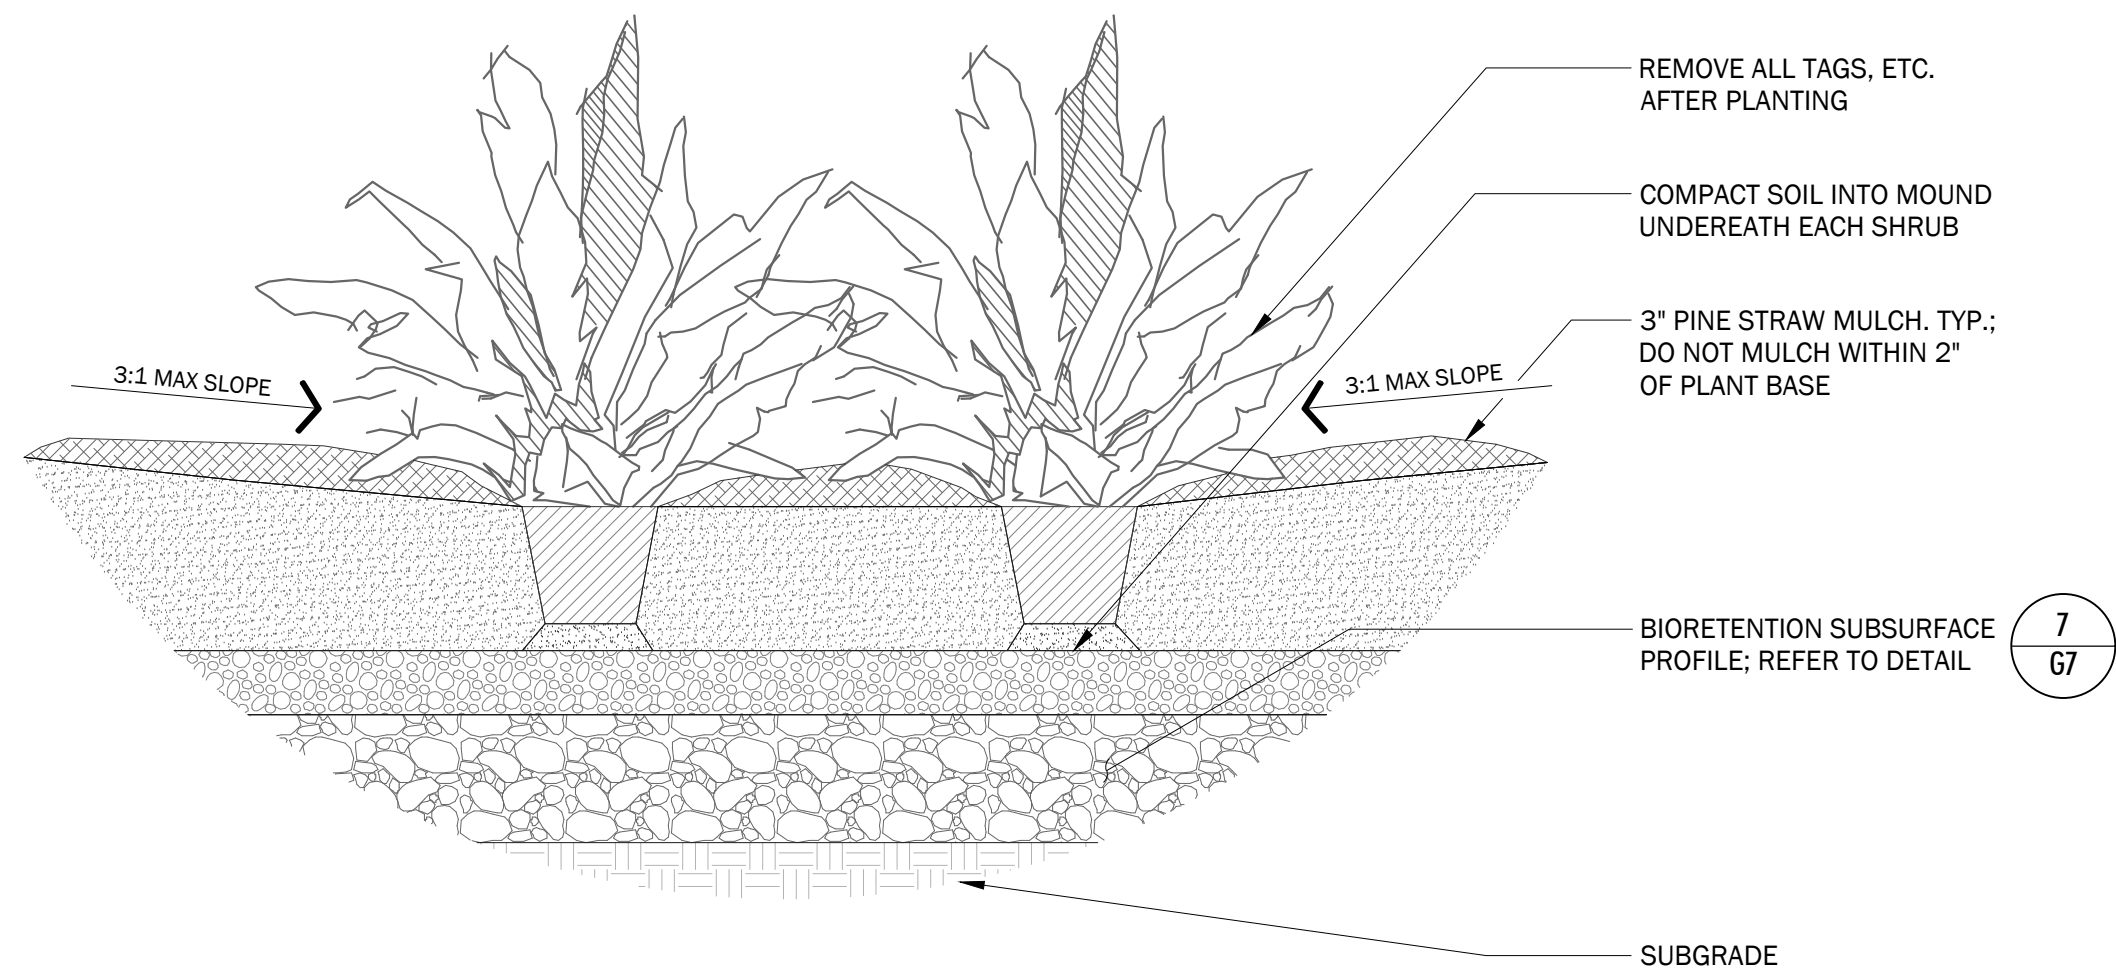


1 BIORETENTION PLANTING WITH AGGREGATE - SECTION

$$1'' = 1' - 0''$$

P-1915-04

NOTES:

1. SEE PLANTING LEGEND FOR SHRUB SPECIES, SIZE, AND SPACING.
2. SETTLE SOIL AROUND ROOT BALL OF EACH PLANT PRIOR TO MULCHING.

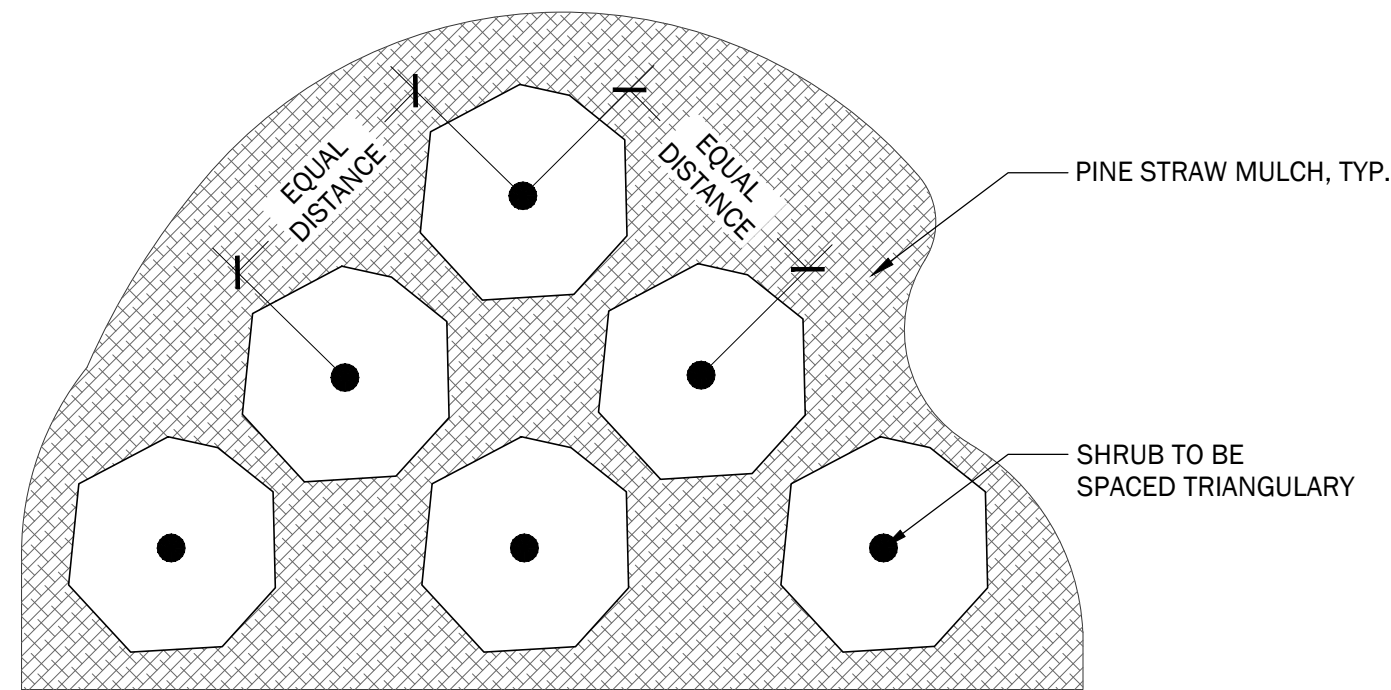

2 SHRUB PLANTING - PLAN

$$3/4'' = 1'-0''$$


32 9333-01

				CHECKED.	D.D.
				DETAILED	T.F.
				CHECKED	D.D.
				DATE	DEC. 2021
				SHEET	1 OF 1
No.	Date	Revision Description	By		

GREटना DOWNTOWN

DRAINAGE IMPROVEMENTS (PHASE 2)

ASBUILT PLANS

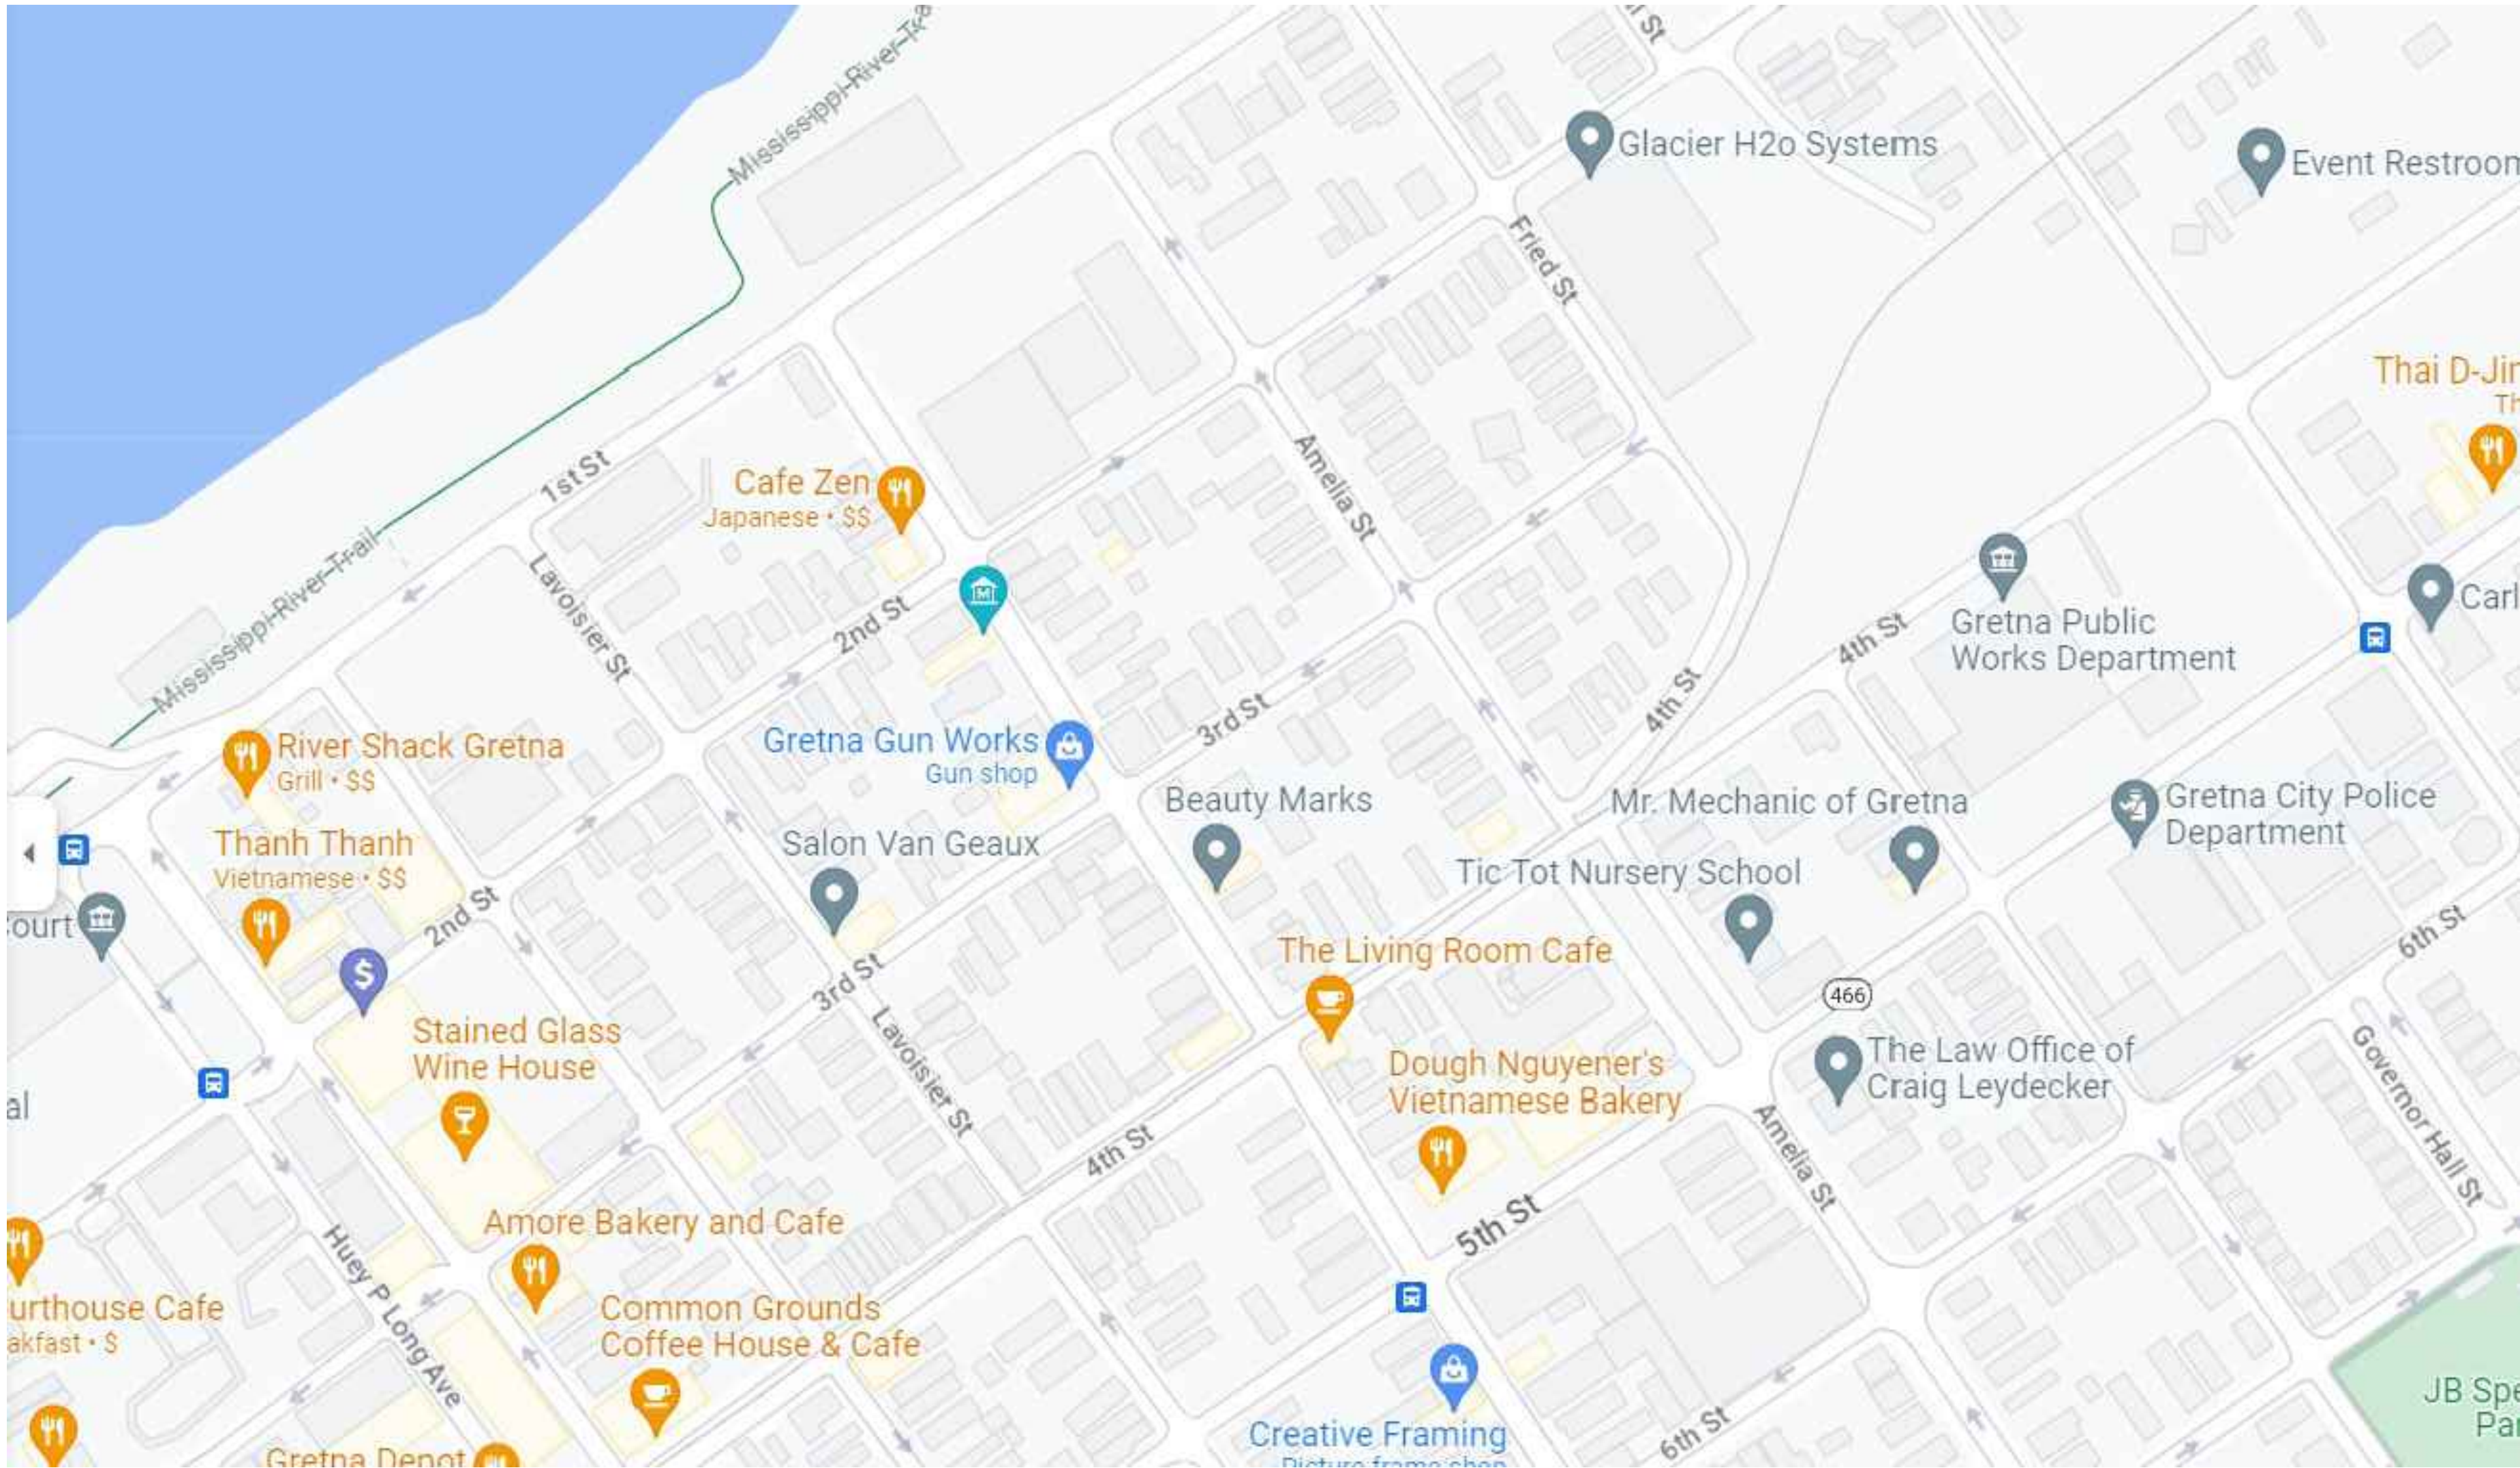

VICINITY MAP

INDEX

SHEET NO.	DESCRIPTION
C 001 A001-A006	COVER AND VICINITY MAP UTILITY & ROADWAY ASBUILTS

B

BARRIERE

CONSTRUCTION

A CRH COMPANY

Jon Number: 220057.000


Gretna, La 70053

Gretna Downtown
Drainage Improvements

Drawing Title:
Cover Sheet

Notes:

C001

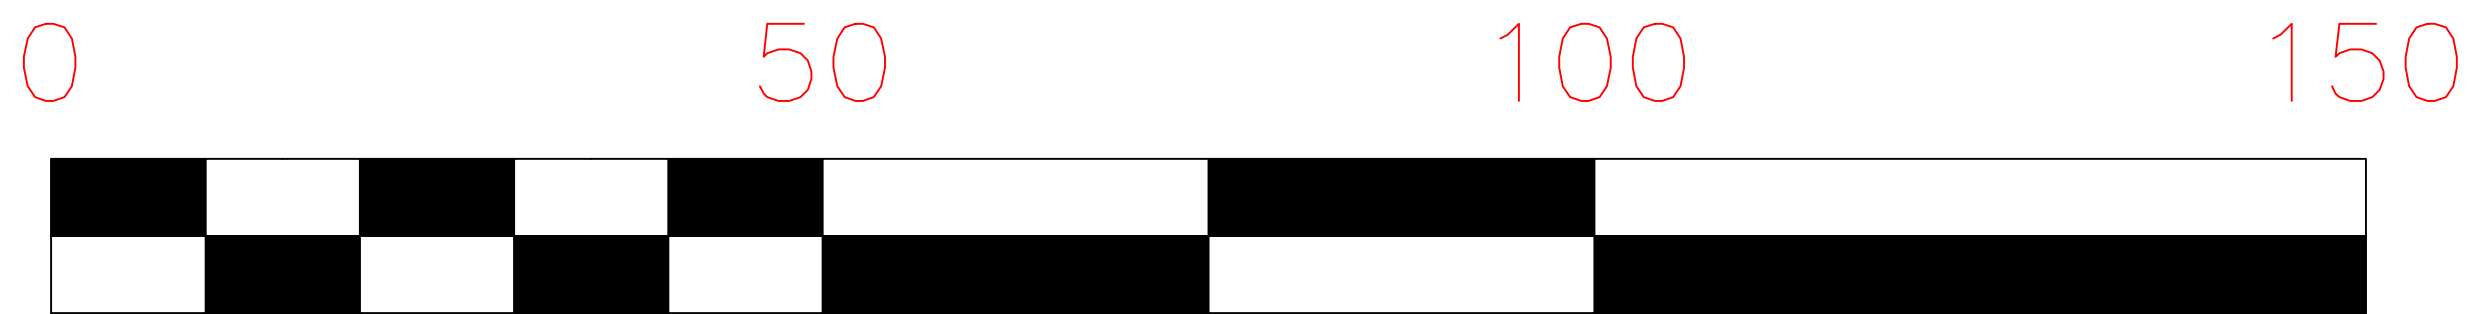

STA 9+88.87
EXIST. DMH
T.C.=5.65
INV.= -1.33

HUEY P. LONG AVE.
(SE BOUND LANE)

MATCHLINE 17+50.00

HUEY P. LONG AVE.
(NW BOUND LANE)

STA 16+78.53
DMH 205
T.C.=5.65
INV.= -0.93

STA 10+95.51
DMH 305
T.C.=5.35
INV.= -0.90

STA 18+50.00
EXIST CONFLICT BOX 100
T.C.=5.35
INV.= -0.76

THIRD ST.


S/W R&R

EX. 18" RCP

EX. 18" RCP

LIMITS OF CONCRETE

MATCHLINE 13+50.00

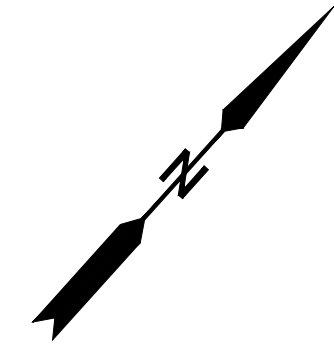

Drawing Title:

Notes:

A001

Utility & Roadway
Asbuilts


Gretna Downtown
Drainage Improvements

Gretna, La 70053

Jon Number:

220057.000

B **BARRIERE**
CONSTRUCTION
A CRH COMPANY

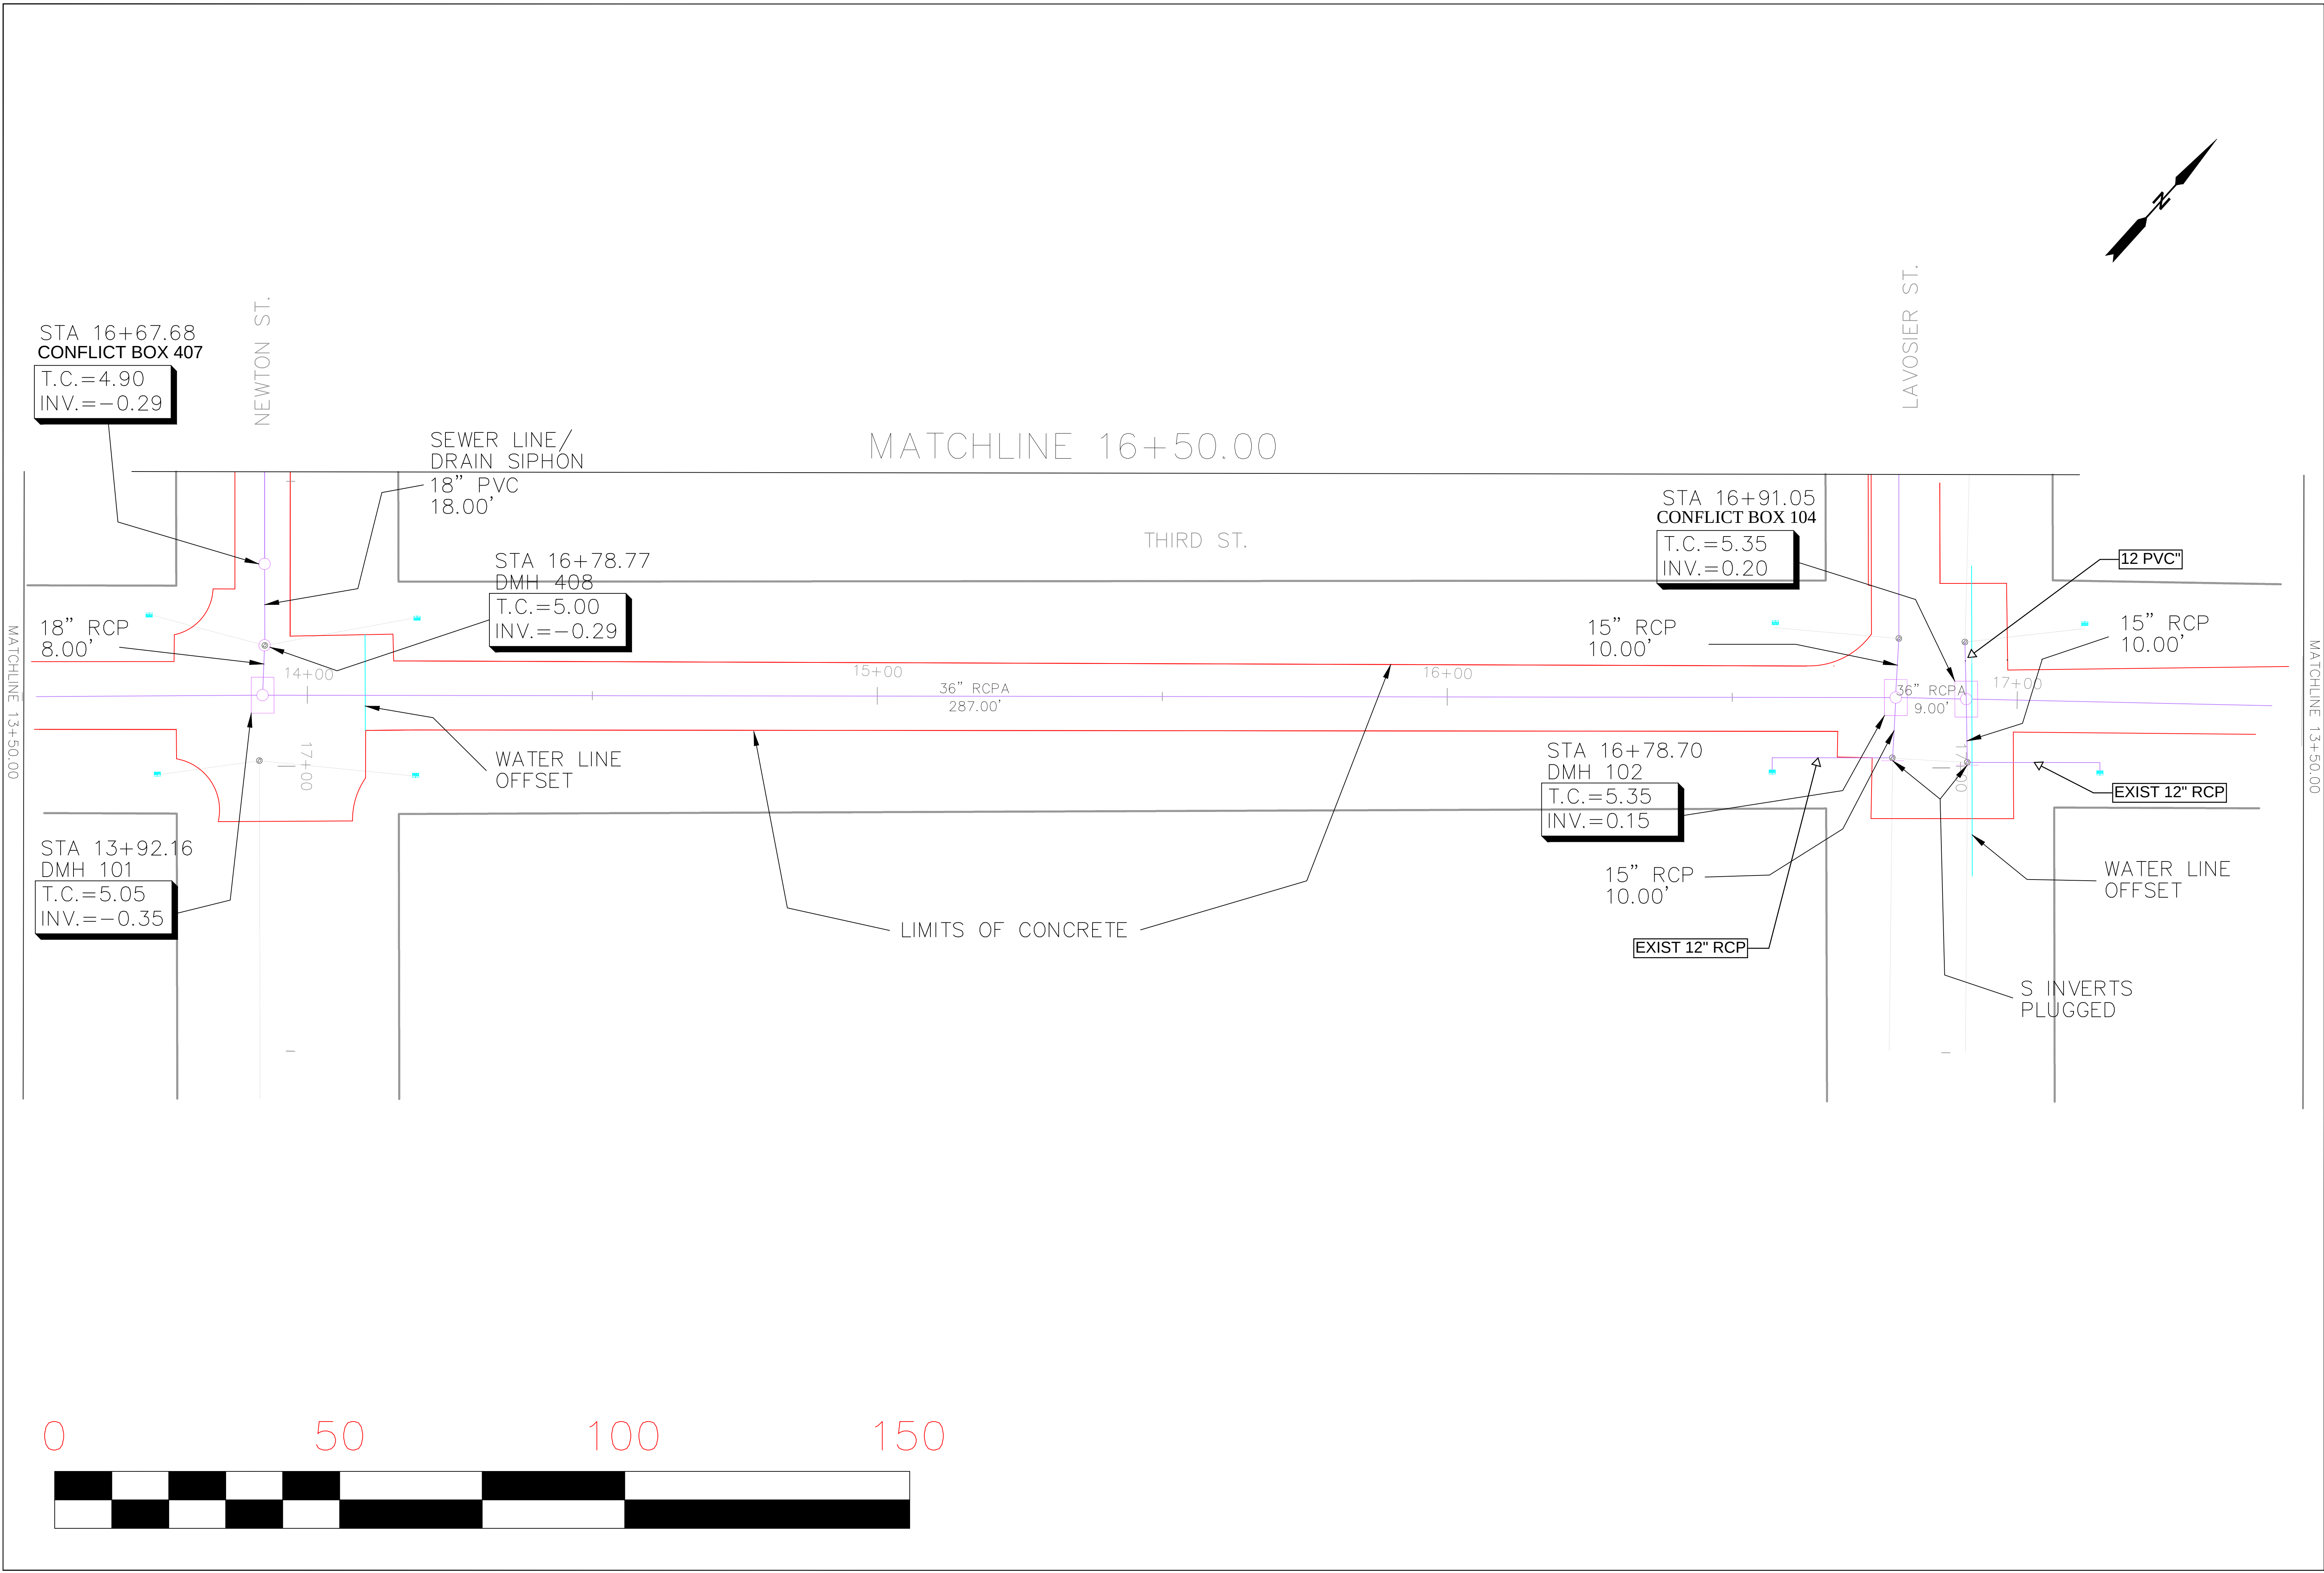

**BARRIERE**
CONSTRUCTION
A CRH COMPANY

Jon Number:
220057.000

Gretna Downtown
Drainage Improvements

 


Gretna, La 70053

Drawing Title:
**Utility & Roadway
Asbuilts**

Notes:

A002

*size of pipe was changed from 15" to 12" rcp due to an existing waterline conflict in the invert elevation.

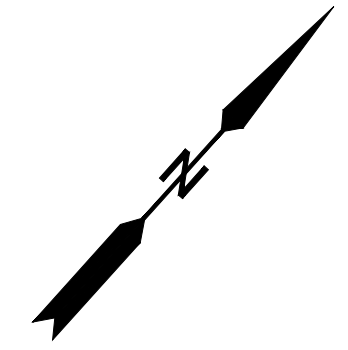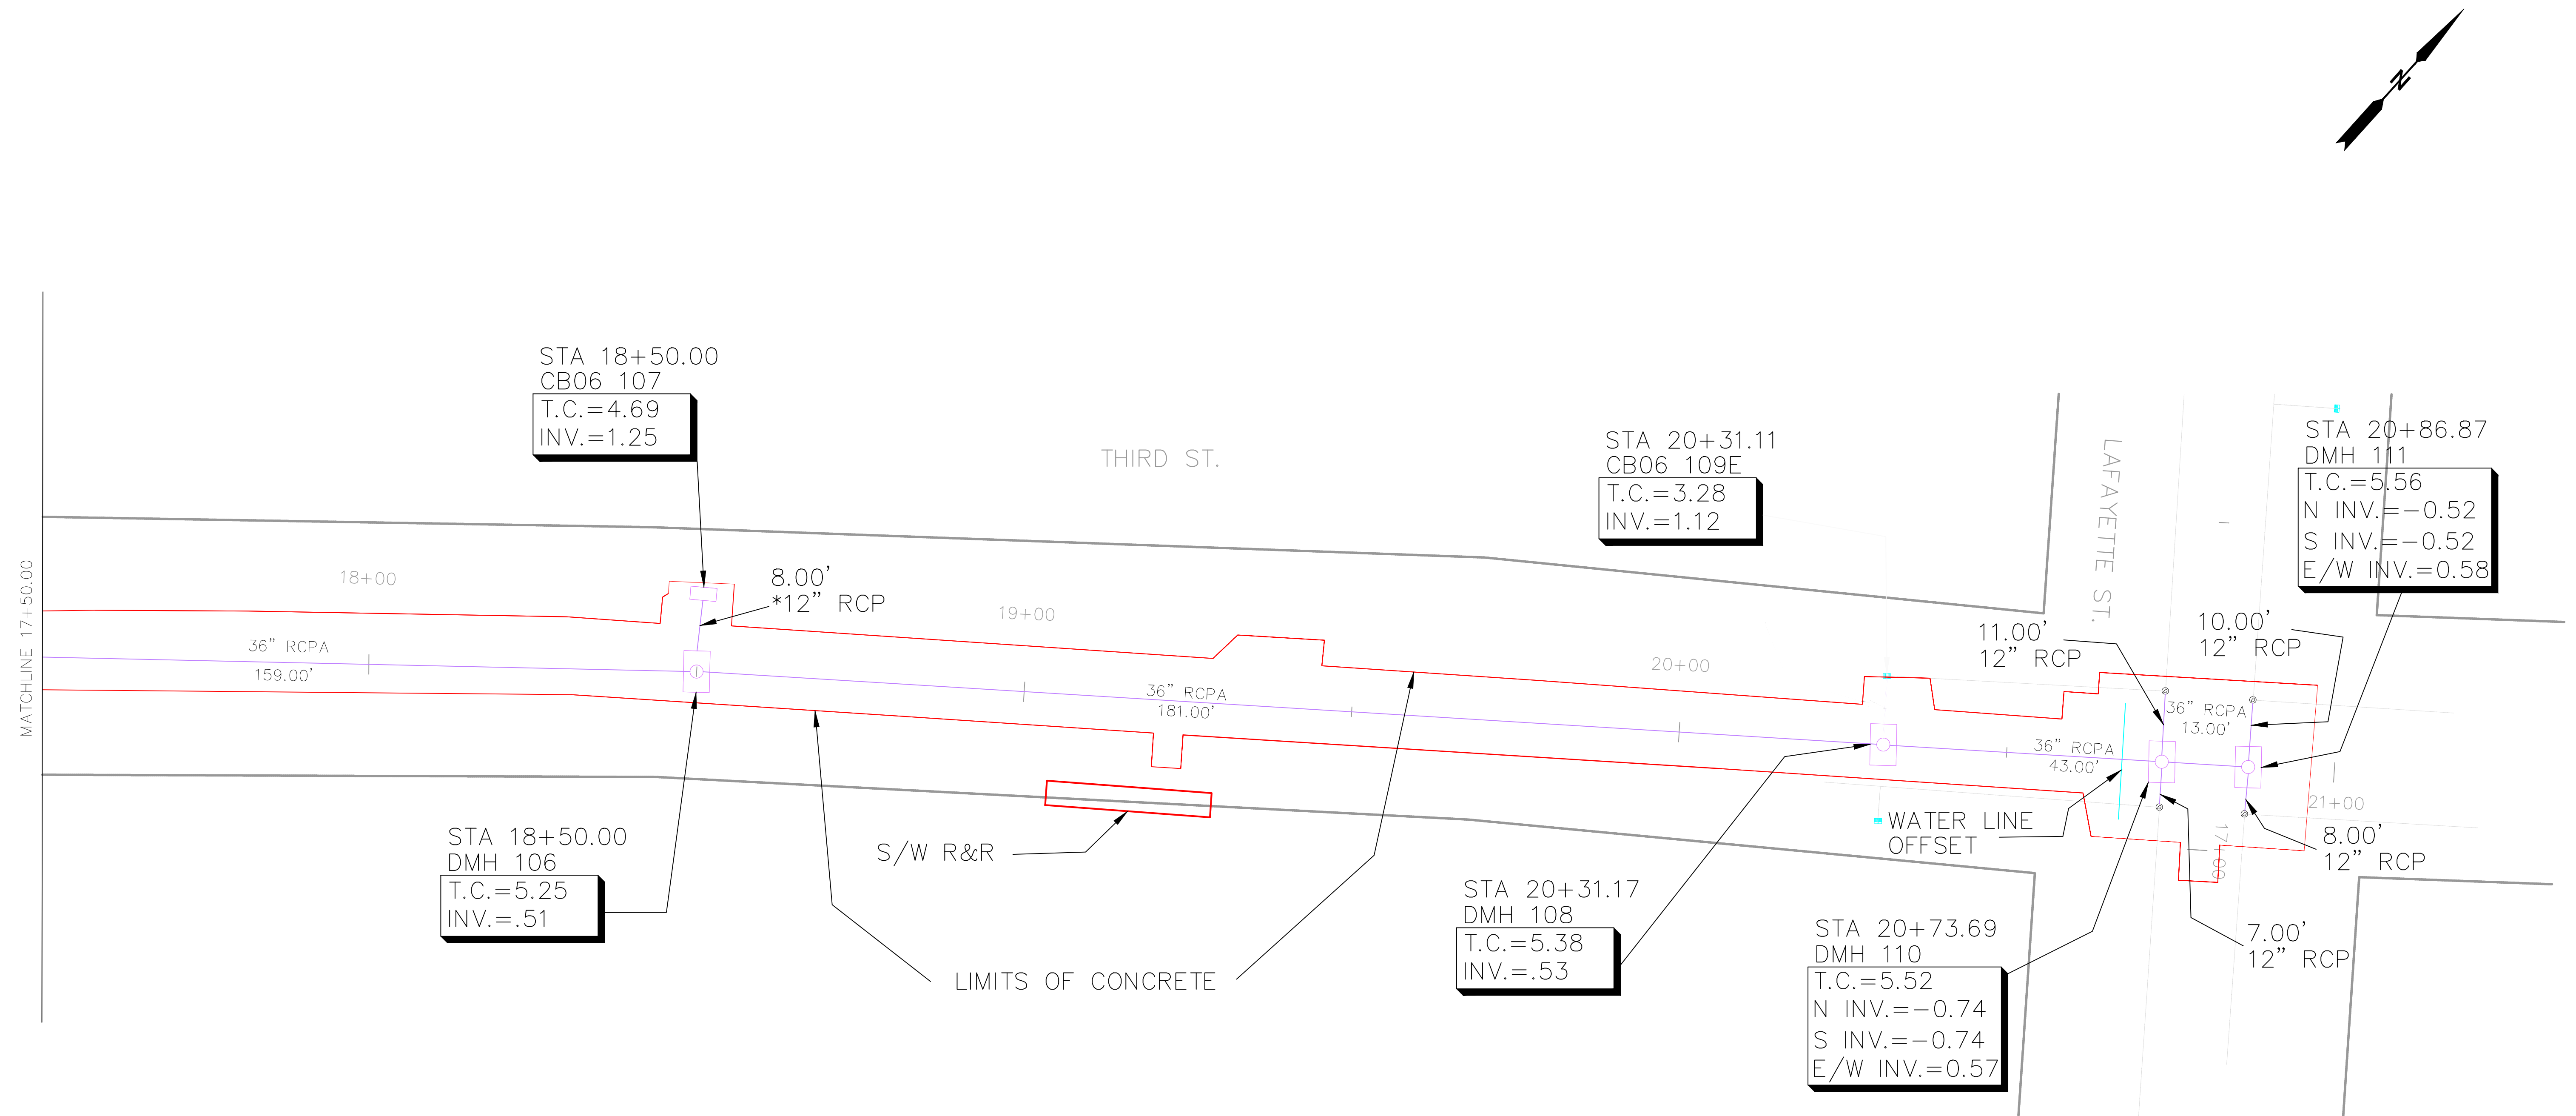

BARRIERE
CONSTRUCTION
A CRH COMPANY

you intend.

220057.000

Gretna, La 70053

Gretna Downtown Drainage Improvements



Drawing IIIc.

Utility & Roadway Asbuilts



Notes:




A003

MATCHLINE 16+50.00

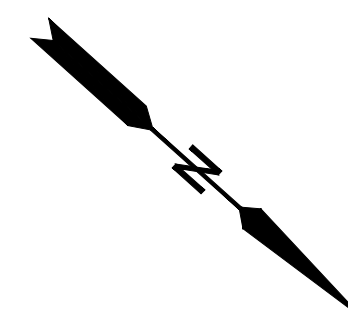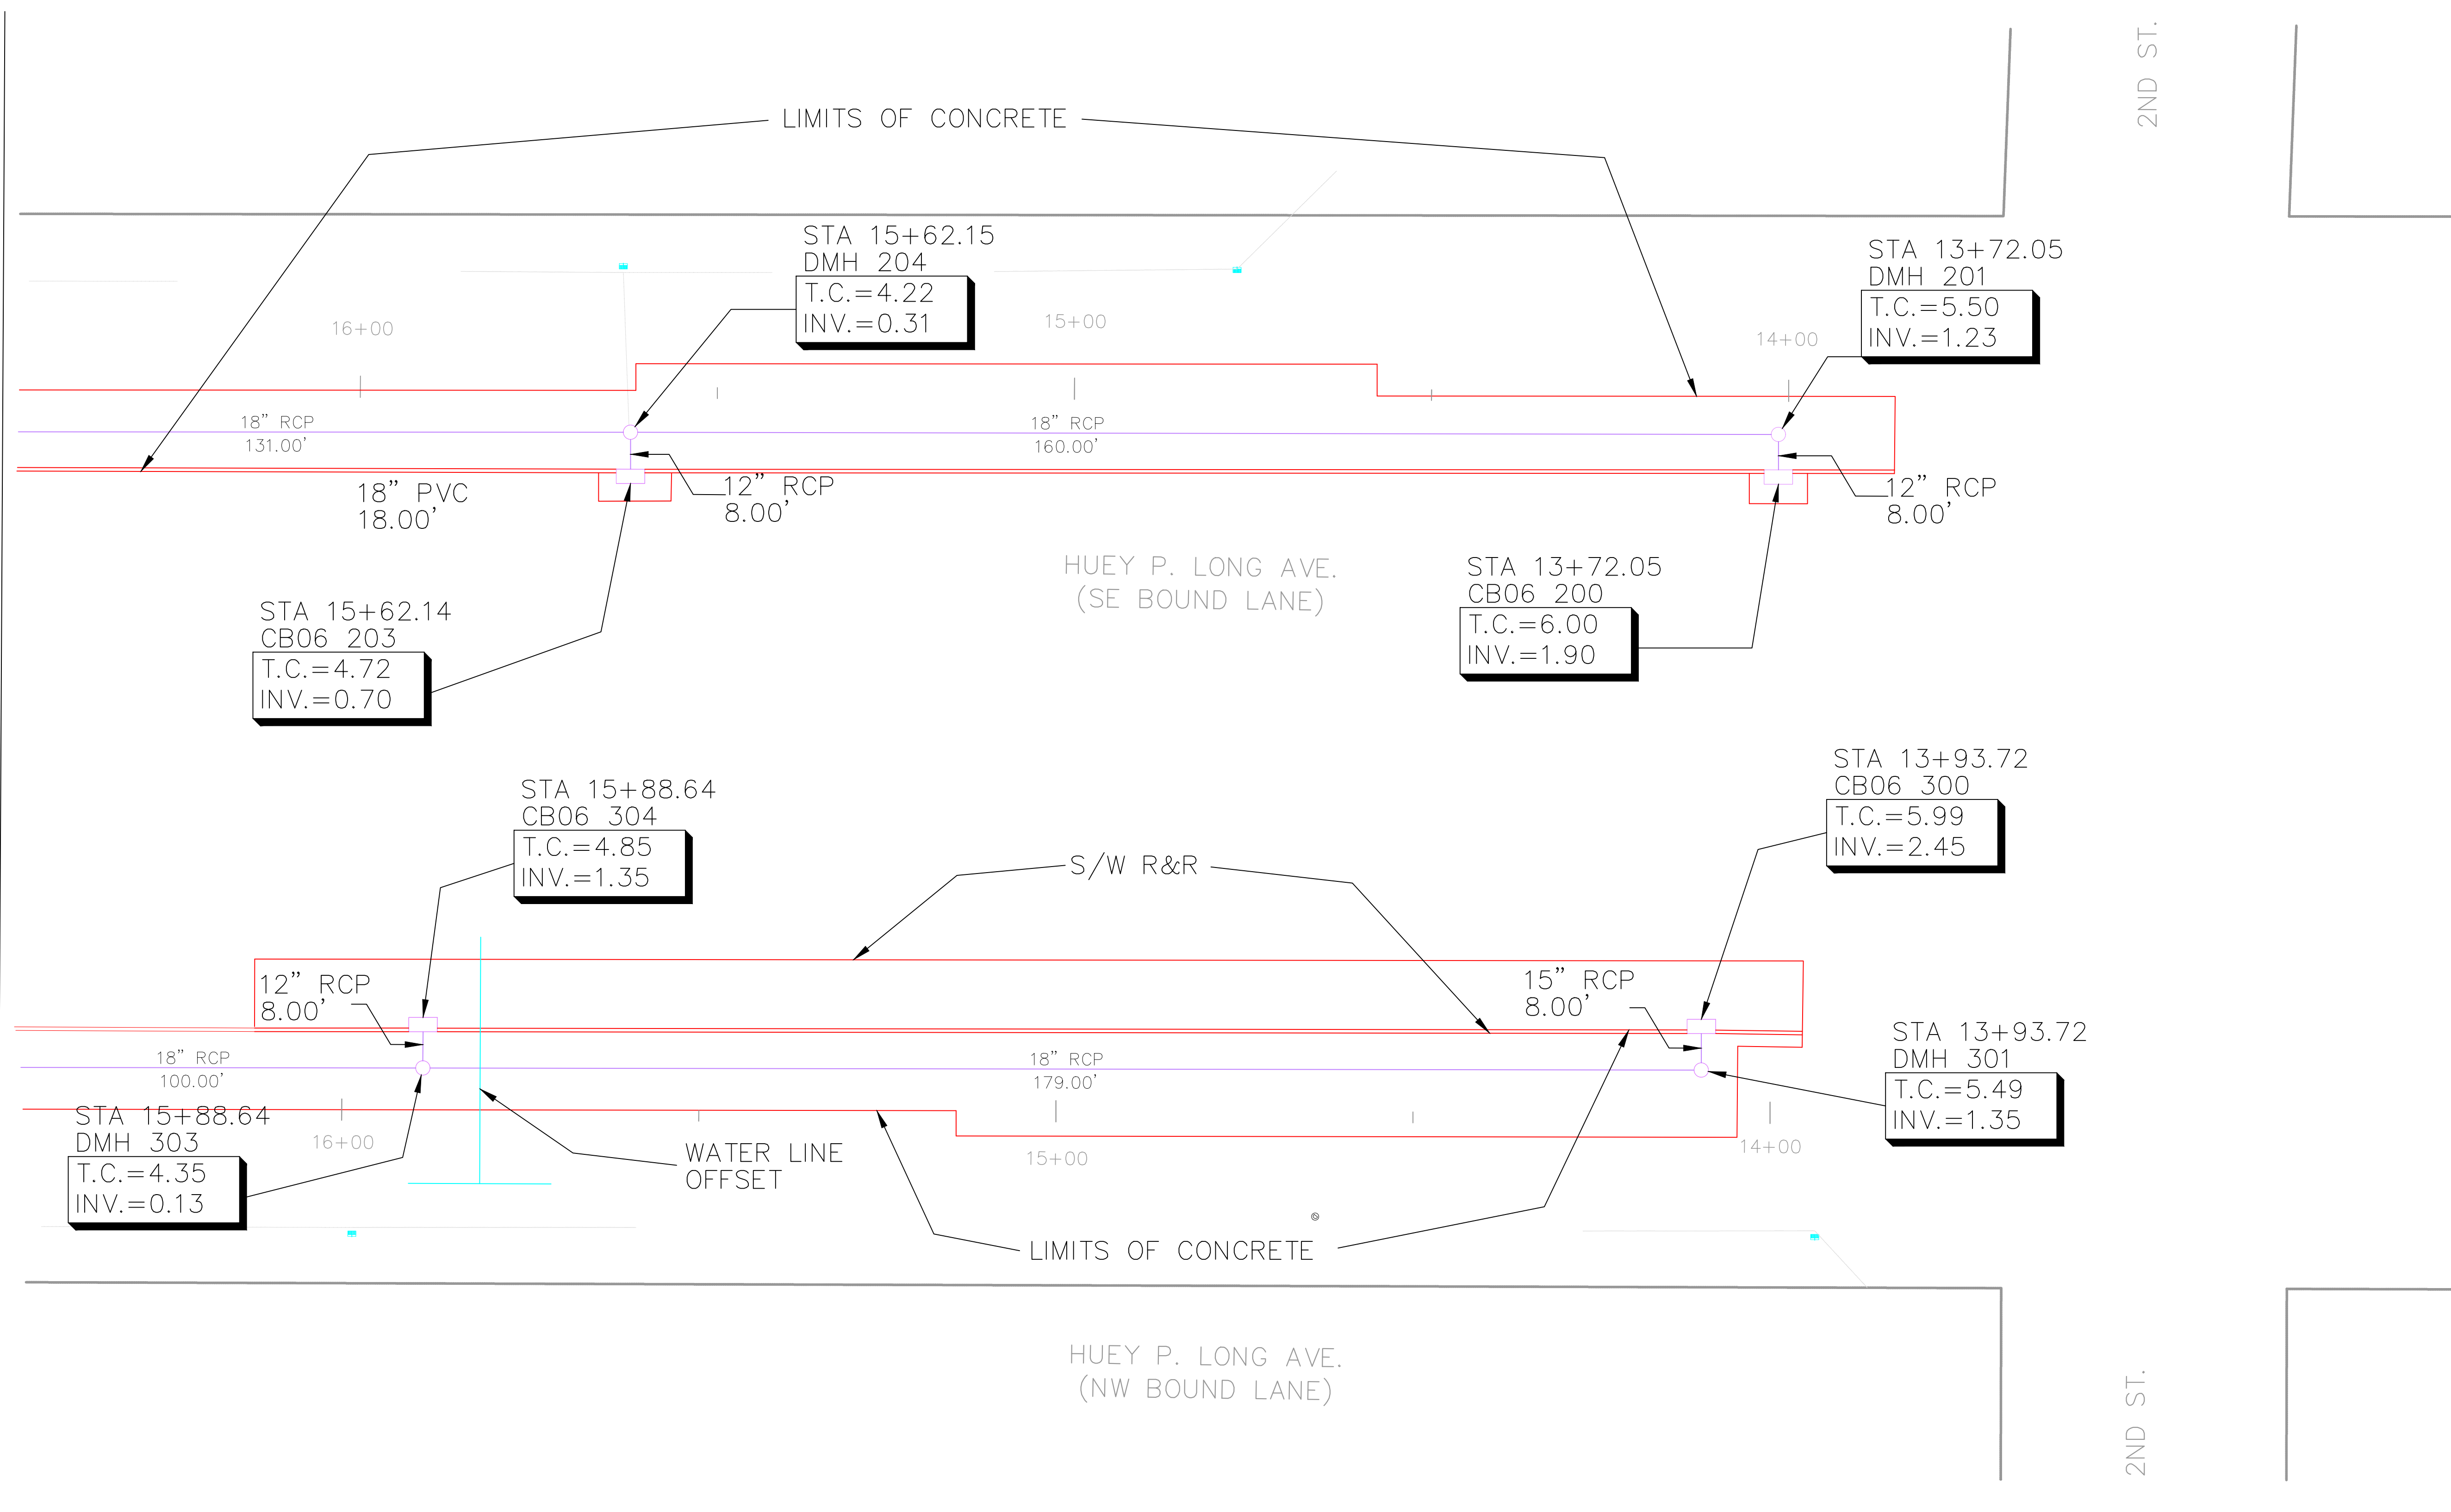

BARRIERE CONSTRUCTION A CRH COMPANY	
Jon Number:	220057.000
Gretna Downtown Drainage Improvements	
Drawing Title:	Utility & Roadway Asbuilts
Notes:	
A004	
Gretna, La 70053	

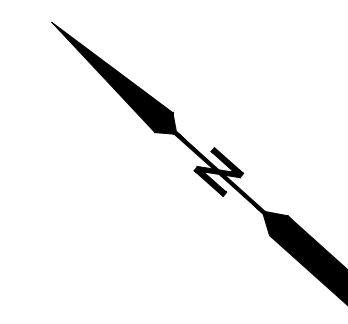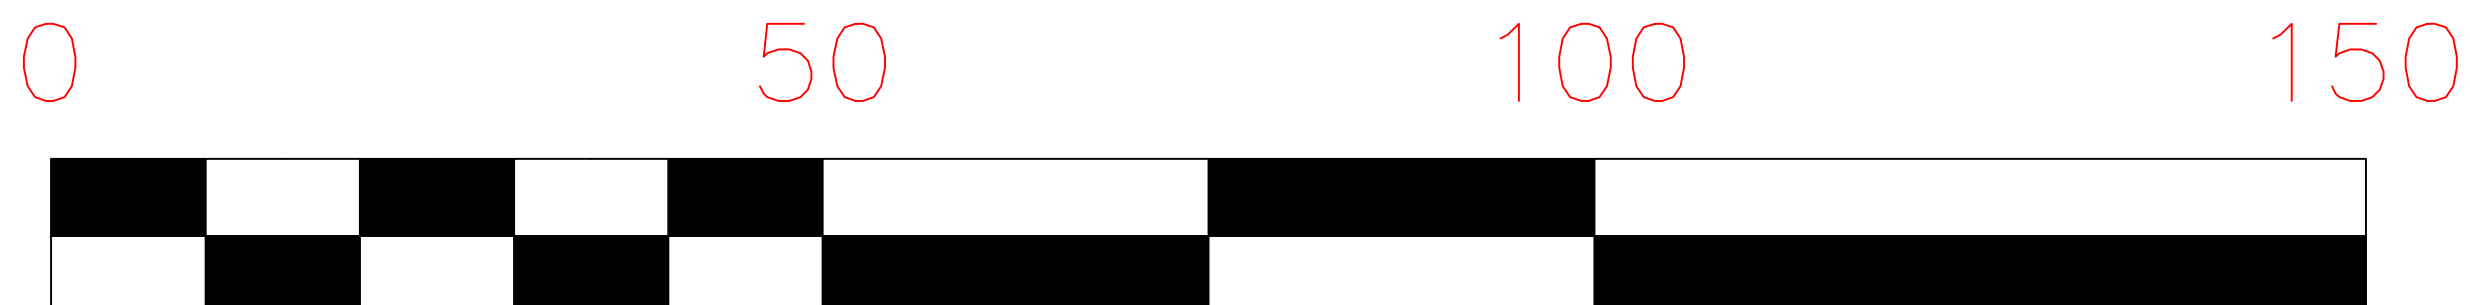


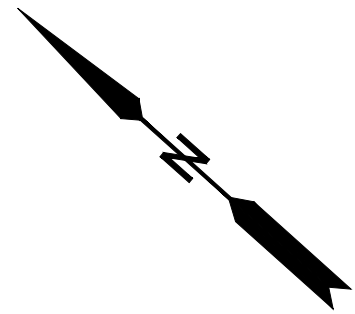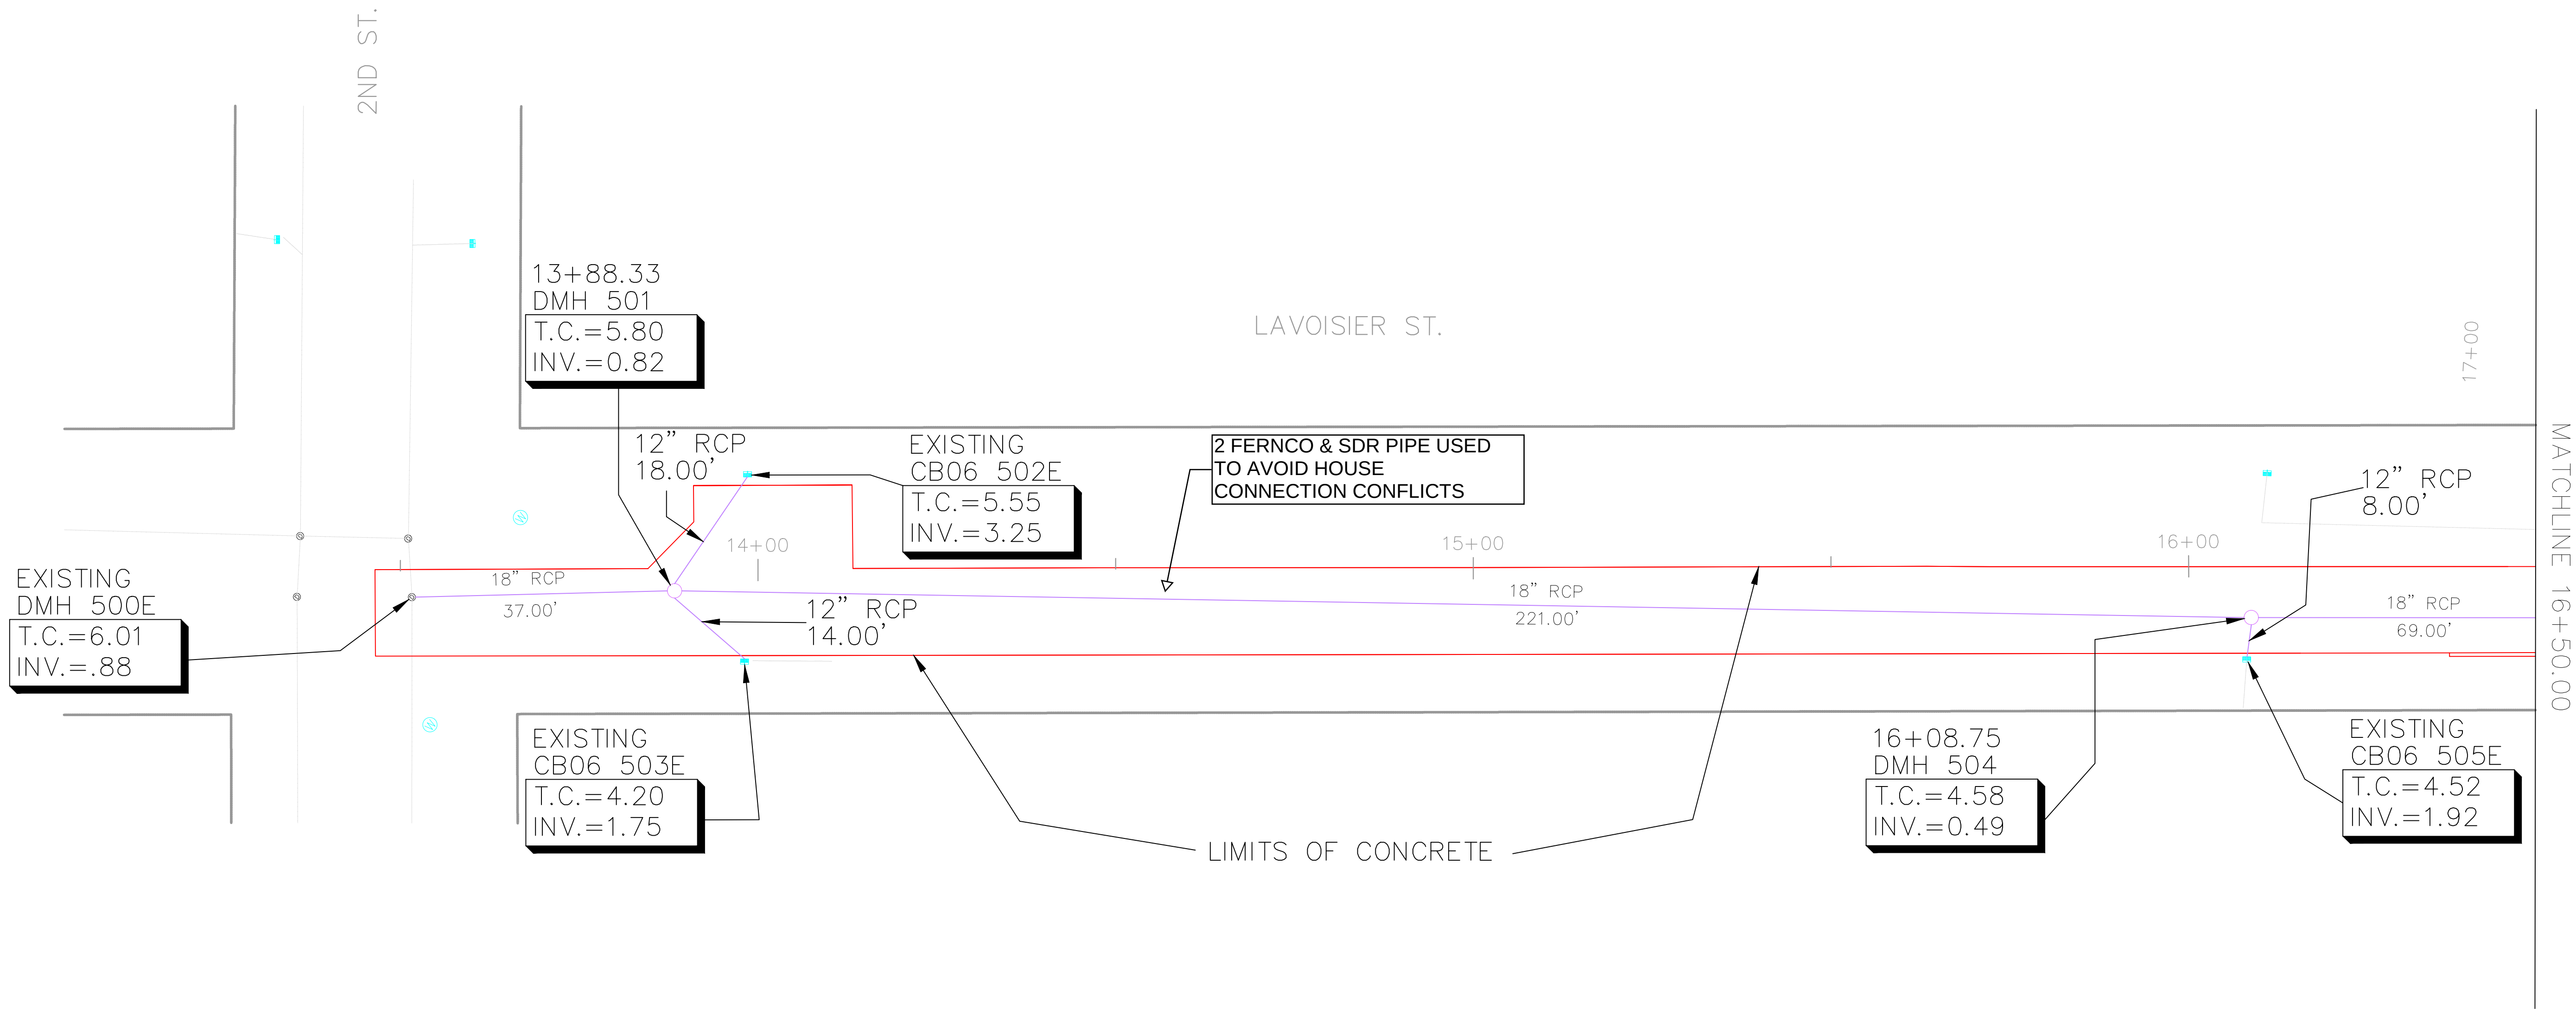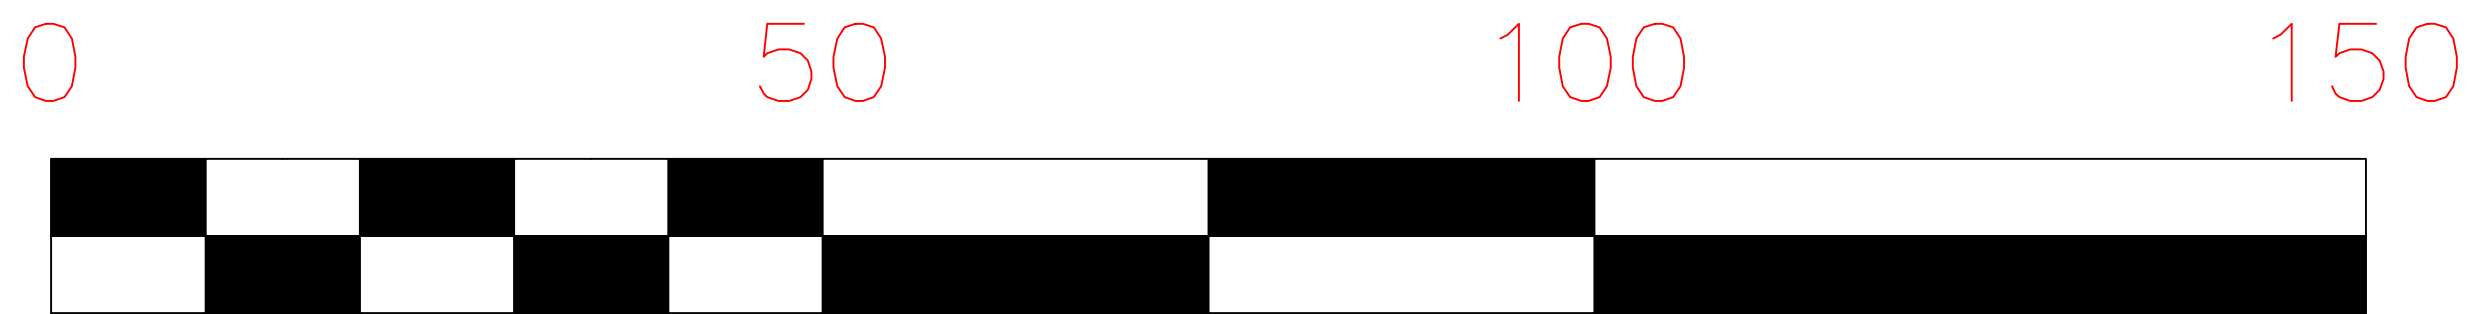

Drawing Title: Utility & Roadway Asbuilts	Jon Number: 220057.000	BARRIERE CONSTRUCTION A CRH COMPANY
Notes: _____ _____ _____ _____	A006 _____ _____ _____ _____	

SYMBOL SCHEDULE












LIGHTING SYMBOLS

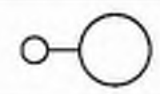	DESCRIPTION
	SINGLE ARM ROADWAY LUMINAIRE. LETTER DENOTES LUMINAIRE TYPE. SEE LUMINAIRE SCHEDULE.
	POST TOP LUMINAIRE. LETTER DENOTES LUMINAIRE TYPE. SEE LUMINAIRE SCHEDULE.



POWER SYMBOLS

	DESCRIPTION
	DISCONNECT SWITCH. FUSED UNLESS OTHERWISE NOTED.
	JUNCTION BOX.
	TRANSFORMER

WIRING SYMBOLS

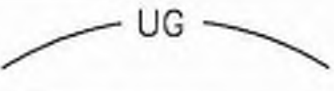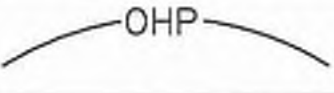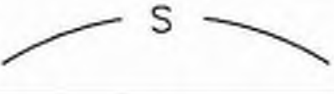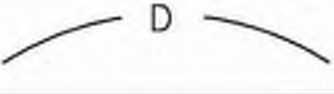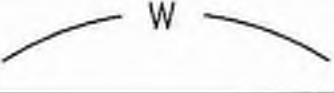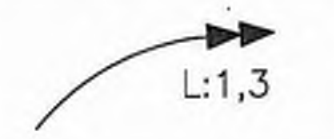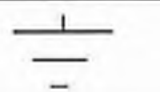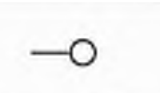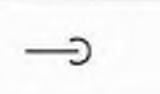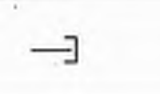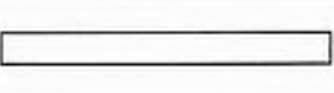	DESCRIPTION
	WIRING (IN CONDUIT) RUN EXPOSED.
	WIRING UNDERGROUND (SITE WORK).
	WIRING OVERHEAD (SITE WORK).
	SEWER LINE.
	DRAIN LINE.
	WATER LINE.
	HOMERUN TO PANELBOARD WITH NOMENCLATURE (LETTERS), CIRCUIT NUMBERS (NUMBERS), NUMBER OF CIRCUITS (NUMBER OF ARROWS), EACH CIRCUIT TO HAVE GROUND.
	GROUND CONNECTION
	CONDUIT TURNED UP.
	CONDUIT TURNED DOWN.
	CONDUIT STUBBED OUT.
	PULL BOX. NEMA CONFIGURATION AS NOTED.
	6" SCH. 80 PVC CONDUIT 'CASING' (UNDERGROUND) WITH 2" PVC CONDUIT AND CONDUCTORS AS INDICATED

ONE-LINE SYMBOLS

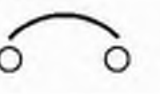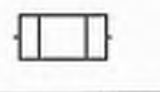	DESCRIPTION
	METER ENCLOSURE.
	METER.
	CIRCUIT BREAKER.
	SWITCH, SINGLE POLE-SINGLE THROW.
	FUSE.
	DRY TYPE TRANSFORMER.
	EXOTHERMIC WELD CONNECTION

REFERENCE SYMBOLS

	DESCRIPTION
	REFERENCE NOTE.
	SPECIFIC NOTE REFERENCE.
	CALL OUT REFERENCE.
	REVISION REFERENCE.
	DETAIL REFERENCE: "A" DENOTES DETAIL "E1" DENOTES SHEET NUMBER WHERE DETAIL IS TAKEN "E2" DENOTES SHEET NUMBER WHERE DETAIL IS DRAWN

MISC. SYMBOLS

	DESCRIPTION
	TO BE REMOVED

GENERAL NOTES:

- ALL WIRING, DUCT LINE CONDUIT, APPARATUS, DEVICES, LUMINAIRES, EQUIPMENT AND FOUNDATIONS SHALL CONFORM TO CITY OF GRETNAL REQUIREMENTS, APPLICABLE ORDINANCES OR RESOLUTIONS AND THEIR STANDARD DETAILS FOR CONSTRUCTION OF SAME. ALL WIRING SHALL BE IN CONDUIT.
- THE ELECTRICAL CONTRACTOR SHALL SECURE ALL PERMITS FOR HIS WORK AND ARRANGE FOR ALL INSPECTIONS REQUIRED.
- THE ELECTRICAL CONTRACTOR SHALL FURNISH ALL LABOR, MATERIALS AND EQUIPMENT REQUIRED TO CONSTRUCT A COMPLETE STREET LIGHTING SYSTEM AS SHOWN IN THE PLANS AND AS COMPLYING WITH CITY OF GRETNAL REQUIREMENTS.
- THE ELECTRICAL CONTRACTOR SHALL SECURE APPROVALS FOR HIS WORK IN WRITING FROM THE CITY OF GRETNAL AND SHALL PRESENT THE APPROVAL TO THE OWNER BEFORE FINAL PAYMENT.
- THE LOCATION SHOWN ON PLANS OF EXISTING UTILITIES IS APPROXIMATE. THE CONTRACTOR SHALL CAREFULLY VERIFY THESE LOCATIONS AND TAKE WHATEVER PRECAUTIONS NECESSARY TO AVOID DAMAGE TO EXISTING UTILITIES.
- THE CONTRACTOR WILL BE REQUIRED TO FURNISH HIS OWN CONSTRUCTION LAYOUT FOR THE STREET LIGHT STANDARDS.
- CITY OF GRETNAL HAS EXAMINED THE LOCATION OF THE STREET LIGHTS AND APPROVES OF THESE LOCATIONS. IT IS HEREBY UNDERSTOOD THAT CITY OF GRETNAL RESERVES THE RIGHT TO REQUIRE RELOCATION OF SAID STREET LIGHTS, THE SAME ARE TO BE RELOCATED AT THE COST AND EXPENSE OF THE PARTY DESIRING RELOCATION. ALL RELOCATION OF STREET LIGHTS MUST HAVE THE PRIOR APPROVAL OF CITY OF GRETNAL.
- ALL UTILITIES SHALL MEET WITH THE REQUIREMENTS OF THE LOCAL UTILITY PROVIDER AND SHALL ALSO COMPLY WITH ALL GROUNDING REQUIREMENTS AS SPECIFIED BY THE PLANS, SPECIFICATIONS, AND THE 2014 NATIONAL ELECTRICAL CODE (N.E.C.)
- WHEN ANY PART OF A WIRING INSTALLATION IS TO BE CONCEALED FROM VIEW OR NOT READILY ACCESSIBLE, THE PERSON SUPERVISING AND INSTALLING THE DUCT OR WIRING SHALL NOTIFY CITY OF GRETNAL LOCAL CODE ENFORCEMENT. ANY SUCH PARTS OF THE WIRING INSTALLATION SHALL NOT BE CONCEALED UNTIL THEY HAVE BEEN INSPECTED AND APPROVED, PROVIDED THAT ON SUCH INSTALLATION THE CONCEALMENT OF PARTS OF THE WIRING MUST, AT THE DISCRETION OF THE ELECTRICAL INSPECTOR, NECESSARILY PROCEED CONTINUOUSLY.
- UNLESS NOTED OTHERWISE IN THE PLANS, THERE SHALL BE RUN THE LENGTH OF THE SYSTEM, AN EQUIPMENT GROUNDING CONDUCTOR A MINIMUM OF NO. 10 AWG COPPER FOR GROUNDING ALL SERVICE FEEDERS, LIGHT STANDARDS, POLES AND HEADS, RECEPTACLES, METALLIC SECTIONS OF RACEWAYS, AND OTHER METALLIC EQUIPMENT. THE EQUIPMENT GROUNDING CONDUCTORS SHALL BE INSULATED CONDUCTORS.
- THE CONTRACTOR SHALL PROVIDE AND INSTALL 2-10 AMP IN-LINE FUSES IN FUSE HOLDERS WITH BOOTS IN THE BASE OF EACH POLE PER LUMINAIRE WITH CIRCUITS FEEDING LUMINAIRES (EACH CONNECTION SHALL BE COVERED WITH INSULATION EQUAL TO THE INSULATION OF THE CONDUCTOR)
- ALL CONDUIT FOR STREET LIGHTING SYSTEMS WHERE EXPOSED SHALL BE GALVANIZED RIGID STEEL CONDUIT. ALL SUPPORT MATERIALS (EXCLUDING FASTENERS AND HARDWARE) SHALL BE HOT DIP GALVANIZED OR STAINLESS STEEL.
- EQUIPMENT AND MATERIAL SHALL NOT BE ORDERED OR INSTALLED UNTIL IT IS APPROVED BY THE ENGINEER.
- EQUIPMENT LAYOUTS ARE DIAGRAMMATIC, AND THEY DO NOT SHOW EXACT EQUIPMENT LOCATIONS. THE EXACT LOCATIONS OF LIGHT POLES, CONDUITS, JUNCTION BOXES, ECT., SHALL BE AS DIRECTED BY THE PROJECT ENGINEER. THE CONTRACTOR SHALL FURNISH AS-BUILT DRAWINGS WHICH SHOW THE FINAL INSTALLED LOCATIONS OF THE EQUIPMENT.
- ALL SUPPORT MATERIALS, INCLUDING FASTENERS AND HARDWARE, SHALL BE HOT DIP GALVANIZED OR TYPE 316 STAINLESS STEEL.
- THE PLANS DO NOT NECESSARILY SHOW ALL UNDERGROUND FACILITIES. BEFORE BEGINNING EXCAVATION, THE CONTRACTOR SHALL CHECK THE AREA FOR EVIDENCE OF UNDERGROUND FACILITIES. THE CONTRACTOR WILL BE RESPONSIBLE FOR DAMAGE TO ANY UNDERGROUND FACILITIES CAUSED BY THE CONTRACTOR'S OPERATION.

GENERAL NOTES (CONTINUED):

- ALL EXPOSED CONDUIT FITTINGS AND COUPLINGS SHALL BE THREADED SCREW TYPE. THREADLESS, COMPRESSION, OR SPLIT BOLT ON COUPLINGS ARE NOT ACCEPTABLE.
- THE CONTRACTOR SHALL MAINTAIN PROPER CLEARANCES FROM ALL OVERHEAD AND UNDERGROUND UTILITIES, AND SHALL CONTACT EACH UTILITY FOR SPECIFIC REQUIREMENTS. NEW ELECTRICAL SHALL BE ROUTED UNDER EXISTING UTILITY.
- THE CONTRACTOR IS RESPONSIBLE FOR MAKING HIS OWN DETERMINATION AS TO TYPE AND LOCATION OF UNDERGROUND UTILITIES AS MAY BE NECESSARY TO AVOID DAMAGE THERE TO. THE CONTRACTOR SHALL VERIFY LOCATION OF UNDERGROUND PIPE LINES, CONDUITS, AND OTHER STRUCTURES BY CONTACTING OWNERS OF UNDERGROUND UTILITIES AND BY PROSPECTING IN ADVANCE OF EXCAVATION OPERATIONS.
- THE CONTRACTOR PER THE DIRECTION OF CITY OF GRETNAL SHALL USE THE EXPLORATORY ITEM TO DETERMINE THE EXACT LOCATION AND DEPTH OF EXISTING CITY/PARISH UTILITIES AND POTENTIAL CONFLICTS. ALL EXCAVATION FOR THIS ITEM SHALL BE IN THE PRESENCE OF A REPRESENTATIVE OF CITY OF GRETNAL.
- EQUIPMENT LOCATIONS MAY BE ADJUSTED ONLY WITH THE PERMISSION OF THE ENGINEER. THE CONTRACTOR SHALL FURNISH AS-BUILT DRAWINGS WHICH SHOW THE FINAL INSTALLED LOCATIONS.
- THE CONTRACTOR IS RESPONSIBLE FOR SATISFACTORILY MAINTAINING THE IMMEDIATE WORK AREA IN A NEAT AND ORDERLY MANNER.
- FOUNDATIONS FOR STREET LIGHT STANDARDS SHALL BE AS DETAILED IN THE DRAWINGS.
- UNLESS OTHERWISE NOTED, ALL UNDERGROUND CABLE SHALL BE MINIMUM SIZE #10 C.U. STANDARD, INSULATION TYPE RHH/RHW-2 U.S.E. IN PVC/HDPE SCHEDULE 40 CONDUIT BURIED AT MINIMUM 24" BELOW FINISHED GRADE. FURNISH WARNING TAPE IF OPEN TRENCH INSTALLATION.
- A COPPER WELD GROUND ROD MINIMUM 10' X 5/8" DIAMETER WILL BE REQUIRED AT EACH LIGHT STANDARD.
- THE SERVICE EQUIPMENT SHALL BE GROUNDING AT THE FIRST DISCONNECTING MEANS FROM THE UTILITY COMPANY'S POLE TO A DRIVEN ELECTRODE.
- THE UNDERGROUND FEEDER CONDUCTORS AND THE GROUNDING CONDUCTORS SHALL BE COPPER INSULATION TYPE RHH/RHW-2 U.S.E. AND SHALL BE OF SUFFICIENT SIZE SO THAT THE VOLTAGE DROP TO THE LAST LIGHT STANDARD WILL NOT EXCEED FIVE PERCENT (5%). ALL UNDERGROUND CONDUITS WITH CABLES SHALL BE BURIED TO A MINIMUM OF TWENTY-FOUR INCHES (24").
- ALL UNDERGROUND CONDUCTORS SUPPLYING CURRENT FOR STREET LIGHTING SYSTEMS SHALL BE INSTALLED IN A NON-METALLIC PVC/HDPE SCHEDULE 40 CONDUIT. WHEN RUN UNDER UNDEVELOPED OR NEWLY CUT STREETS (NOT YET PAVED, BLACKTOPPED, OR GRAVELED) THEY SHALL BE RUN IN A NON-METALLIC PVC SCHEDULE 40 (OR BETTER) ENCASED IN CONCRETE AND THROUGH A FOUR INCH (4") CONDUIT UNDER SAID STREET. AN "E" SHALL BE ETCHED IN THE CURB AT ANY AND ALL ELECTRICAL CROSSINGS UNDER STREETS. ALL RACEWAYS SHALL HAVE A MINIMUM TRADE SIZE OF 2 INCHES (2") AND BE BURIED A MINIMUM OF TWENTY-FOUR INCHES (24") BELOW GRADE. WHERE THE RACEWAY RISES UP TO THE LIGHT STANDARDS, IT MUST COME ABOVE THE FOUNDATION A MINIMUM OF 4 INCHES (4"). ALL ELBOWS OR BENDS USED IN THE SYSTEM SHALL BE 2-INCH (2") MINIMUM PVC SCHEDULE 40 (OR BETTER).
- STREET LIGHT FOUNDATIONS SHALL BE OF CONCRETE CAST IN PLACE TO BE IN ACCORDANCE WITH THE TYPICAL FOUNDATION PLAN FOR STREET LIGHT STANDARDS FOR CITY OF GRETNAL.
- ALL STREET LIGHT INSTALLATION SHALL AVOID CONFLICTS WITH HANDICAPPED ACCESSIBILITY RAMPS AND THE LOCATION OF THESE RAMPS WILL GOVERN THE EXACT LOCATION OF THE STREETLIGHTS. PRIOR TO INSTALLATION, THE CONTRACTOR WILL COORDINATE THEIR ACTIVITIES WITH THE DEPARTMENT OF ENGINEER'S FIELD INSPECTOR.
- STREET LIGHT STANDARDS WILL BE SERVED FROM ENTERGY, INC. FEED POINTS.
- LIMITS OF REMOVAL FOR CONCRETE PAVEMENT AND SIDEWALKS TO EXISTING JOINT OR REQUIRED SAW JOINT TO BE COORDINATED WITH CITY OF GRETNAL. PAYMENT FOR REMOVALS SHALL BE PER APPLICABLE BID ITEMS. FULL DEPTH SAW CUTS TO BE INCLUDED IN THE UNIT PRICES FOR EACH REMOVAL ITEM.
- VERIFICATION AND PROTECTION OF ALL UTILITIES AND SERVICES SHALL BE THE RESPONSIBILITY OF THE CONTRACTOR.
- THE CONTRACTOR SHALL SUPPLY AND MAINTAIN CONSTRUCTION SIGNS AS REQUIRED BY THE CITY OF GRETNAL.
- THE CONTRACTOR SHALL CLOSE ONLY ONE LANE OF TRAFFIC AT A TIME. CONTRACTOR SHALL COORDINATE ANY LANE CLOSURES WITH THE CITY OF GRETNAL 48 HOURS BEFORE EXPECTED CLOSURE PRIOR TO COMMENCING ANY WORK.
- SHEETS E.101, E.102, ABBREVIATIONS, SCHEDULES, DETAILS, ETC., APPLY TO ALL SHEETS UNLESS INDICATED OTHERWISE.



CALL BEFORE YOU DIG:
Always dial 811 or 800 272-3020 first.
The call and the service are FREE.

BKI BURK-KLEINPETER, INC.
ENGINEERS, ARCHITECTS, PLANNERS, ENVIRONMENTAL SCIENTISTS
4176 CANAL STREET, NEW ORLEANS, LA 70119-5994
PHONE (504)486-5901 • FAX (504)486-1714

DANA BROWN & Associates

DANA BROWN & ASSOCIATES, INC.
NEW ORLEANS - 504-345-2639
www.danabrownassociates.com

**DOWNTOWN DRAINAGE
IMPROVEMENTS**
740 2nd Street
Gretna, Louisiana 70053

NOTES:

- PROTECT ALL EXISTING TREES ON SITE DURING CONSTRUCTION

REVISIONS

NO.	DESCRIPTION	DATE

AS-BUILT

Franchet Electric Co., Inc.
by *Franchet*
date *3/10/19*

PROJECT NUMBER:
DBA 1603


DATE:
01 MARCH 2019

ISSUE:
100% CONSTRUCTION
DOCUMENTS

SHEET TITLE:
**SCHEDULES AND
NOTES**

SHEET NO.
E.101

10 January 2020 10:24am P:\browns\10344\3501\HPL LIGHTING\DWG\DWG-E.102.dwg Layout: E.102
Copyright Dana Brown & Associates, Inc. All design, engineering, and plans represented by this drawing are owned by and the property of Dana Brown & Associates, Inc. and were created for the exclusive use of the specified project. These ideas, design, engineering or plans shall not be used by or disclosed to any person, firm, or corporation without the written permission of Dana Brown & Associates, Inc.

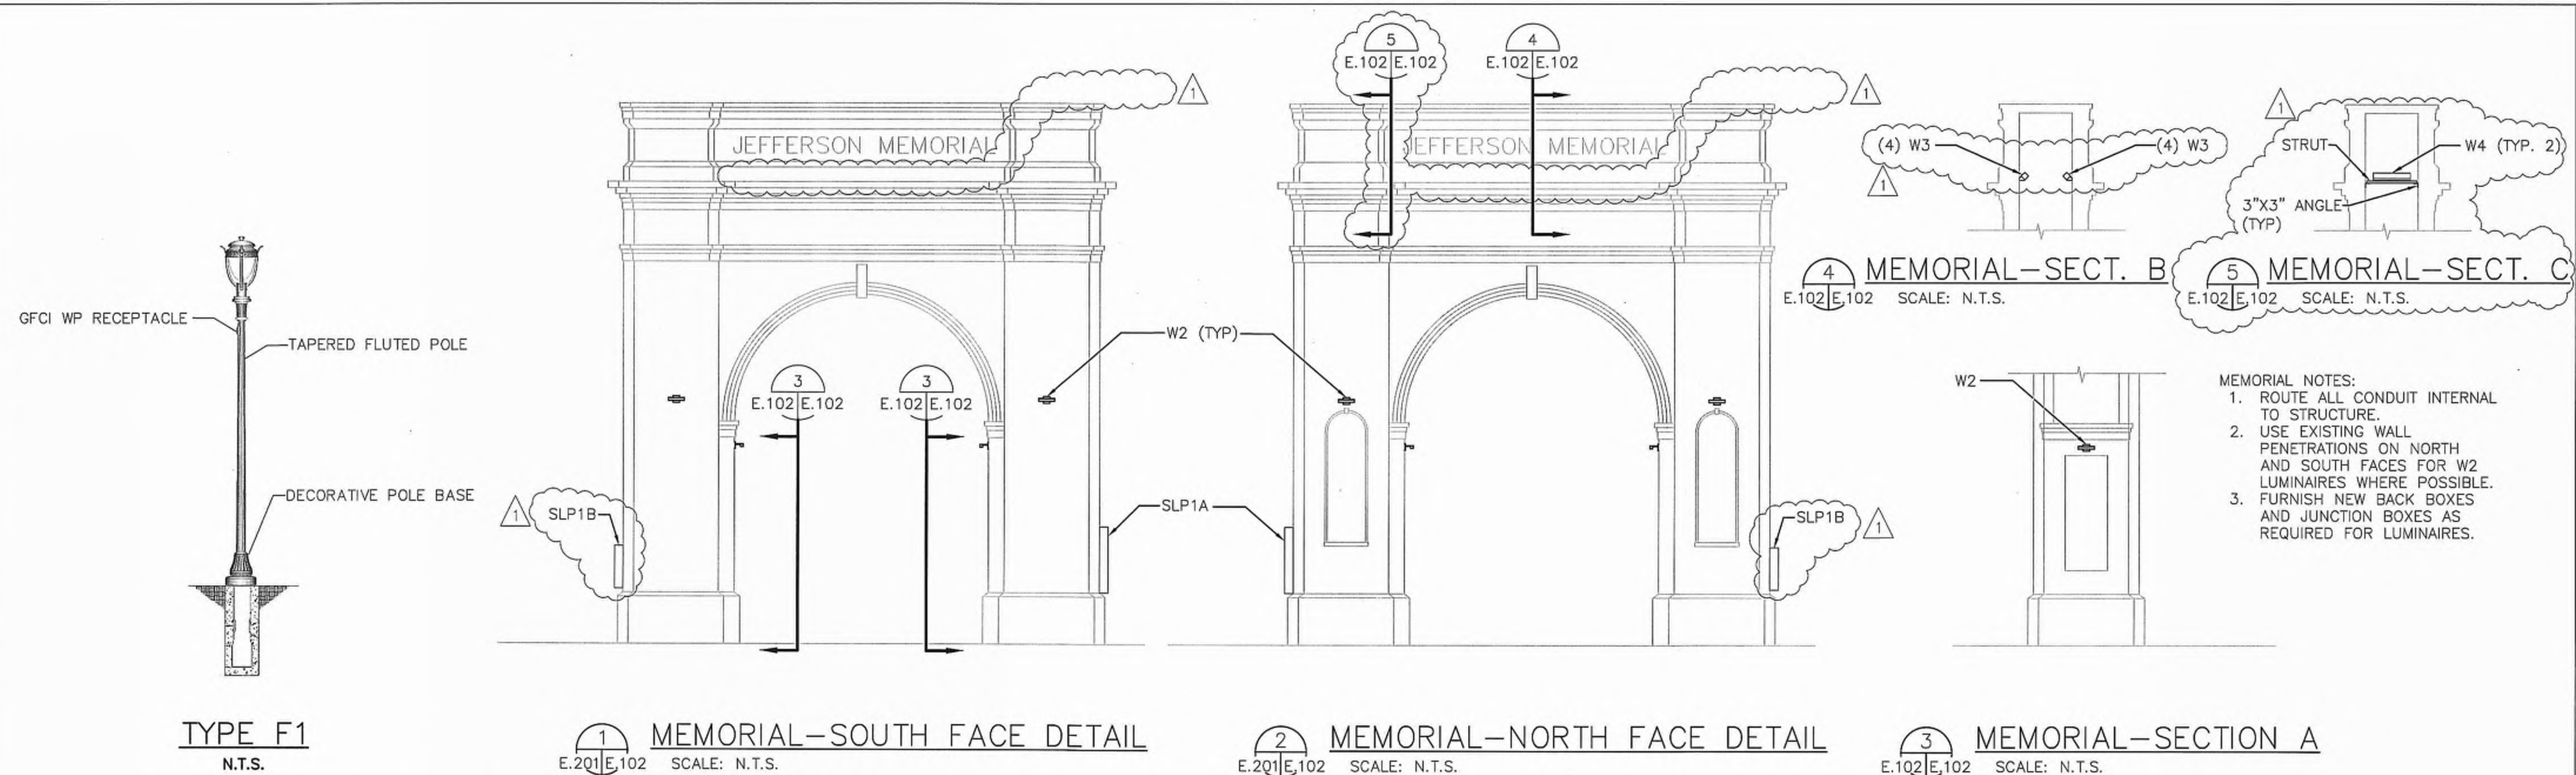

LUMINAIRE SCHEDULE

TAG	NOTES	DESCRIPTION	CATALOG	VOLTAGE	LAMP
B1	1	DECORATIVE BOLLARD	SUN VALLEY	120	LED
	2	TYPE V MED DISTRIBUTION POST TOP BLACK FLUTED RISER	MOZB-FL SERIES		23W
F1	1	DECORATIVE TEARDROP	SUN VALLEY	240	LED
	2	TYPE IV	LCW-APA		45W
	3	POST TOP	SERIES		
	4,10	POLYCARBONATE LENS			
W1	1	RECESSED LED WALL LIGHT	BEGA	120	LED
	2	CONCRETE COVER	33046 SERIES		5.8W
W2	1	12" EXTERIOR LINEAR LED	TROV	120	LED
	2	WALL WASH	ECOSENSE		4W/FT
	5	BRACKET MOUNT	L50 SERIES		
	6,8	70 X 70 BEAM			
W3	1	4" NARROW BODY EXTERIOR	GE	120	LED
	6	LINEAR LED, DIFFUSED LENS,	ALBEO LED		5000 LUMENS
	7	INDUSTRIAL GRADE, THREADED	ALR2 SERIES		4000K
	8	HUBS			
W4	1	2" BODY EXTERIOR	GE	120	LED
	6	LINEAR LED, DIFFUSED LENS,	ALBEO LED		4000 LUMENS
	9	INDUSTRIAL GRADE, THREADED	ALR2 SERIES		4000K
	8	HUBS			

- LUMINAIRE SCHEDULE NOTES
- UL LISTED AND APPROVED FOR WET LOCATIONS AT A MAXIMUM OF 40 DEGREES C AMBIENT TEMPERATURE.
 - LUMINAIRES SHALL HAVE AN IDENTIFIED GROUNDING CONDUCTOR FROM HEAD TO POLE GROUNDING CONDUCTOR.
 - MOUNTING HEIGHT: 15'-0" ABOVE FINISHED GRADE.
 - ROUND TAPERED FLUTED ALUMINUM POLE SHAFT WITH DECORATIVE BASE. FURNISHED BY OWNER, INSTALLED BY CONTRACTOR.
 - SINGLE ARM WALL BRACKET MOUNT.
 - IP66 RATED.
 - INSTALLED IN INTERNAL WALL OF MEMORIAL STRUCTURE WITH 45' WALL MOUNTED BRACKET.
 - L50 E 12 04 30 90 70X70.
 - WALL MOUNT HOT-DIPPED GALVANIZED (HDG) ANGLE SUPPORTS ON EACH SIDE OF INTERNAL WALL AND MOUNT HDG STRUT BETWEEN ANGLE SUPPORTS TO INSTALL W4 LUMINAIRE ON TOP OF STRUT. INSTALL WITH 45' WALL MOUNTED BRACKET.
 - LCW-APA-IV-40LED-NW-PT-CP BLACK TEXTURED FINISH.

ABBREVIATIONS

A	AMPERE(S)	H	HIGH PRESSURE SODIUM	P	POLE	U	UNDERGROUND
AFF	ABOVE FINISHED FLOOR	HPS	HIGH INTENSITY DISCHARGE	PH	PHASE	UG	UNDERWRITER'S LABORATORIES
AFG	ABOVE FINISHED GRADE	HID	HUEY P. LONG AVENUE	PRI	PRIMARY	U.L.	
ALUM	ALUMINUM	HPL		PVC	POLYVINYL CHLORIDE	V	VOLTS
AWG	AMERICAN WIRE GAGE	J	JUNCTION BOX	R	REINFORCED CONCRETE PIPE ARCH	W	WATTS, WIRE, WIDTH
C	CONDUIT	JB		RCPA	RECEPTACLE	X	TRANSFORMER
CB	CATCH BASIN	L	POUNDS	REC	RIGID GALVANIZED STEEL		
CL	CENTER LINE	LV	LOW VOLTAGE	RGS			
CU	COPPER	M	METAL HALIDE	SEC	SECONDARY		
COMM	COMMUNICATION	N	NATIONAL ELECTRICAL CODE	SFM	SEWERAGE FORCE MAIN		
EXIST	EXISTING	NTS	NOT TO SCALE	SMH	SEWER MAN HOLE		
FT.	FOOT; FEET			T	TELEPHONE		
GALV	GALVANIZED			TMH	TELECOMMUNICATION MANHOLE		
				TYP	TYPICAL		

BKI BURK-KLEINPETER, INC.
ENGINEERS, ARCHITECTS, PLANNERS, ENVIRONMENTAL SCIENTISTS
4176 CANAL STREET, NEW ORLEANS, LA 70119-5994
PHONE (504)486-5901 • FAX (504)488-1714

One Call
CALL BEFORE YOU DIG:
Always dial 811 or 800 272-3020 first.
The call and the service are FREE.

STATE OF LOUISIANA
PERRY P. HOGAN
REG. NO. 31042
REGISTERED PROFESSIONAL ENGINEER
ELECTRICAL ENGINEERING
1/10/20

DANA BROWN & Associates
DANA BROWN & ASSOCIATES, INC.
NEW ORLEANS, LA 70119-5994
www.danabrownassociates.com

DOWNTOWN DRAINAGE IMPROVEMENTS
740 2nd Street
Gretna, Louisiana 70053

NOTES:
• PROTECT ALL EXISTING TREES ON SITE DURING CONSTRUCTION

AS BUILT
Friedrich Electric Co., Inc.
by: [Signature]
date: 1/10/20

REVISIONS
PANEL ADD/AUGHT MOD. 01/20/20


PROJECT NUMBER:
DBA 1603

DATE:
01 MARCH 2019

ISSUE:
100% CONSTRUCTION DOCUMENTS

SHEET TITLE:
SCHEDULES AND ABBREVIATIONS


SHEET NO.
E.102

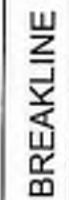


HEET NO.
201



20 February 2019 9:03am P:\00003440344-4350\HPL\LIGHTING\DESIGN\EEC_16-2000244-4350-E.202.dwg Layout = E.202
Copyright Dana Brown & Associates, Inc. All ideas, designs, arrangements or plans shall not be used by, or disclosed to any person, firm, or corporation without the written permission of Dana Brown & Associates, Inc.

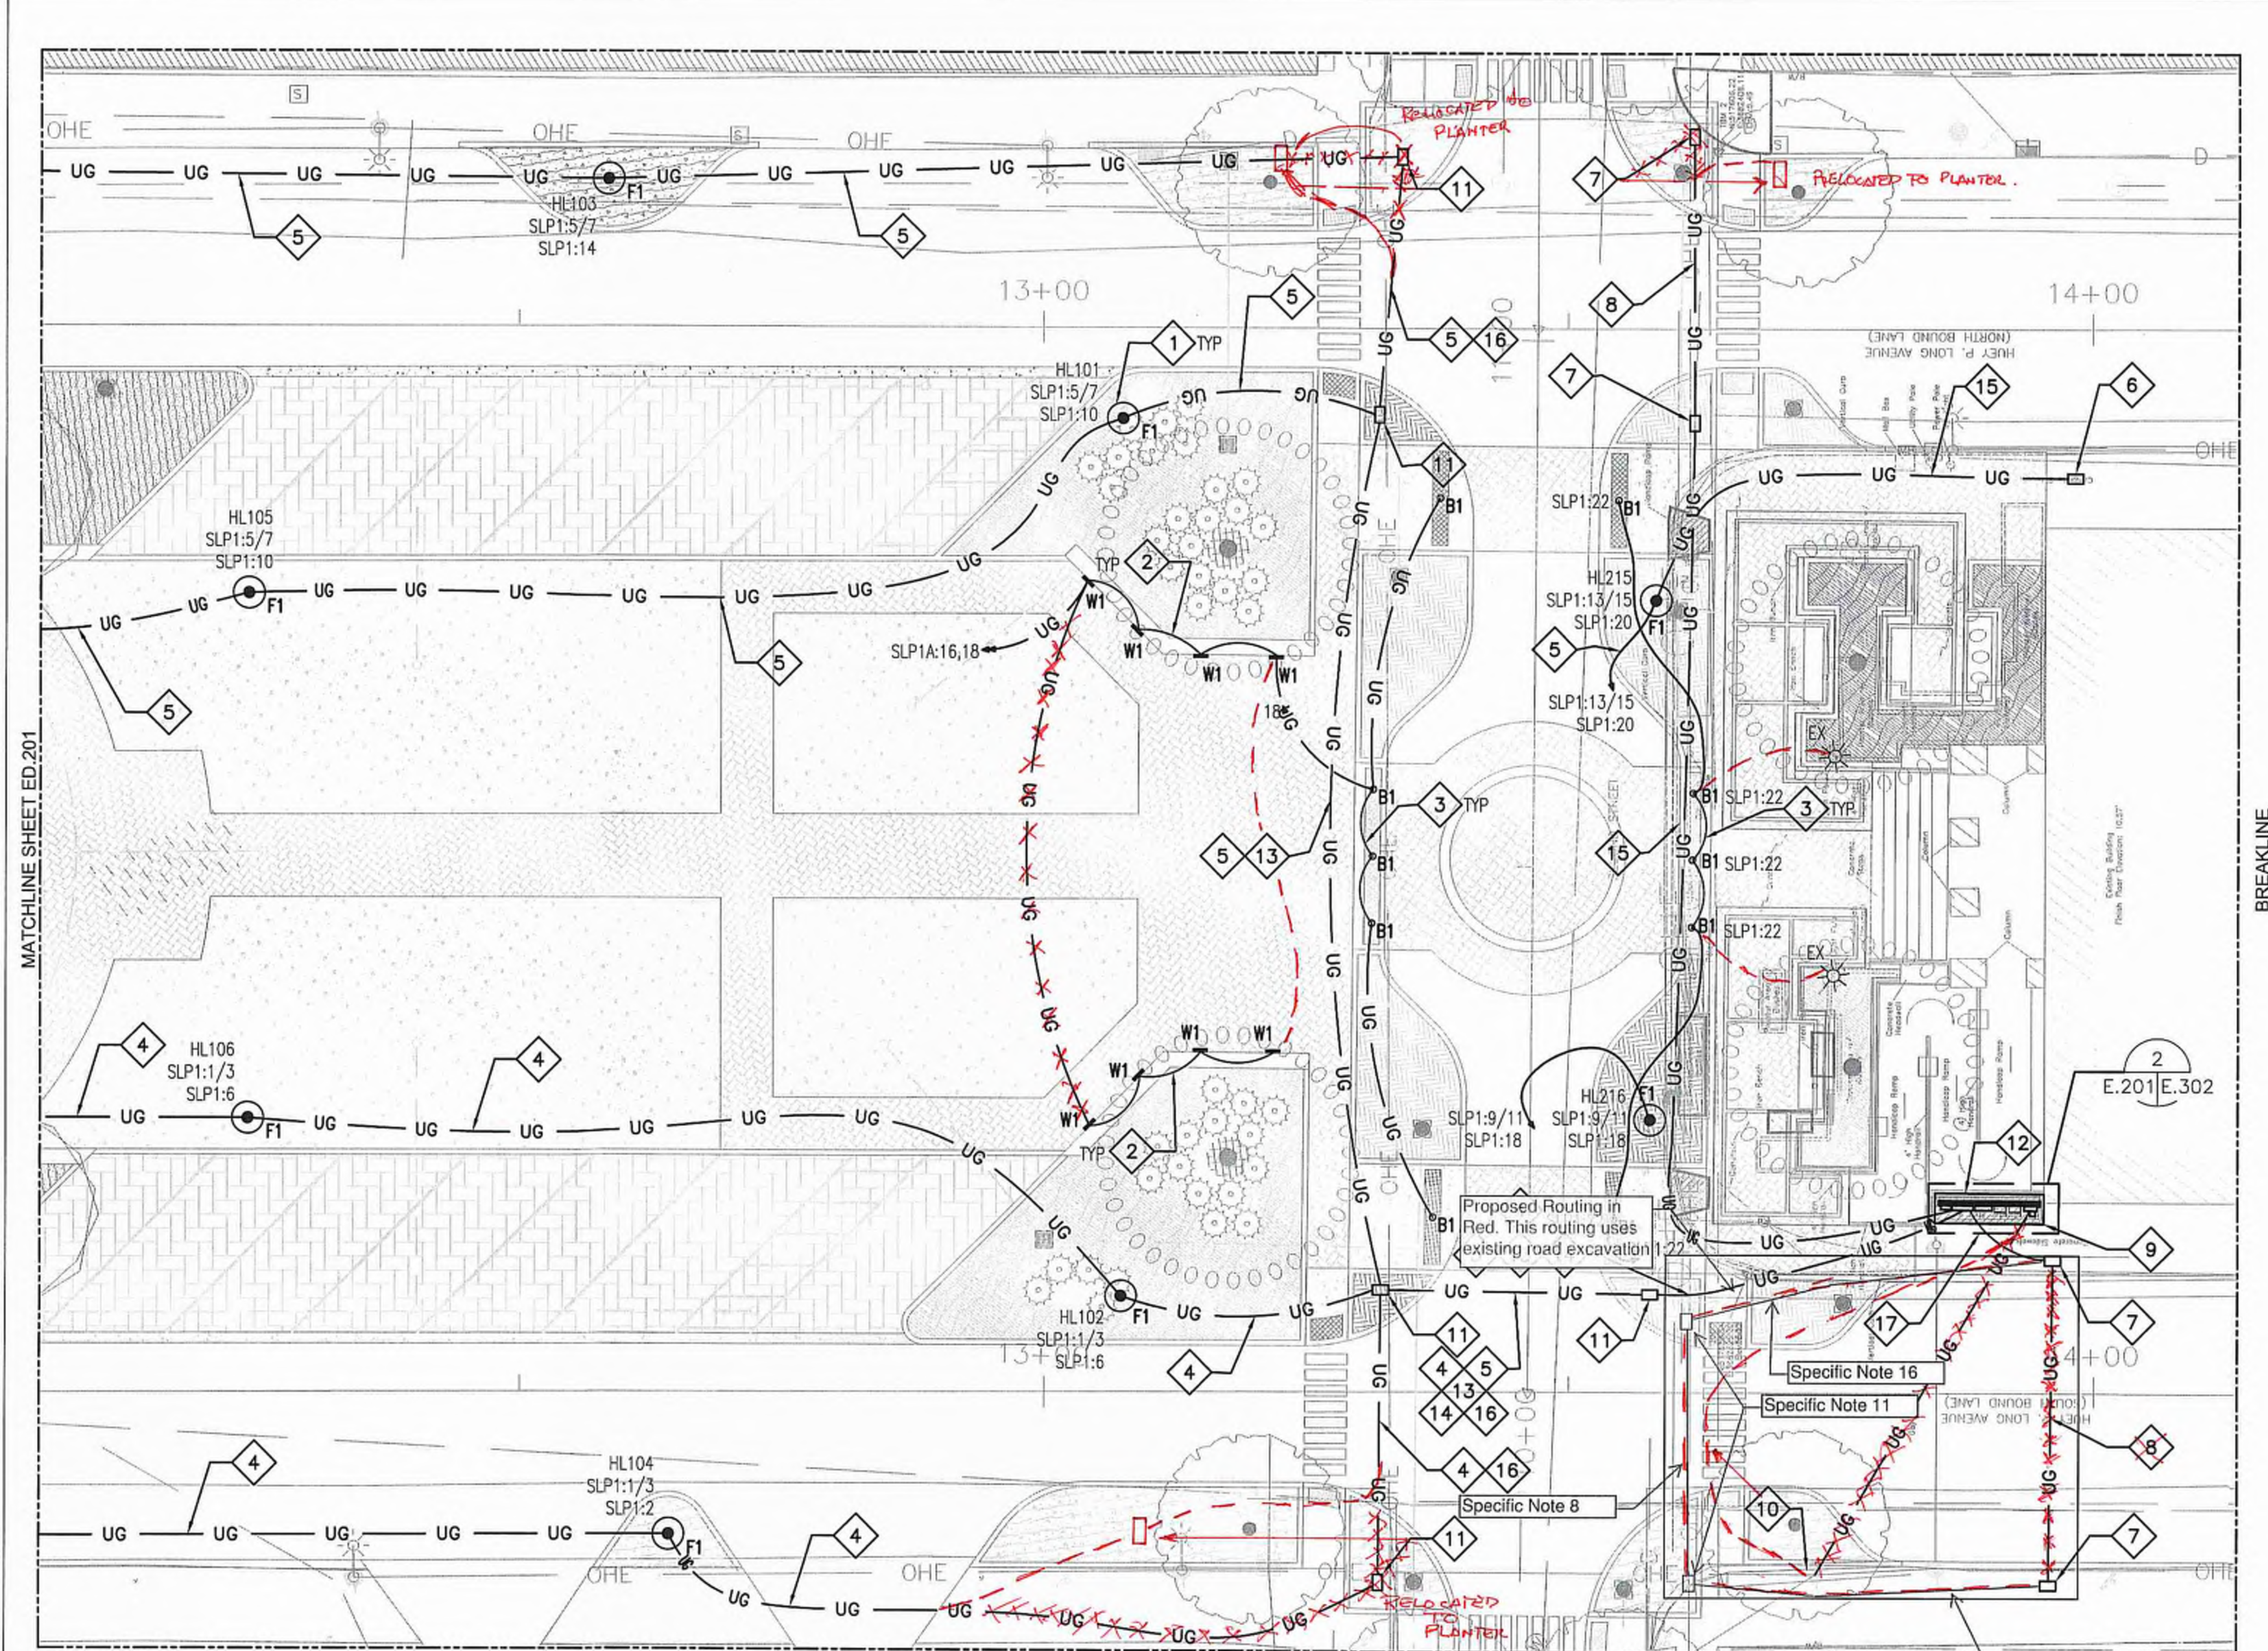

1 ELECTRICAL PLAN
E.202/E.202

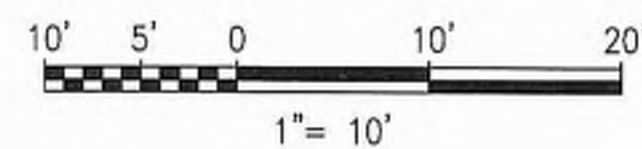

SHEET E.202 NOTES:

1. PROJECT INVOLVES PLACING POLE FOUNDATIONS IN CLOSE PROXIMITY TO OVERHEAD POWER AND COMMUNICATIONS LINES AND UNDERGROUND UTILITIES. CONTRACTOR SHALL EXERCISE CAUTION AND MAINTAIN PROPER UTILITY STANDARD CLEARANCES.
2. UNLESS OTHERWISE STATED, PROVIDE 1" SCHEDULE 40 PVC/HDPE CONDUIT FOR UNDERGROUND LIGHTING AND RECEPTACLE CIRCUITING.
3. CONDUIT ROUTING AND BOX LOCATIONS ARE SCHEMATIC. ROUTING MAY BE ADJUSTED TO AVOID INTERFERENCES. REFERENCE ARCHITECTURAL DRAWINGS FOR DIMENSIONED LOCATIONS OF POLES.
4. ALL TRENCHING/BORING/DRILLING WITHIN EXISTING TREE CANOPY SHALL BE COORDINATED WITH AND APPROVED BY PROJECT ARBORIST PRIOR TO COMMENCING ANY WORK AROUND TREES.
5. UNLESS NOTED OTHERWISE, PROVIDE #10 AWG COPPER CONDUCTORS FOR ALL LUMINAIRE CIRCUITS.
6. POLE SETBACK SHALL BE AS SHOWN ON ARCHITECTURAL DRAWINGS, MINIMUM SET BACK 2' C.L. OF POLE TO CURB.

SHEET E.202 SPECIFIC NOTES:

- 1 REFERENCE DETAIL 1/E.301 AND 2/E.301 TYPICAL EXCEPT WHERE NOTED OTHERWISE.
- 2 EMBED 1/2" CONDUIT IN WALL BETWEEN LUMINAIRES. TYPE W1 BACKBOX/HOUSING INSTALLATION MUST BE COORDINATED WITH BRICK INSTALLATION (SEE SHEET LS.505). BACKBOX/HOUSING AND RACEWAY INSTALLATION WILL OCCUR IN WALL SEAT CMU CONSTRUCTION PRIOR TO BRICK INSTALLATION THEREFORE PROPER CONSTRUCTION COORDINATION IS CRITICAL. CMU BLOCK WILL HAVE TO BE CUT/NOTCHED TO ALLOW THE INSTALLATION OF THE BACKBOX/HOUSING AND RACEWAY INSTALLATION.
- 3 ROUTE CONDUIT UNDERGROUND BETWEEN BOLLARDS.
- 4 1- 1 1/4"C, 2 #10, 4 #8, 1 #8 GND.
- 5 1- 1 1/2"C, 2 #10, 4 #6, 1 #6 GND.
- 6 QUAZITE 13" X 24" PG STYLE PULL BOX FURNISHED AND INSTALLED BY CONTRACTOR, SIMILAR TO DETAIL 3/E.301.
- 7 PROVIDE QUAZITE 13" X 24" PG STYLE PULL BOX AT END OF UNDER ROAD BORE. STUB INDICATED CONDUIT AND 2" SPARE CONDUIT (FURNISHED AND INSTALLED BY CONTRACTOR) INTO BOX. REFERENCE DETAIL 3/E.301.
- 8 2" CONDUIT AND 2" SPARE CONDUIT BORED UNDER ROADWAY. BORE, AND CONDUIT FURNISHED AND INSTALLED BY CONTRACTOR.
- 9 LIGHTING CONTROL PANEL AND SERVICE PAD LOCATION. COORDINATE CONDUIT STUB-UPS WITH CITY OF GRETNA.
- 10 UTILITY ELECTRICAL SERVICE FEED LOCATION. 3" SCHED. 80 PVC/HDPE CONDUIT FROM POLE TO PAD LOCATION DESIGNATED IN SPECIFIC NOTE 3. COORDINATE INSTALLATION WITH ENTERGY AND CITY OF GRETNA. BORE, AND CONDUIT SHALL BE FURNISHED AND INSTALLED CONTRACTOR.
- 11 QUAZITE 13" X 24" PG STYLE PULL BOX AT END OF UNDER ROAD BORE FURNISHED AND INSTALLED BY CONTRACTOR PER DETAIL 3/E.301.
- 12 ELECTRICAL SERVICE PULL BOX SHALL BE IN ACCORDANCE WITH ENTERGY SPECIFICATIONS AND APPROVED BY ENTERGY PRIOR TO INSTALLATION.
- 13 1- 1 1/4"C, 4 #6, 1 #6 GND.
- 14 1- 1 1/4"C, 4 #8, 1 #8 GND.
- 15 1- 1 1/2"C EMPTY WITH PULL WIRE.
- 16 1- 2"C EMPTY WITH PULL WIRE.
- 17 2- 1 1/2"C EMPTY PVC/HDPE WITH PULL WIRE.



CALL BEFORE YOU DIG:
Always dial 811 or 800 272-3020 first.
The call and the service are FREE.

BKI BURK-KLEINPETER, INC.
ENGINEERS, ARCHITECTS, PLANNERS, ENVIRONMENTAL SCIENTISTS
4176 CANAL STREET, NEW ORLEANS, LA 70119-5994
PHONE (504)488-5801 • FAX (504)488-1714

DANA BROWN & ASSOCIATES

DANA BROWN & ASSOCIATES, INC.
NEW ORLEANS, LA 70119-5994
www.danabrownassociates.com

**DOWNTOWN DRAINAGE
IMPROVEMENTS**
740 2nd Street
Gretna, Louisiana 70053

NOTES:

- PROTECT ALL EXISTING TREES ON SITE DURING CONSTRUCTION

AS BUILT
Frischmertz Electric Co., Inc.
by *[Signature]*
date *8/15/20*

REVISIONS

no.	description	date

PROJECT NUMBER:
DBA 1603


DATE:
01 MARCH 2019

ISSUE:
100% CONSTRUCTION
DOCUMENTS


SHEET TITLE:
**ELECTRICAL
PLAN**

SHEET NO.
E.202

20 February 2019 8:04am P:\00003448\0344-8359 HPL LIGHTING\DWG\GEN\LEC_145-Durham\0344-8359-E.301.dwg Layout - E.301
Copyright Dura Brown & Associates, Inc. All ideas, designs, arrangements or plans shall not be used by, or dedicated to any person, firm, or corporation without the written permission of Dura Brown & Associates, Inc.

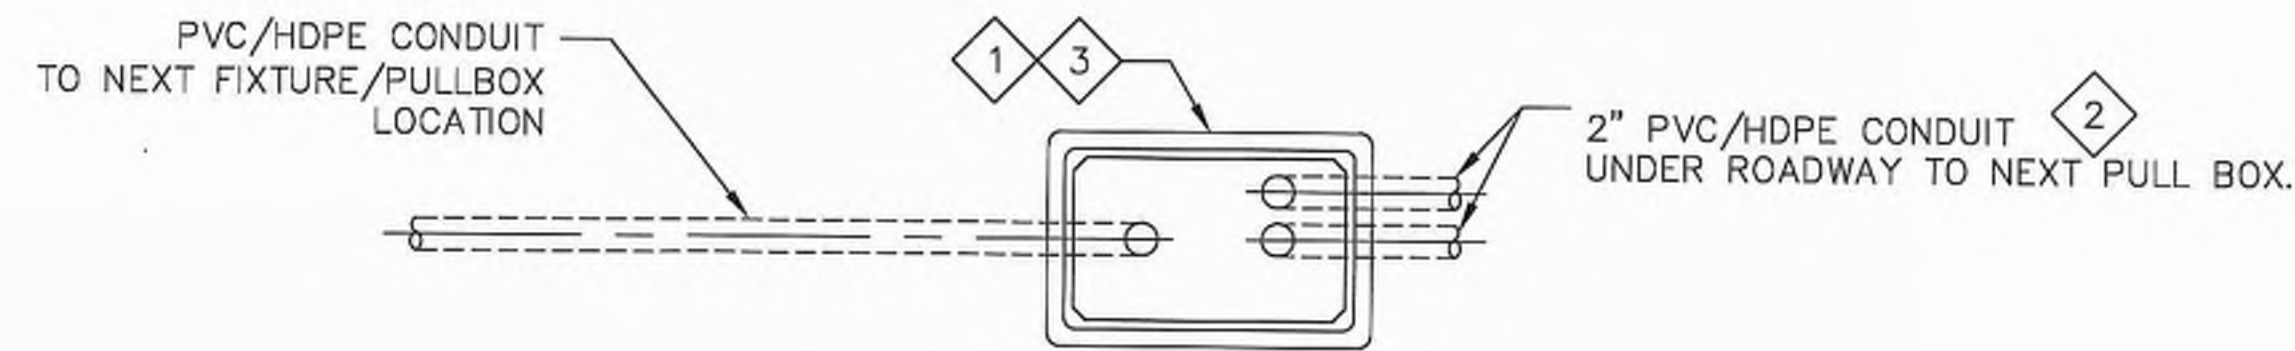


3 TYPICAL PULL BOX AT ROAD CROSSING
E.301 E.301 N.T.S.

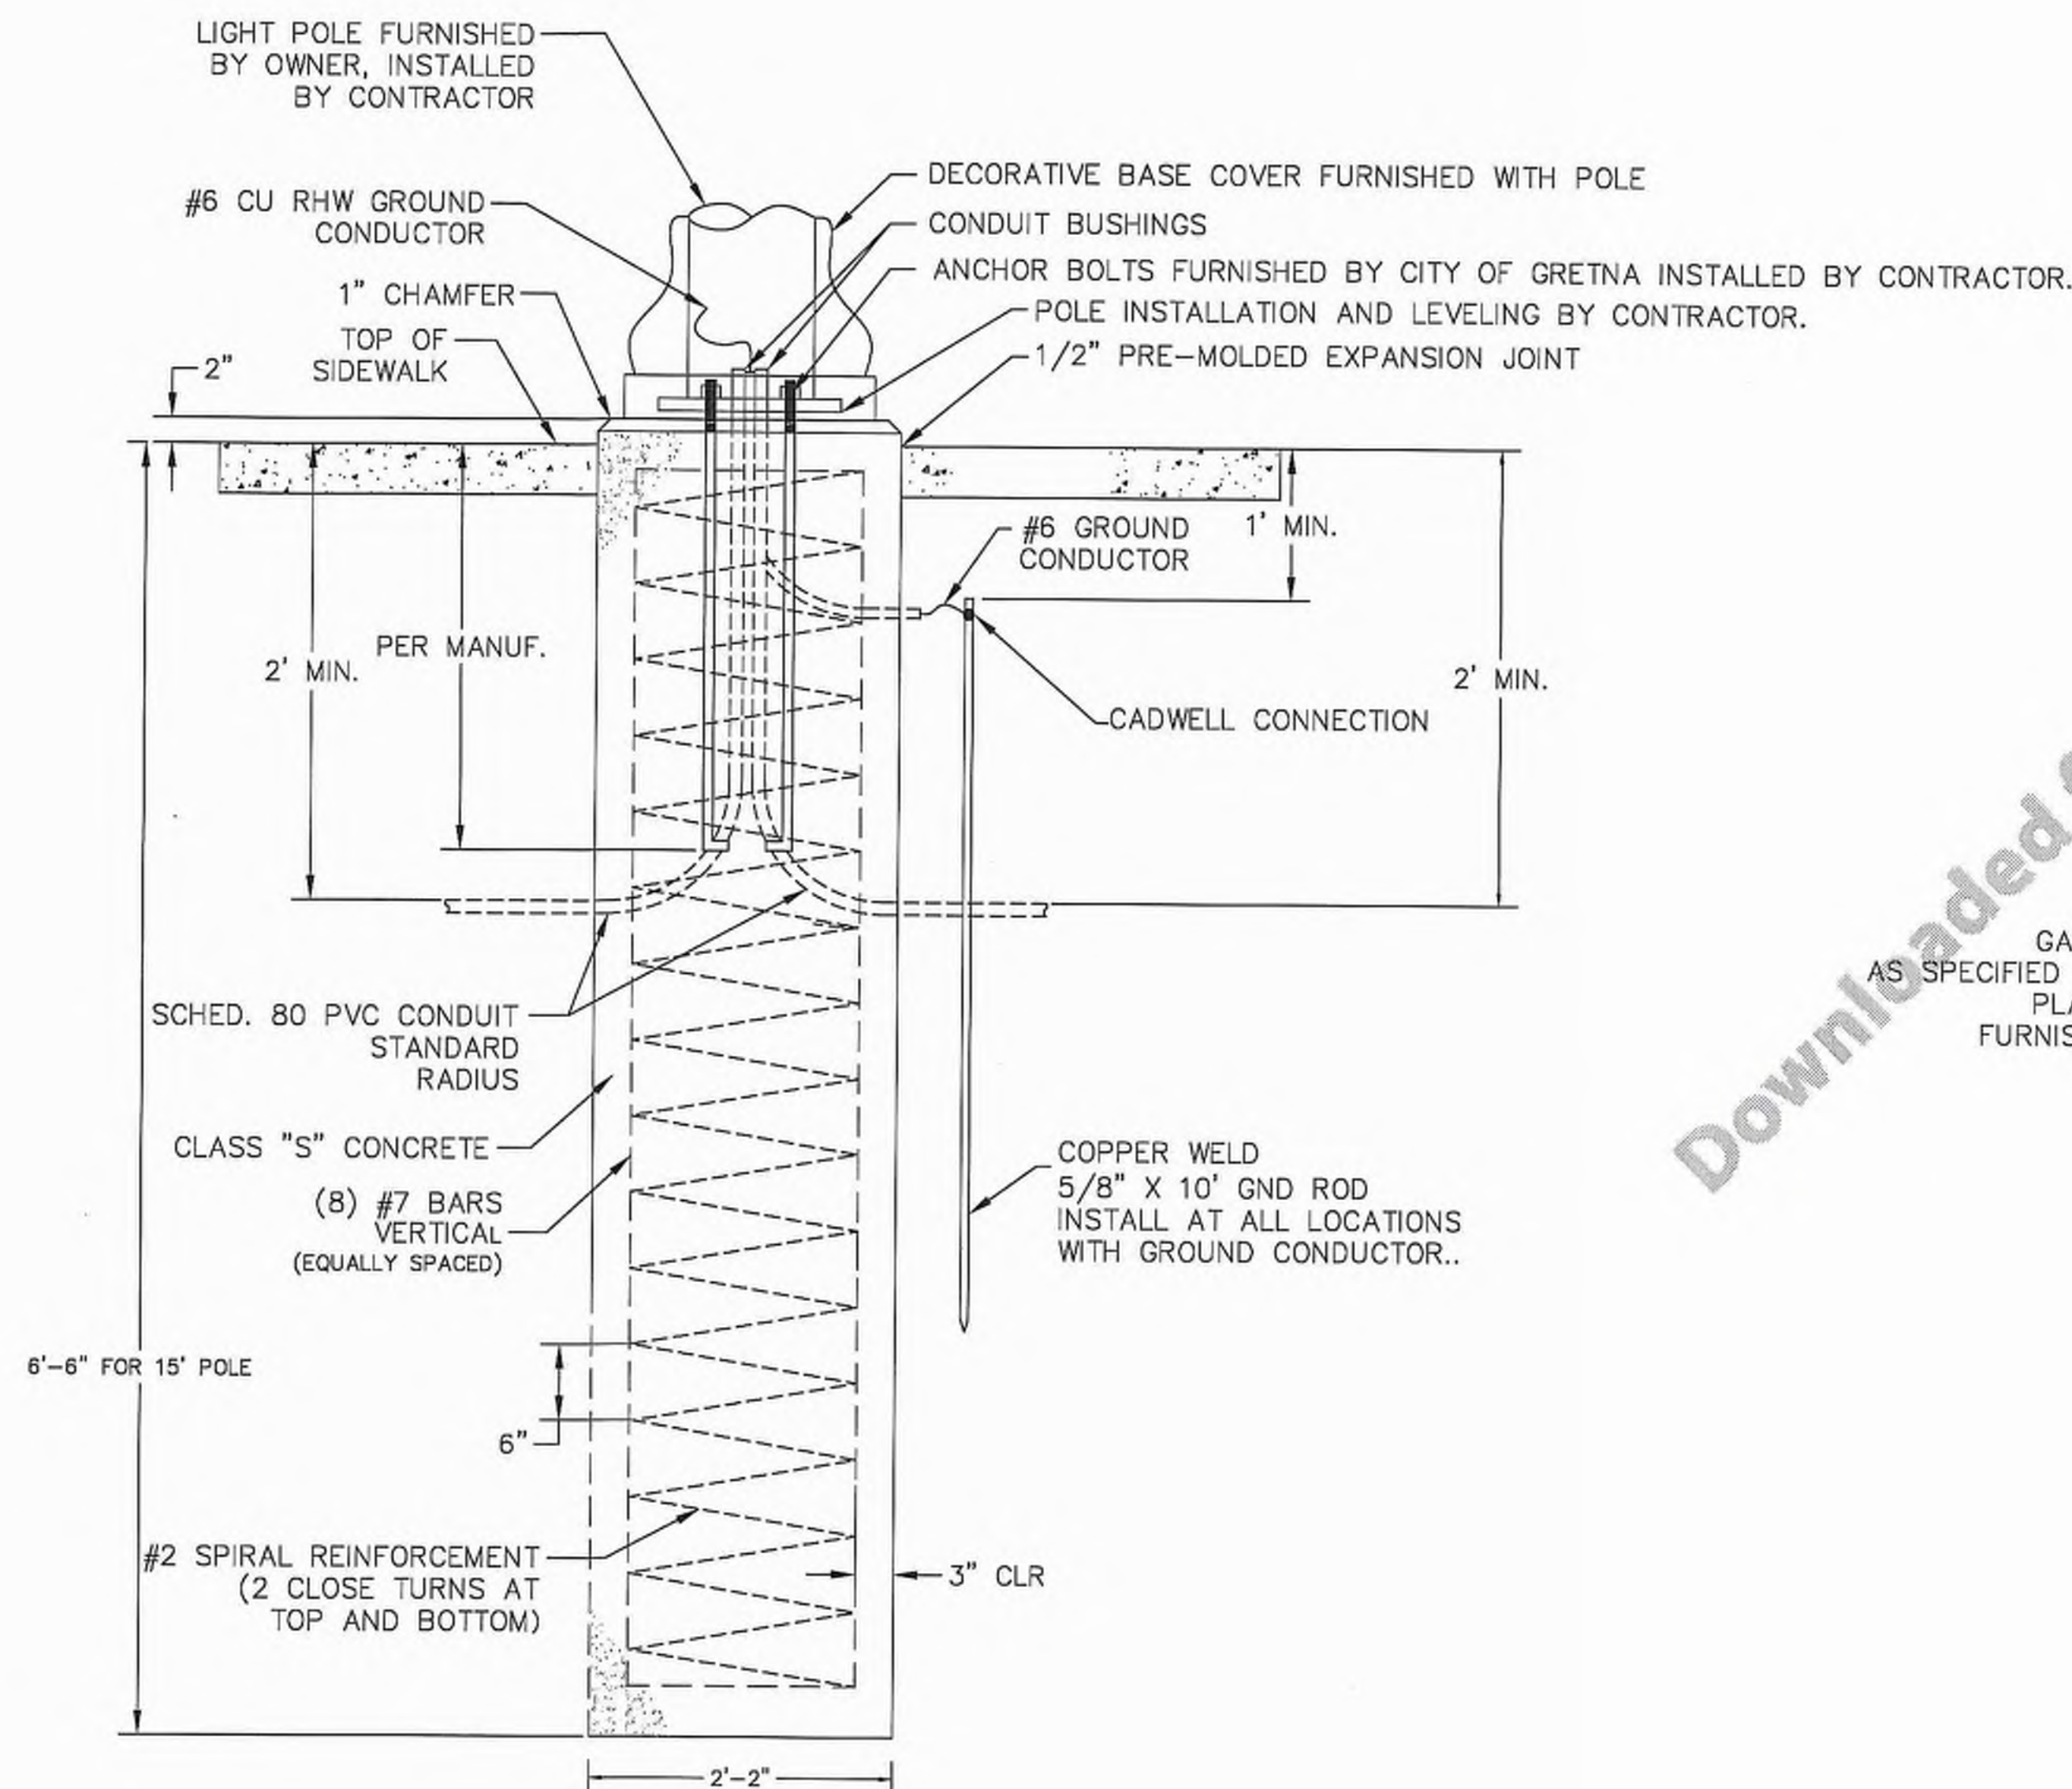

ELEVATION VIEW

1 TYPICAL STREET LIGHT FOUNDATION
E.301 E.301 N.T.S.

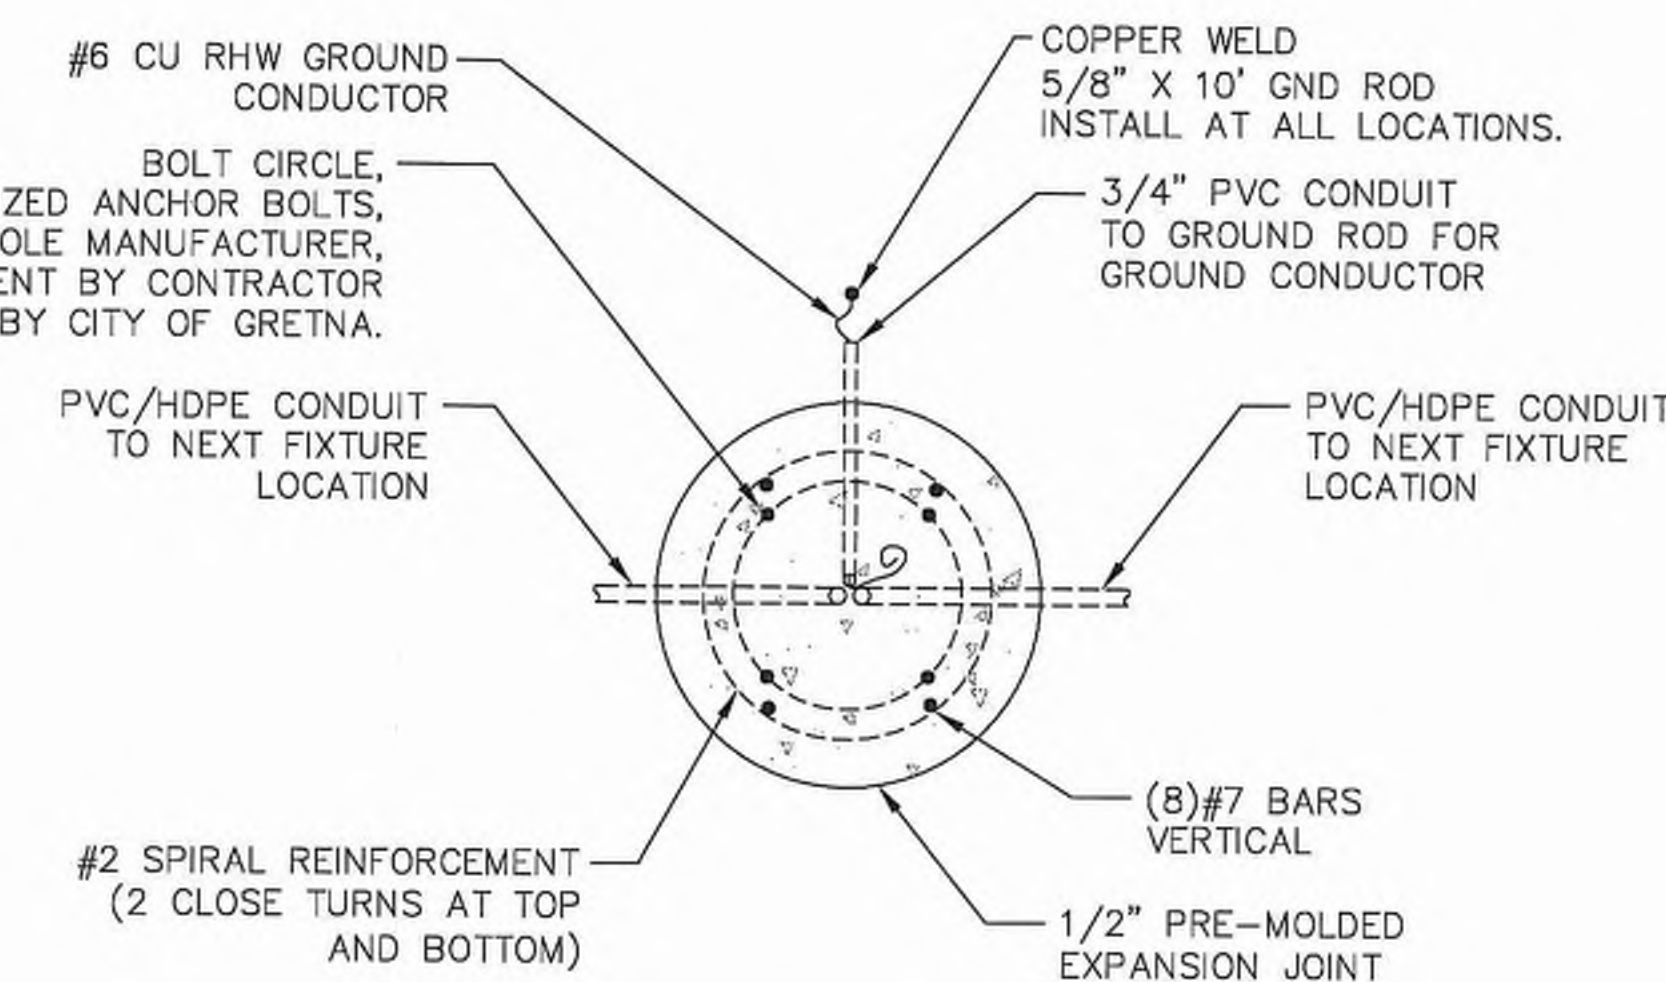

PLAN VIEW

2 TYPICAL STREET LIGHT FOUNDATION
E.301 E.301 N.T.S.

SHEET E.301 NOTES:

1. FOUNDATIONS SHALL BE OF CONCRETE CAST IN PLACE. 90 DEGREE PVC SCHEDULE 80 CONDUIT RADIUS FITTINGS (QUANTITY AS SHOWN IN DETAILS) WITH BUSHING AT TOP SHALL BE PROVIDED FOR RACEWAY AND SHALL BE PLACED WITH THE RACEWAY EXTENDING FOUR INCHES (4") ABOVE THE TOP OF THE FOUNDATION, AND SHALL EXTEND SIX INCHES (6") FROM SIDES OF THE FOUNDATION, BELOW GRADE, MINIMUM TWO FEET (2') BELOW GRADE.
2. INSTALLERS SHALL ALWAYS EXCAVATE THE PULL BOX HOLE AT LEAST 6"-8" DEEPER THAN THE DEPTH OF THE ENCLOSURE TO ALLOW FOR THE PLACEMENT OF A MINIMUM 6" OF GRAVEL IN THE BOTTOM OF THE HOLE. THE GRAVEL BASE SHOULD EXTEND 6" BEYOND THE SIDEWALLS OF THE ENCLOSURE.

SHEET E.301 SPECIFIC NOTES:

1. QUAZITE 13" X 24" PG STYLE (STACKABLE) ASSEMBLY. OPEN BOTTOM W/2 MOUSEHOLES (PG1324BB18), WITH GASKET HEAVY DUTY TRAFFIC RATED COVER AND TWO BOLTS (PG1324HG00), IMPRINTED. "LIGHTING" ON TOP.
2. RACEWAY CROSSING ROADWAYS SHALL HAVE AT LEAST TWO (2) FEET OF COVER BELOW THE ROADWAY, AND TWO (2) FEET OF COVER BELOW DITCHES OR DRAINAGE STRUCTURES.
3. PROVIDE BOX ONLY WHERE SHOWN ON PLANS.

DOWNTOWN DRAINAGE
IMPROVEMENTS
740 2nd Street
Gretna, Louisiana 70053

NOTES:

- PROTECT ALL EXISTING TREES ON SITE DURING CONSTRUCTION
AS BUILT
Friedrich Electric Co., Inc.
by *[Signature]*
date 7/14/2019

REVISIONS

NO.	DESCRIPTION	DATE

PROJECT NUMBER:
DBA 1603

DATE:
01 MARCH 2019

ISSUE:
100% CONSTRUCTION
DOCUMENTS

SHEET TITLE:
ELECTRICAL
TYPICAL DETAILS

SHEET NO.
E.301




CALL BEFORE YOU DIG:
Always dial 811 or 800 272-3020 first.
The call and the service are FREE.


BKI BURK-KLEINPETER, INC.
ENGINEERS, ARCHITECTS, PLANNERS, ENVIRONMENTAL SCIENTISTS
4176 CANAL STREET, NEW ORLEANS, LA 70119-5994
PHONE (504)486-5901 • FAX (504)486-1714

Please go to publicpurchase.com to make sure you have the latest information and any addendums released

Copyright 10 January 2020 10:28am P:\00004034\04034-0301\HPL LIGHTING\DESIGN\ELEC. 14-2nd\04034-0301-E.302.dwg Layout = E.302
Dana Brown & Associates, Inc. All items, design, arrangements, and plans represented by this drawing are owned by and the property of Dana Brown & Associates, Inc. and are created for the exclusive use of the specified project. These items, design, arrangements or plans shall not be used by or disclosed to any person, firm, or corporation without the written permission of Dana Brown & Associates, Inc.

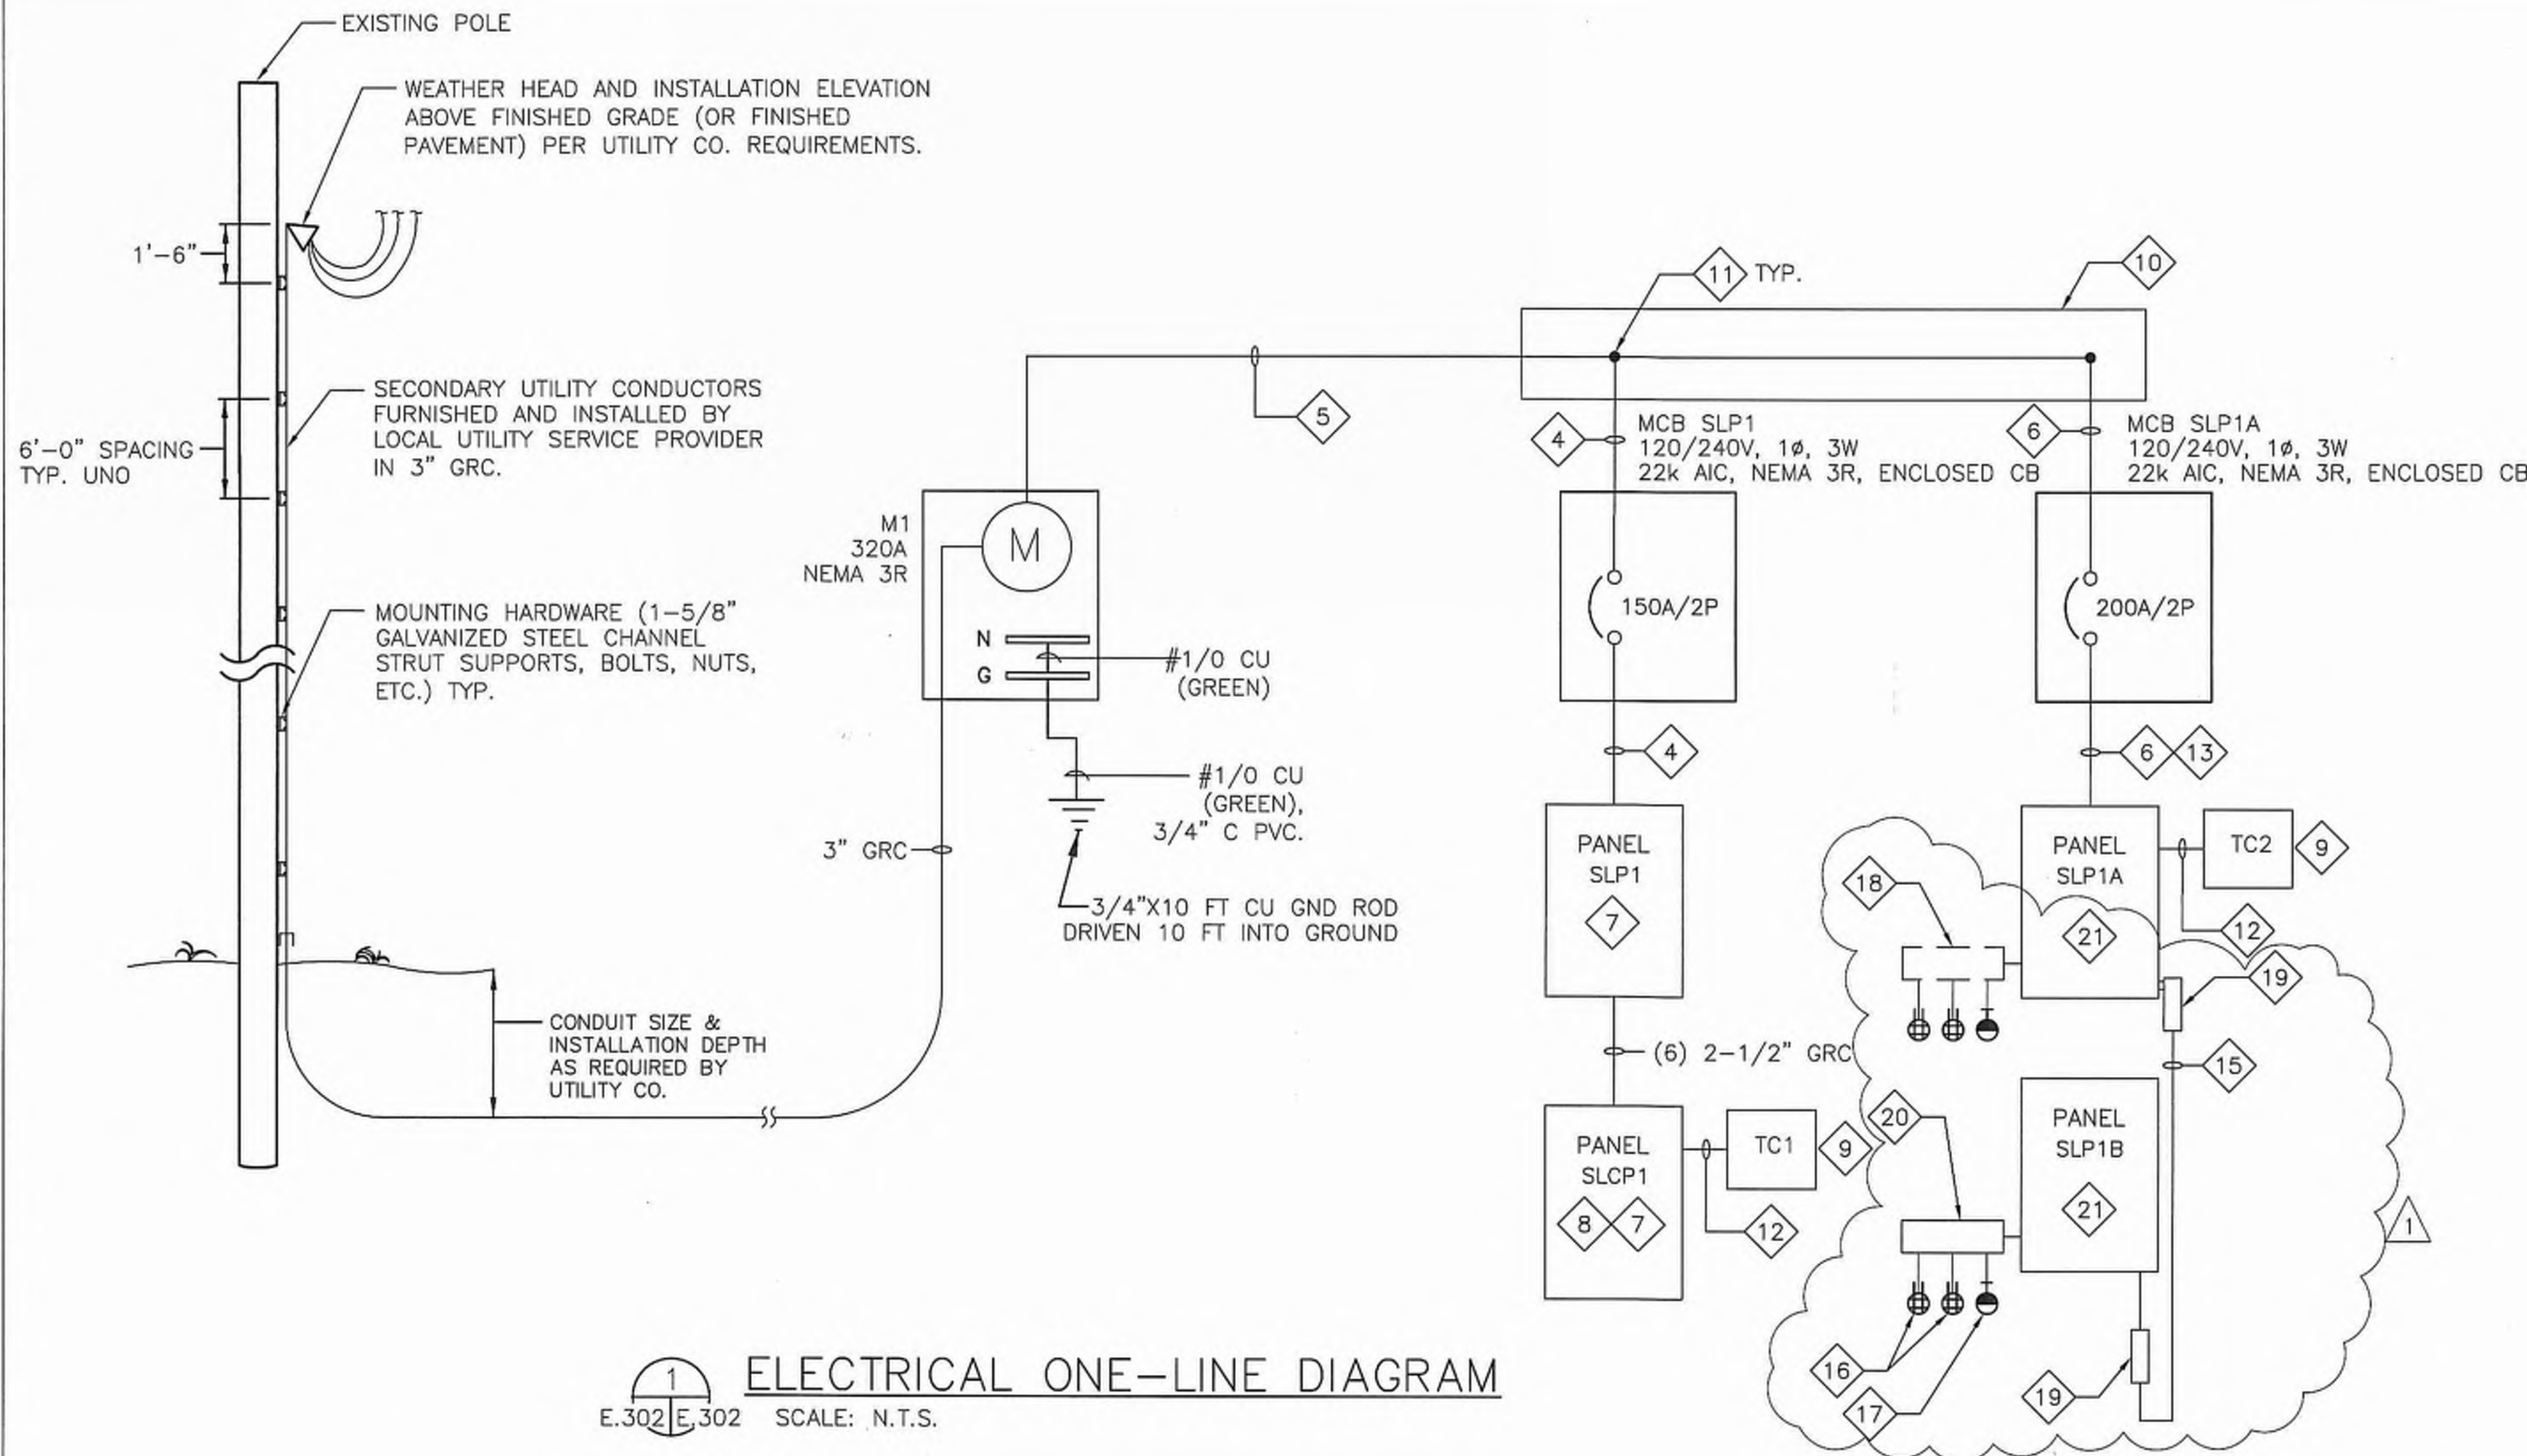

1 ELECTRICAL ONE-LINE DIAGRAM
E.302 E.302 SCALE: N.T.S.

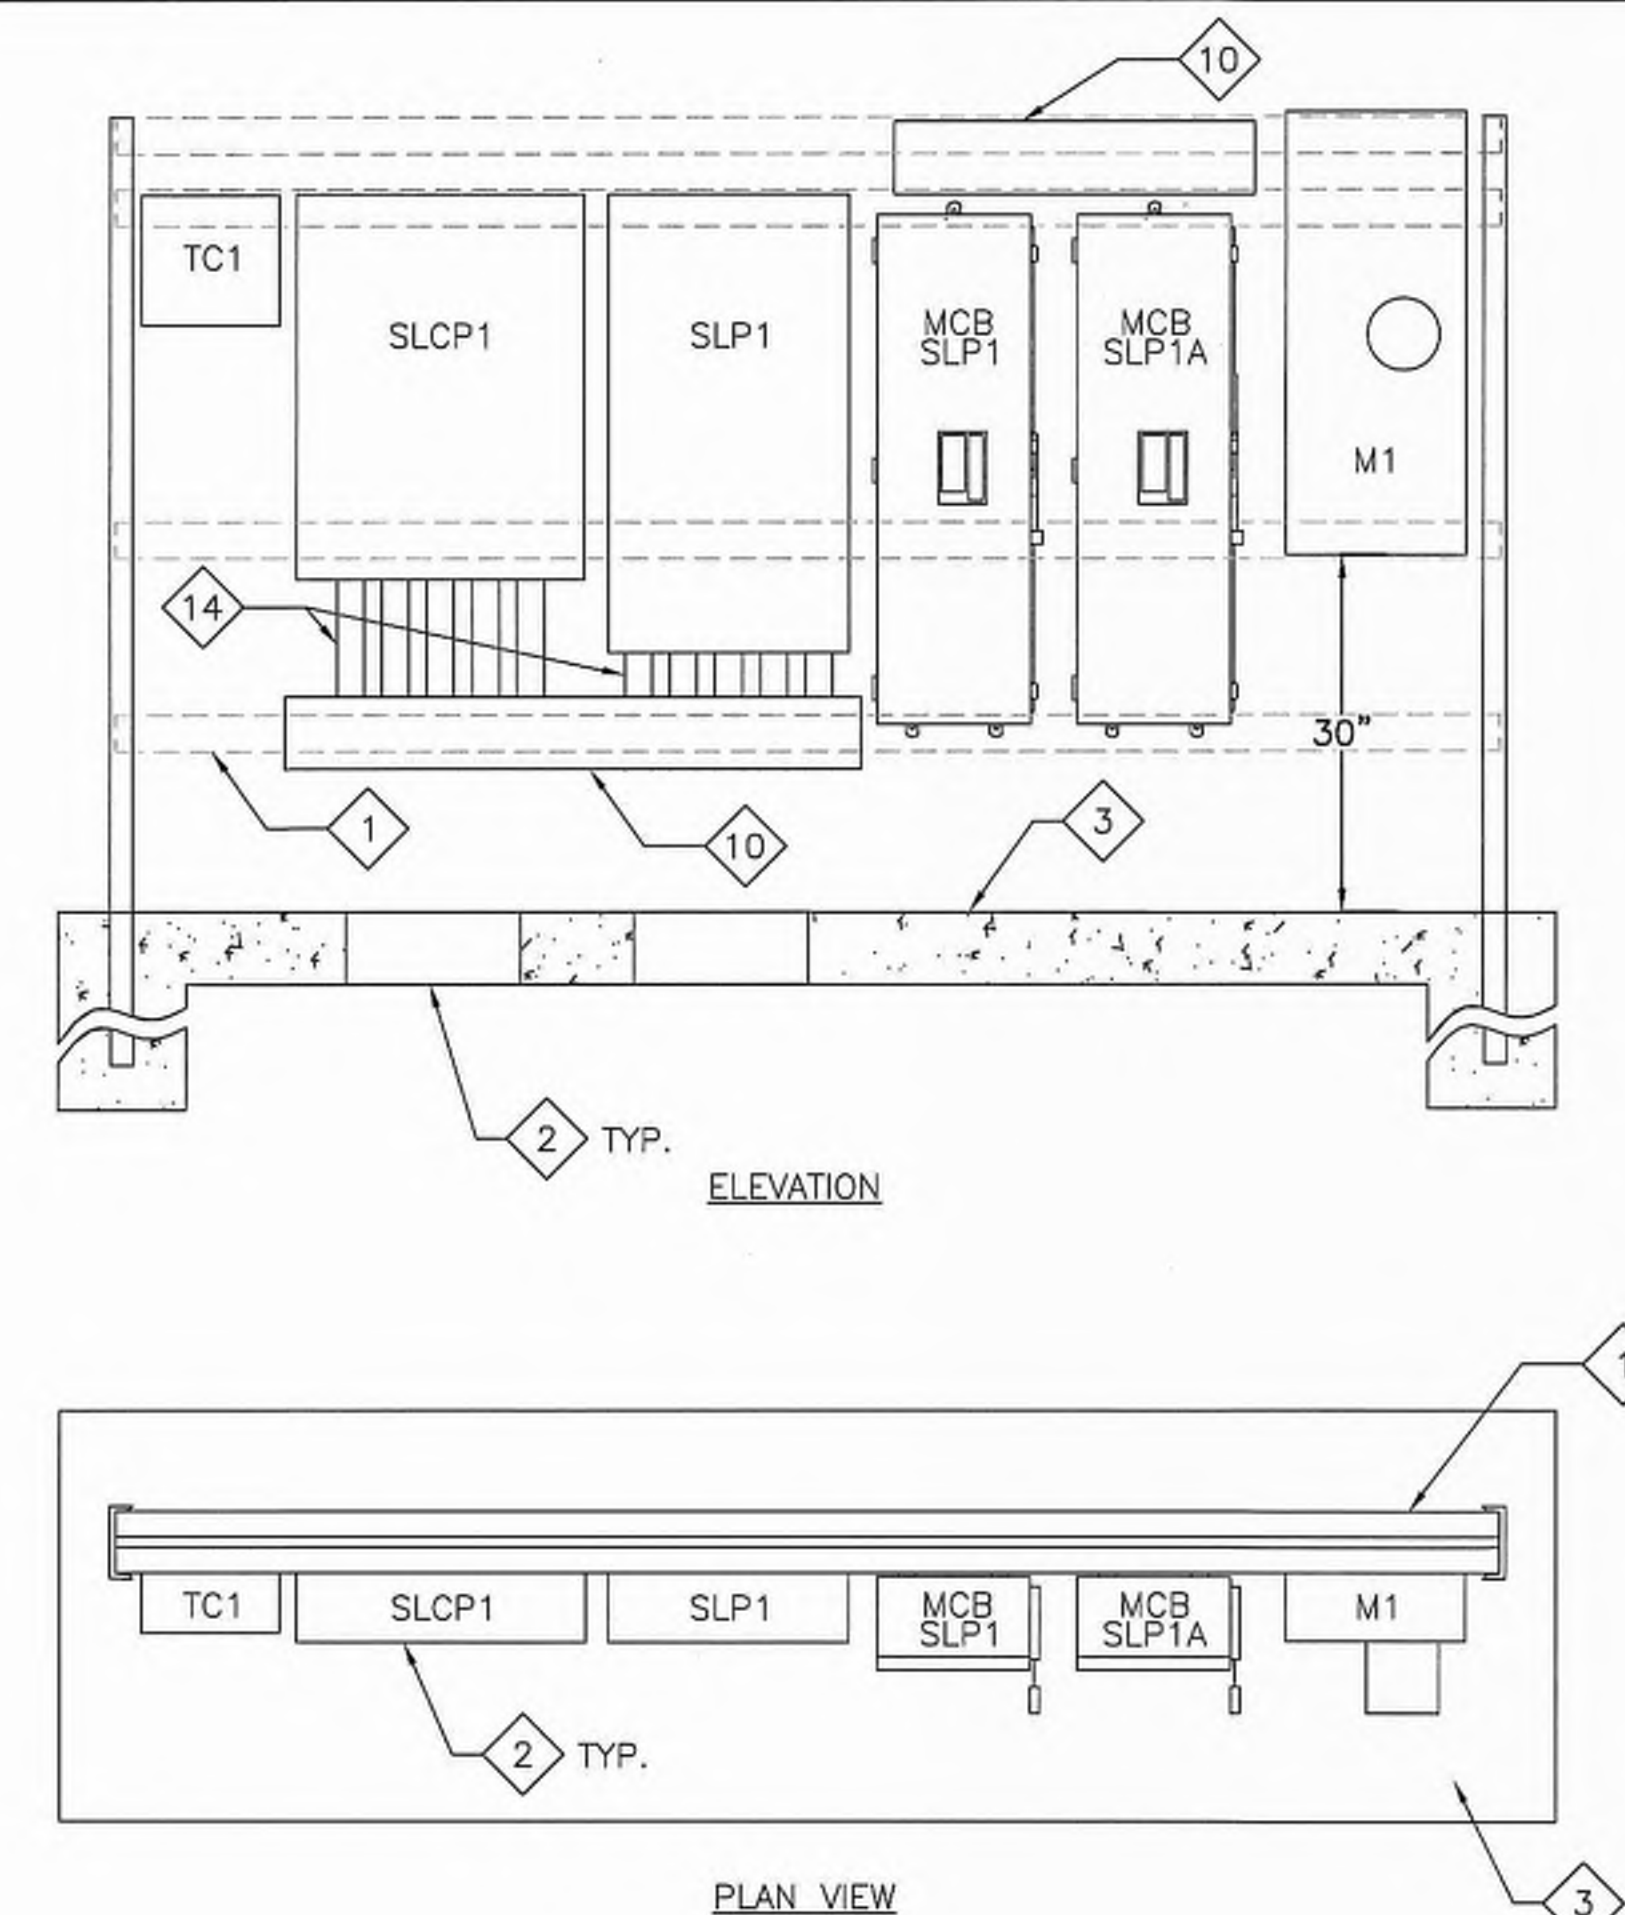

2 PANEL MOUNTING DETAILS
E.202 E.302 SCALE: N.T.S.

SHEET E.302 SPECIFIC NOTES:

- 1 PAINT ALL STRUCTURAL SUPPORTS, FASTENING MATERIALS, PANELS, CANS, CONDUIT, ETC. AND ANY EXPOSED MATERIALS, COLOR AS SELECTED BY ARCHITECT. SUBMIT SAMPLE COLOR CHIPS FOR ARCHITECT AND OWNER APPROVAL. ALL EQUIPMENT (INCLUDING BUT NOT LIMITED TO ALL METER, TROUGH, PANELBOARD, CIRCUIT BREAKER, AND LIGHTING CONTROL PANEL) SHALL BE FACTORY PAINTED OR PROFESSIONALLY PAINTED WITH SUPER TGIC THERMOSET POLYESTER POWDER COAT PAINT, WITH MINIMUM OF 2 COATS PRIMER, 2 COATS RUST INHIBITOR & 2 FINAL COATS. ALL STRUCTURAL SUPPORTS, FASTENING MATERIALS, CONDUIT, ETC. SHALL BE PROFESSIONALLY PAINTED WITH SUPER TGIC THERMOSET POLYESTER POWDER COAT PAINT, WITH MINIMUM OF 2 COATS PRIMER & 2 FINAL COATS. AFTER INSTALLATION AND TESTING IS COMPLETE, ALL STRUCTURAL SUPPORTS, FASTENING MATERIALS, EQUIPMENT, CONDUIT, ETC. SHALL HAVE TOUCH-UP PAINT APPLIED TO ANY AREA WHERE THE FACTORY OR PROFESSIONAL PAINT IS DAMAGED.
- 2 PROVIDE BLOCK OUT FOR CONDUIT INCLUDING ROOM FOR SPARES. FILL IN BLOCK OUT WITH LIGHT WEIGHT CONCRETE AFTER ALL CONDUIT HAS BEEN INSTALLED.
- 3 PAD TO BE REINFORCED 3000# PSI CONCRETE MINIMUM WITH MAXIMUM 10" DEPTH BELOW PANELS AND NO REINFORCEMENT IN CONDUIT BLOCK OUT BELOW PANELS. ALL STRUCTURAL SUPPORTS SHALL BE GALVANIZED C-CHANNEL & ANGLE ONLY AND ALL FASTENING MATERIALS SHALL BE STAINLESS STEEL NUTS, BOLTS, ETC. ONLY. CONSULT LICENSED PROFESSIONAL STRUCTURAL ENGINEER IN THE STATE OF LOUISIANA FOR DESIGN OF STRUCTURAL SUPPORTS WITH COST INCLUDED IN THIS CONTRACT.
- 4 3 #1/0 + #6 GROUND IN 1-1/2" RGS CONDUIT.
- 5 3 #500 + #3 GROUND IN 3" RGS CONDUIT.
- 6 3 #4/0 + #4 GROUND IN 2-1/2" RGS CONDUIT.
- 7 FURNISH AND INSTALL (2) 1" PVC AND (2) 2" PVC SPARE CONDUITS. CONDUITS SHALL RUN FROM PANEL AND STUB OUT 3 FEET FROM PANEL HORIZONTALLY AT MINIMUM DEPTH OF 36".

- 8 PROVIDE BASIC CONTACTOR LIGHTING CONTROL PANEL. PANEL SHALL CONSIST OF NEMA 3R ENCLOSURE WITH FACTORY ASSEMBLED INTERIOR WITH TUB, COVER, AND POWER SUPPLY. PROVIDE CONTACTOR RELAYS FOR A MINIMUM OF 24 CIRCUITS/RELAYS. SYSTEM SHALL CONSIST OF RELAY PANEL, SYSTEM ASTRONOMICAL TIME CLOCK, CONTROLLER AND GROUP SWITCHING CARD. SHALL INCLUDE ALL MEETINGS WITH USER GROUP TO DEFINE SCHEDULE REQUIREMENT, ON SITE PROGRAMMING AND 2 HOUR INSTRUCTIONS. CONTRACTOR IS RESPONSIBLE FOR ALL HARDWARE, SOFTWARE, WIRING, CONDUIT, EQUIPMENT, ETC. AS REQUIRED TO PROVIDE A COMPLETE AND FUNCTIONAL LIGHTING CONTROL PANEL SYSTEM INSTALLATION WITHOUT ANY ADDITIONAL COST TO THE OWNER. FINAL EQUIPMENT OPTIONS, ACCESSORIES, CAPACITY, ETC. SHALL BE DETERMINED DURING SHOP DRAWINGS REVIEW PROCESS AT NO ADDITIONAL COSTS. WAITSTOPPER MODEL #LP24S SERIES OR APPROVED EQUIVALENT.
- 9 PROVIDE SYSTEM ASTRONOMICAL TIME CLOCK, 8 CIRCUIT, NEMA 3R HEAVY DUTY ENCLOSURE WITH LOCKABLE HASP, 4000 EVENTS, 1 MINUTE TO 7 DAY TIME INTERVALS, 120-240V. INTERMATIC MODEL #ET70815CR OR APPROVED EQUIVALENT.
- 10 NEMA 3R HINGED COVER WIREWAY, 6" X 6" X LENGTH AS REQUIRED.
- 11 INSULATED IN-LINE CABLE TAP, BURNDY OR EQUIVALENT.
- 12 6#12 + 1#12 GROUND IN 3/4" CONDUIT.
- 13 RACEWAY IS NOT SHOWN IN PLAN VIEW. RACEWAY SHALL BE RGS ABOVE GROUND, SCHED. 80 PVC/HDPE UNDERGROUND. RACEWAY SHALL BE BORED FOR CROSSING BELOW 2ND STREET. FURNISH PULL BOXES AT EACH END OF UNDER STREET BORE AND AS REQUIRED TO ACCOMMODATE PULLING OF FEEDER, SIMILAR TO DETAIL 3/E.301. BOXES SHALL BE QUAZITE 13" X 24" PG STYLE.
- 14 10 - 2" RGS CONDUITS BETWEEN SLC1, SLP1 AND WIREWAY, 5 FOR EACH PANEL.
- 15 3 #1 + #6 GND., 1 1/2"
- 16 QUADPLEX GFI RECEPTACLES IN TYPE FD BOXES WITH WEATHERPROOF COVERS, EACH ON SEPARATE CIRCUITS, SIMILAR TO EXISTING, REFER TO DETAIL 2, SHEET ED.101.
- 17 L14-30R, 30A, 125/250V TWIST-LOCK RECEPTACLE IN TYPE FD BOX WITH WEATHERPROOF COVER, HUBBELL 2710, SIMILAR TO EXISTING, REFER TO DETAIL 2, SHEET ED.101.

- 18 EXISTING RECEPTACLES AND WIREWAY TO REMAIN, RELOCATE AS NEEDED TO FACILITATE RECONNECTION TO NEW PANEL SLP1A. REFER TO DETAIL 2, SHEET ED.101. REWIRE AS NECESSARY.
- 19 RACEWAY SHALL EXIT PANEL SLP1A DIRECTLY ADJACENT TO 125A/2P BREAKER USING MOGUL LB FITTING AND UNION. OFFSET CONDUIT DOWN AND ROUTE UNDERGROUND TO PANEL SLP1B ON WEST SIDE OF ARCH. INSTALL MOGUL PULL FITTING WHERE CONDUIT EXITS GRADE AND OFFSET INTO PANEL SLP1B. UNDERGROUND PORTION SHALL BE SCHEDULE 80 PVC.
- 20 NEMA 3R WIREWAY, 6" X 6" X LENGTH AS REQUIRED, SIMILAR TO EXISTING, REFER TO DETAIL 3, SHEET ED.101.
- 21 INSTALL PANELS ON UNISTRUT STANDOFFS AS REQUIRED TO ALLOW CONDUIT TO CLEAR BASE OF ARCH AND ENTER BOTTOM OF PANELBOARDS. MOUNT PANELBOARDS SUCH THAT THE TOP CIRCUIT BREAKERS ARE NO HIGHER THAN 6'7" AFG.

BKI BURK-KLEINPETER, INC.
ENGINEERS, ARCHITECTS, PLANNERS, ENVIRONMENTAL SCIENTISTS
4176 CANAL STREET, NEW ORLEANS, LA 70119-5994
PHONE (504)486-5901 • FAX (504)488-1714

LA One Call
CALL BEFORE YOU DIG:
Always dial 811 or 800 272-3020 first.
The call and the service are FREE.

STATE OF LOUISIANA
PERRY P. HOGAN
REG. NO. 31042
REGISTERED PROFESSIONAL ENGINEER
ELECTRICAL ENGINEERING
10/10/20

DANA BROWN & ASSOCIATES, INC.
NEW ORLEANS • 504-345-2639
www.danabrownassociates.com

DOWNTOWN DRAINAGE IMPROVEMENTS
740 2nd Street
Gretna, Louisiana 70053

NOTES:
• PROTECT ALL EXISTING TREES ON SITE DURING CONSTRUCTION

REVISIONS	DATE	BY
1	01/XX/20	

AS-BUILT
Frisch Electric Co., Inc.
by *[Signature]*
date 10/15/20

PROJECT NUMBER:
DBA 1603

DATE:
01 MARCH 2019

ISSUE:
100% CONSTRUCTION DOCUMENTS

SHEET TITLE:
ONE-LINE DIAGRAM & DETAILS

SHEET NO.
E.302

Copyright 10 January 2020 10:27am P:\00003448\0448350 HPL LIGHTING\DESIGN\LEC_16-2nd\0448350-E-401-401A.dwg Layout = E-401
Accepted: Dana Brown & Associates, Inc. All items, designs, arrangements, and plans represented by this drawing are owned by and the property of Dana Brown & Associates, Inc., and were created for the exclusive use of the specified project. These items, designs, arrangements or plans shall not be used by or disclosed to any person, firm, or corporation without the written permission of Dana Brown & Associates, Inc.

CKT 42		NEMA 3R		SYM RMS AMPS		22000					
MAIN		SYSTEM VOLTAGE		SCHEDULE OF PANEL							
MLO 225		120/240 1ph, 3wire		SLP1							
				MOUNTING MOUNTING							
				LOCATION HPL @ 2ND							
CIR NO.	CIRCUIT DESCRIPTION	C/B TRIP	POLE	KVA	PHASES		KVA	POLE	C/B TRIP	CIRCUIT DESCRIPTION	CIR NO.
					A	B					
1	LIGHTING	20	2	0.80	0.76		0.36	1	20	RECEPTACLES	2
3						0.76	0.36	1	20	RECEPTACLES	4
5	LIGHTING	20	2	0.80	0.94		0.54	1	20	RECEPTACLES	6
7						0.76	0.36	1	20	RECEPTACLES	8
9	LIGHTING	20	2	0.09	0.58		0.54	1	20	RECEPTACLES	10
11						0.40	0.36	1	20	RECEPTACLES	12
13	LIGHTING	20	2	0.09	0.40		0.36	1	20	RECEPTACLES	14
15						0.40	0.36	1	20	RECEPTACLES	16
17	SPARE	20	2		0.18		0.18	1	20	RECEPTACLES	18
19						0.18	0.18	1	20	RECEPTACLES	20
21	SPARE	20	2		0.12		0.12	1	20	BOLLARD LIGHTS	22
23								1	20	TIME CLOCK SPARE	24
25	SPARE	20	2					1	20	SPARE	26
27								1	20	SPARE	28
29	SPARE	20	2					1	20	SPARE	30
31								1	20	SPARE	32
33	SPARE	20	2					1	20	SPARE	34
35								1	20	SPARE	36
37	SPARE	20	2					1	20	SPARE	38
39								1	20	SPARE	40
41	SPARE	20	1					1	20	SPARE	42
					2.99		2.51				
					TOTAL KVA CONNECTED :						
					5.50		KVA				

SHEET E.401 SPECIFIC NOTES:

1. ASTERISK (*) INDICATES BOLT-ON REMOTELY OPERATED ECB-G3 SERIES 14,000 AIR CIRCUIT BREAKER FOR POWER LINK LIGHTING CONTROL PANELS.

SHEET E.401 SPECIFIC NOTES:

- 1 FURNISHED WITH 18 CIRCUIT CONTROL BUS FOR POWERLINK BREAKERS.

DANA BROWN & Associates

DANA BROWN & ASSOCIATES, INC.
NEW ORLEANS - 504-345-2639
www.danabrownassociates.com

DOWNTOWN DRAINAGE
IMPROVEMENTS
740 2nd Street
Gretna, Louisiana 70053

NOTES:

- PROTECT ALL EXISTING TREES ON SITE DURING CONSTRUCTION

REVISIONS

PANEL ADD/LIGHT MOD. 01/XX/20

AS BUILT
Friedrich Electric Co., Inc.
by
date

PROJECT NUMBER:
DBA 1603

DATE:
01 MARCH 2019

ISSUE:
100% CONSTRUCTION DOCUMENTS

SHEET TITLE:
PANEL SCHEDULES

SHEET NO.

E.401



CALL BEFORE YOU DIG:
Always dial 811 or 800 272-3020 first.
The call and the service are FREE.

BKI BURK-KLEINPETER, INC.
ENGINEERS, ARCHITECTS, PLANNERS, ENVIRONMENTAL SCIENTISTS
4176 CANAL STREET, NEW ORLEANS, LA 70119-5994
PHONE (504)486-5901 • FAX (504)488-1714

1 PANEL SCHEDULES
E.401 SCALE: N.T.S.

A triangle with the number 1 inside.

1
E.401 E.401

AS BUILT
Frischmertz Electric Co., Inc.
by [Signature]
date 11/15/20

REVISIONS		
no.	description	date
1	PANEL ADD./LIGHT MOD.	01/XX/20

PROJECT NUMBER:
DBA 1603

DATE:
01 MARCH 2019

ISSUE:
**100% CONSTRUCTION
DOCUMENTS**

SHEET TITLE:
PANEL SCHEDULES

SHEET NO.
E.401A



CALL BEFORE YOU DIG:
Always dial 811 or 800 272-3020 first.
The call and the service are FREE.

BKI **BURK-KLEINPETER, INC.**
ENGINEERS, ARCHITECTS, PLANNERS, ENVIRONMENTAL SCIENTISTS
4176 CANAL STREET, NEW ORLEANS, LA 70119-5994
PHONE (504)486-5901 • FAX (504)488-1714

DANA BROWN & Associates

DANA BROWN & ASSOCIATES, INC.
NEW ORLEANS - 504-345-2639
www.danabrownassociates.com

seal

**DOWNTOWN DRAINAGE
IMPROVEMENTS**
740 2nd Street
Gretna, Louisiana 70053

NOTES:

- PROTECT ALL EXISTING TREES ON SITE DURING CONSTRUCTION

REVISIONS		
no.	description	date
1	PANEL ADD./LIGHT MOD.	01/XX/20



PROJECT NUMBER:
DBA 1603

DATE:
01 MARCH 2019


ISSUE:
**100% CONSTRUCTION
DOCUMENTS**

SHEET TITLE:
PANEL SCHEDULES

SHEET NO.
E.401A

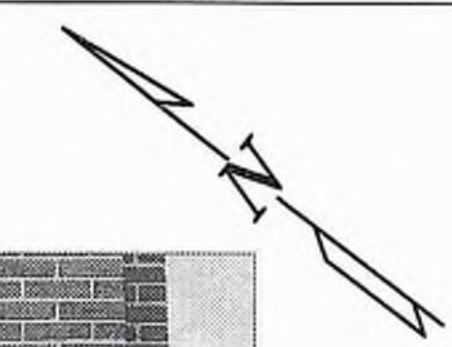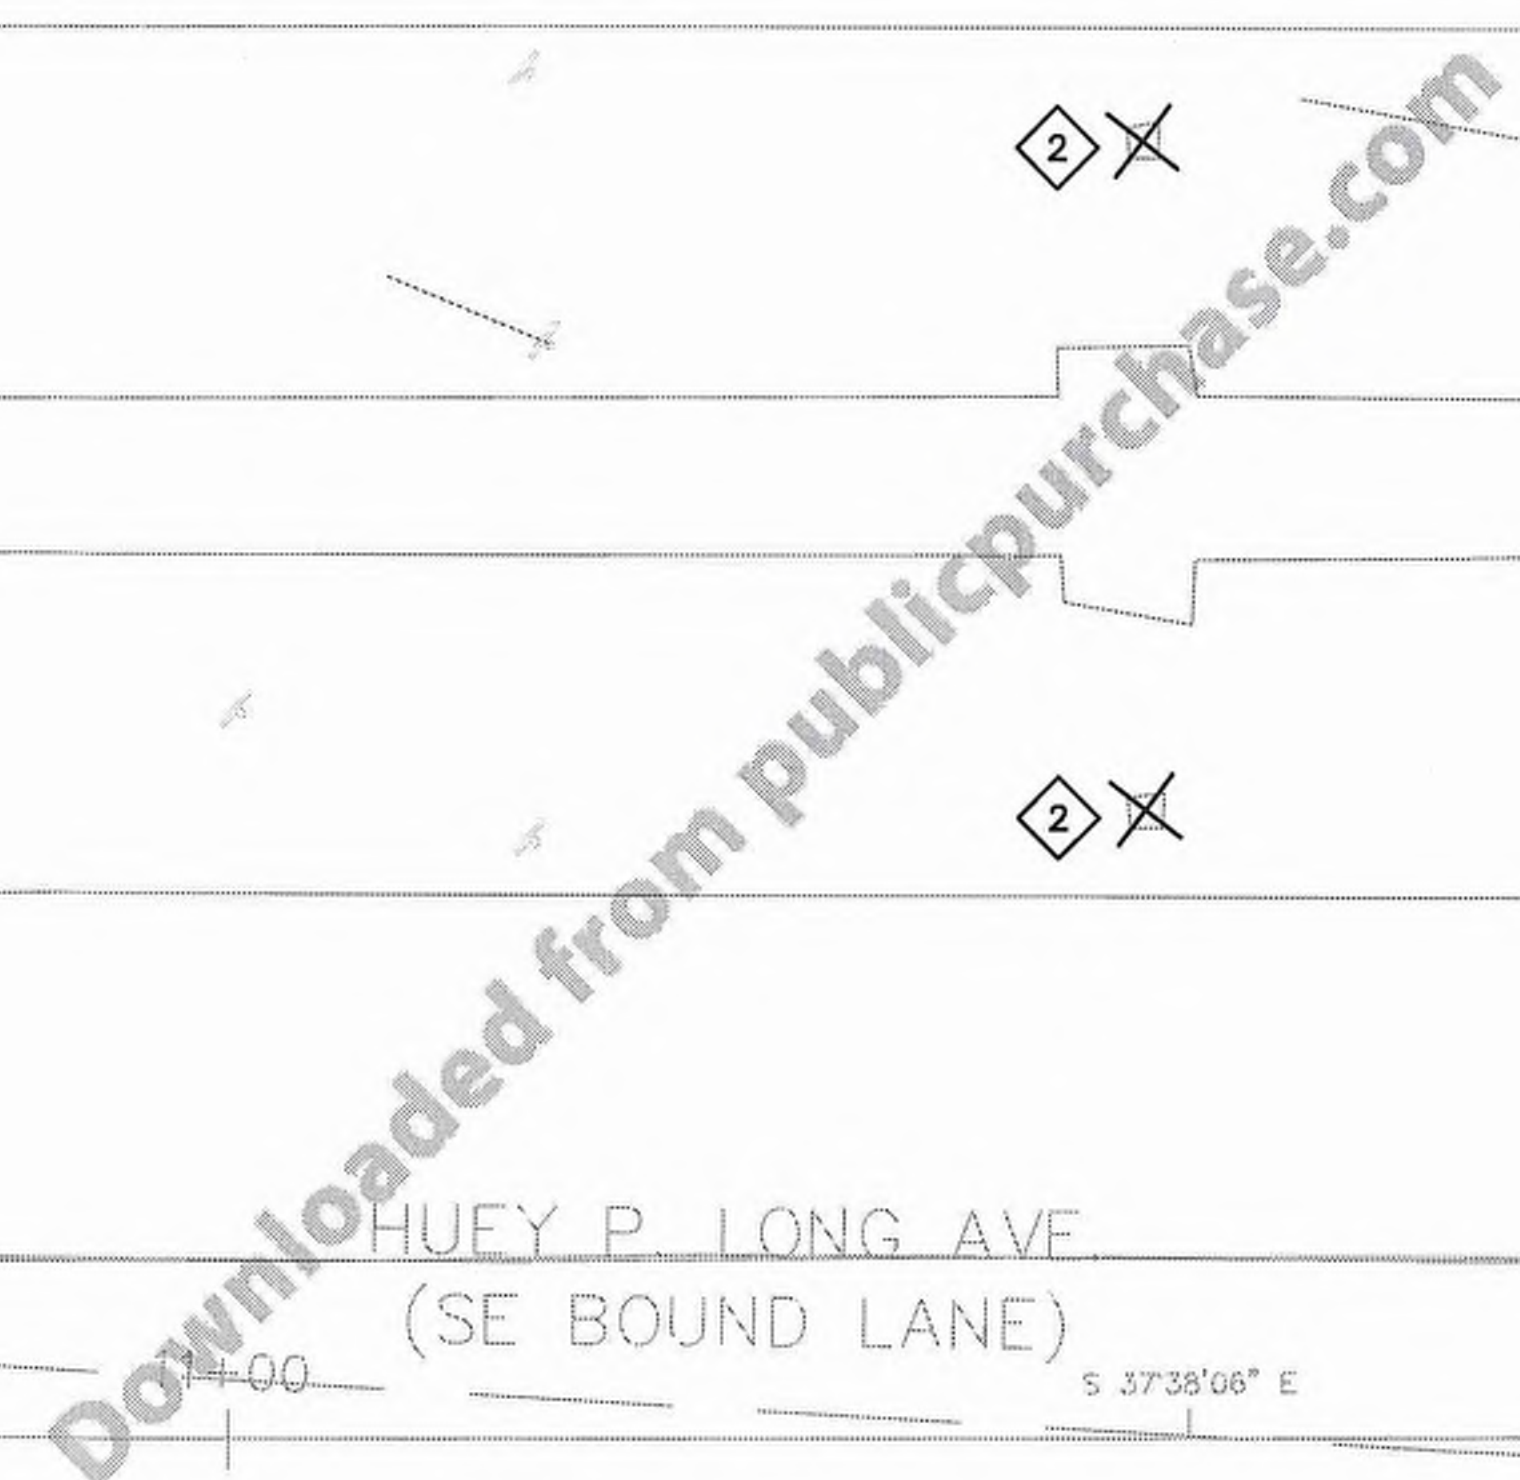

Please go to publicpurchase.com to make sure you have the latest information and any addendums released

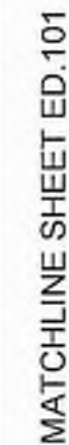

ED.102 | ED.102

- 1 CONTRACTOR TO COORDINATE THE REMOVAL OF LUMINAIRES FACING MEMORIAL PARK WITH ENTERGY. LUMINAIRES NOT FACING MEMORIAL PARK ARE TO REMAIN.
- 2 EXISTING LIGHTING TO BE CAREFULLY REMOVED AND TURNED OVER TO OWNER. REMOVE CONDUCTORS AND RACEWAY BACK TO SOURCE.

seal

DANA BROWN & ASSOCIATES, INC.
NEW ORLEANS - 504-345-2639
www.danabrownassociates.com

740 2nd Street
Gretna, Louisiana 70053

- PROTECT ALL EXISTING TREES ON SITE DURING CONSTRUCTION

AS BUILT
Friedman Electric Co., Inc.
by *[Signature]*
date *10/15/00*

SHEET NO.
ED.102



BKI BURK-KLEINPETER, INC.
ENGINEERS, ARCHITECTS, PLANNERS, ENVIRONMENTAL SCIENTISTS
4176 CANAL STREET, NEW ORLEANS, LA 70119-5994
PHONE (504)486-5901 • FAX (504)488-1714

Please go to publicpurchase.com to make sure you have the latest information and any addendums released